

1.12.98  
1.3.99  
3.5.99  
1.9.99

# S.S. No 3 MIDSHIP SECTION

S.S. 185'-0" x 29'-0" x 14'-0" Mld

Raised Quarterdeck 4'-0"

30 Class 100 Al Sloyds

Scale 1/2"

## Sloyds' Numerals

1/2 Breadth 14.5 14.5 ✓

1/2 Length 26.83 26.0 ✓

Depth 14.54 14.583 ✓

1st numeral 55.87 55.083 ✓

Length 184.16 183.83

2nd numeral 10289.0128 87

Equipment number 11239

12.64  
D = 12.60 B = 6.34

Butts of side margin plates double riveted  
--- of centre girder overlapped & double riveted  
Butts of deck stringer plates strapped  
treble riveted for 1/2 length  
and double riveted at ends.  
Tank top plating edges single riveted  
Butts double riveted in E & B space  
Sheerstrake butts remaining single  
and treble riveted for 1/2 len.  
All outside strakes for 1/2 len. have  
butts overlapped and treble riveted.  
All other shell butt double lapped  
treble riveted where over R & B  
& double riveted all for 1/2 len.  
all deck plate butts overlapped  
and double riveted with the exception of  
the butts beyond the 1/2 len. which are  
single riveted

## Equipment

collective wt:

3 bow anchors 38 1/2 cwt ✓ ex stock

1 Streamer --- 14 3/4 --- ---

1 Kedge --- 2 1/2 --- ---

210 fathoms of 1 1/16 stud chain cable



60 --- of 3" steel wire

75 --- of 8 1/2" Pump Kowline

90 --- of 6 1/2" Lawner.

90 --- of 4" ---

all parts of double bottom in boiler  
space increased 1/20 beyond table S.7.

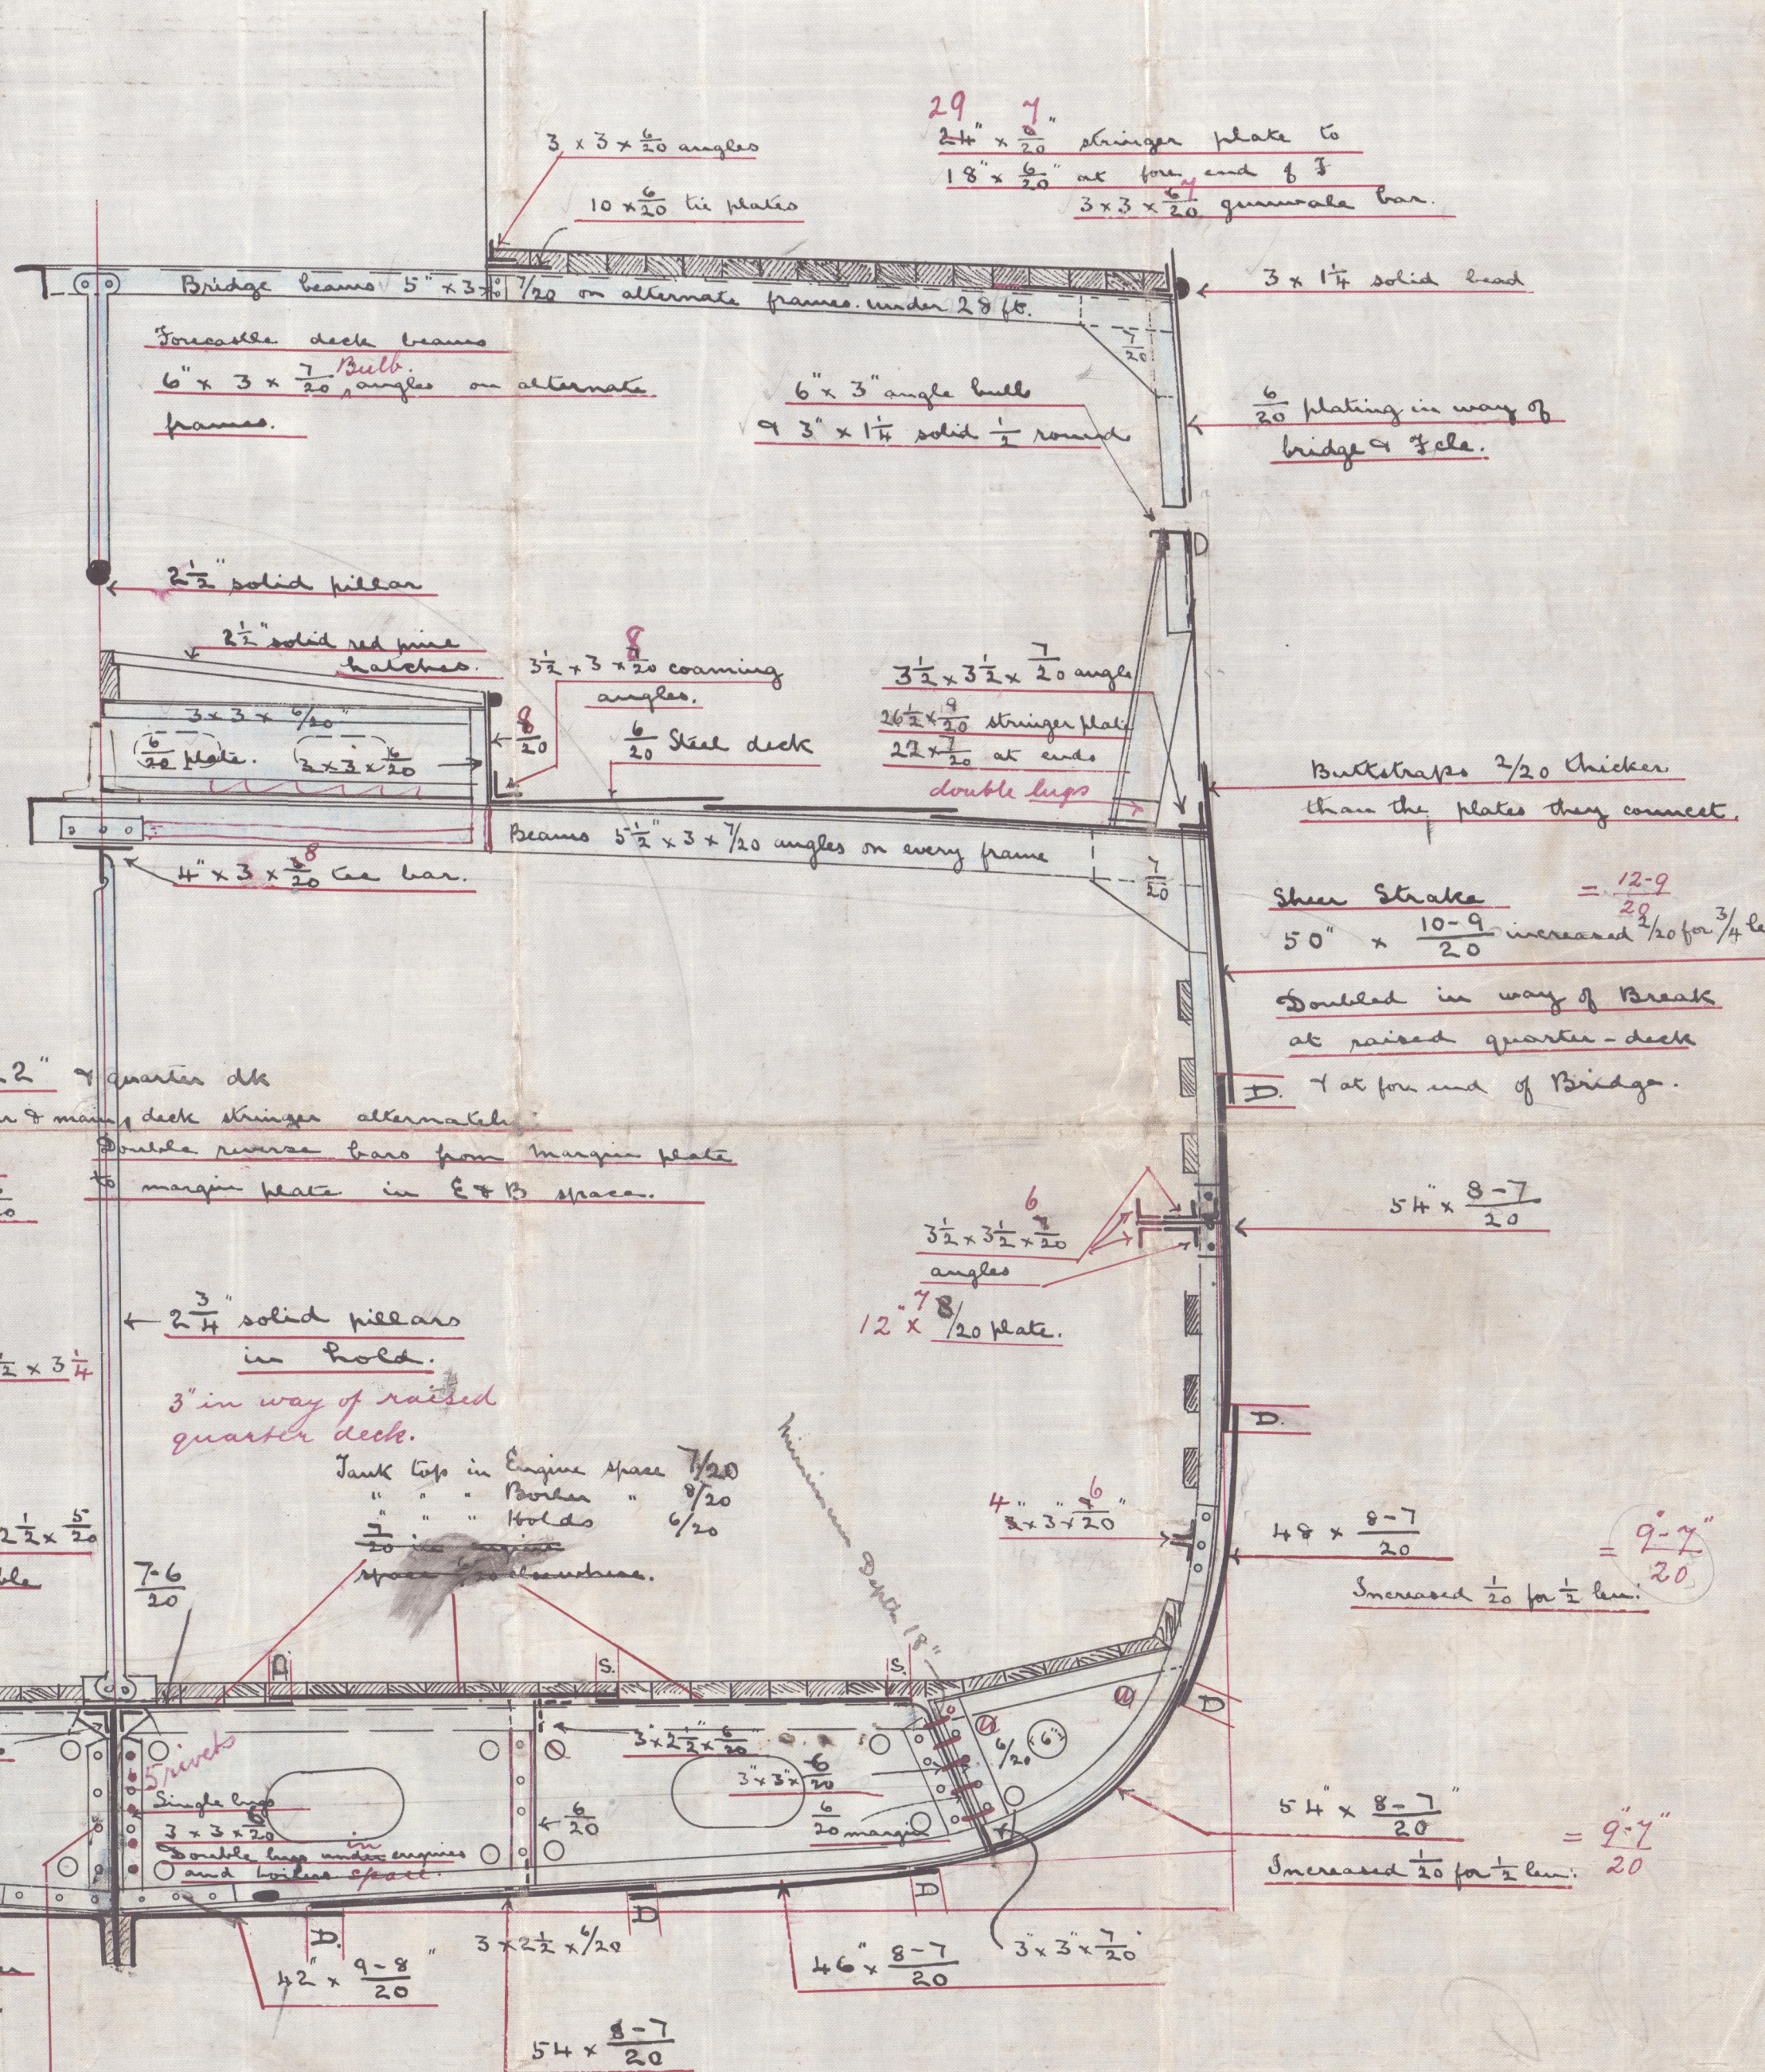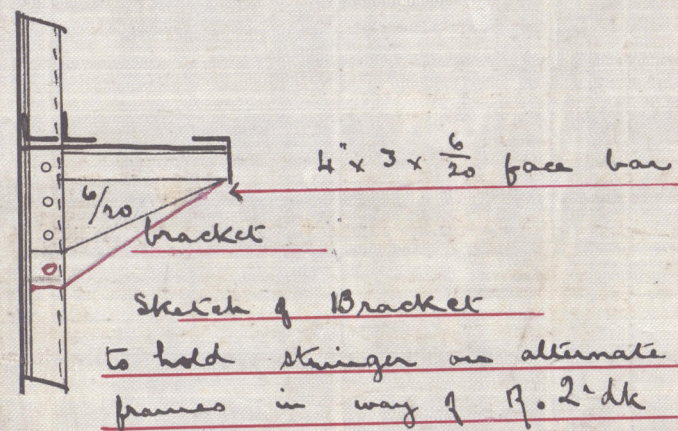




Midship Section  
 Taylor & Mitchell W<sup>3</sup>

S. S. Fresham

Grk Rm No 12 582

GRK350-0058

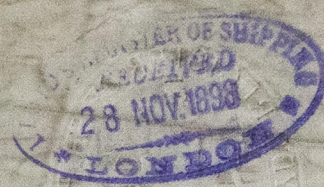

14.2  
 20.83  
 14.24  
 22.87  
 184.16  
 21.481  
 210.88501

115311

15.51



© 2020  
 Lloyd's Register  
 Foundation