

Plan of Inner Bottom  
in Boiler Space  
Taylor & Mitchell No. 3


1/2/51  
J. H. V.

1/1/51  
J. H. V.

S.S. Gresham


GRK350-0059

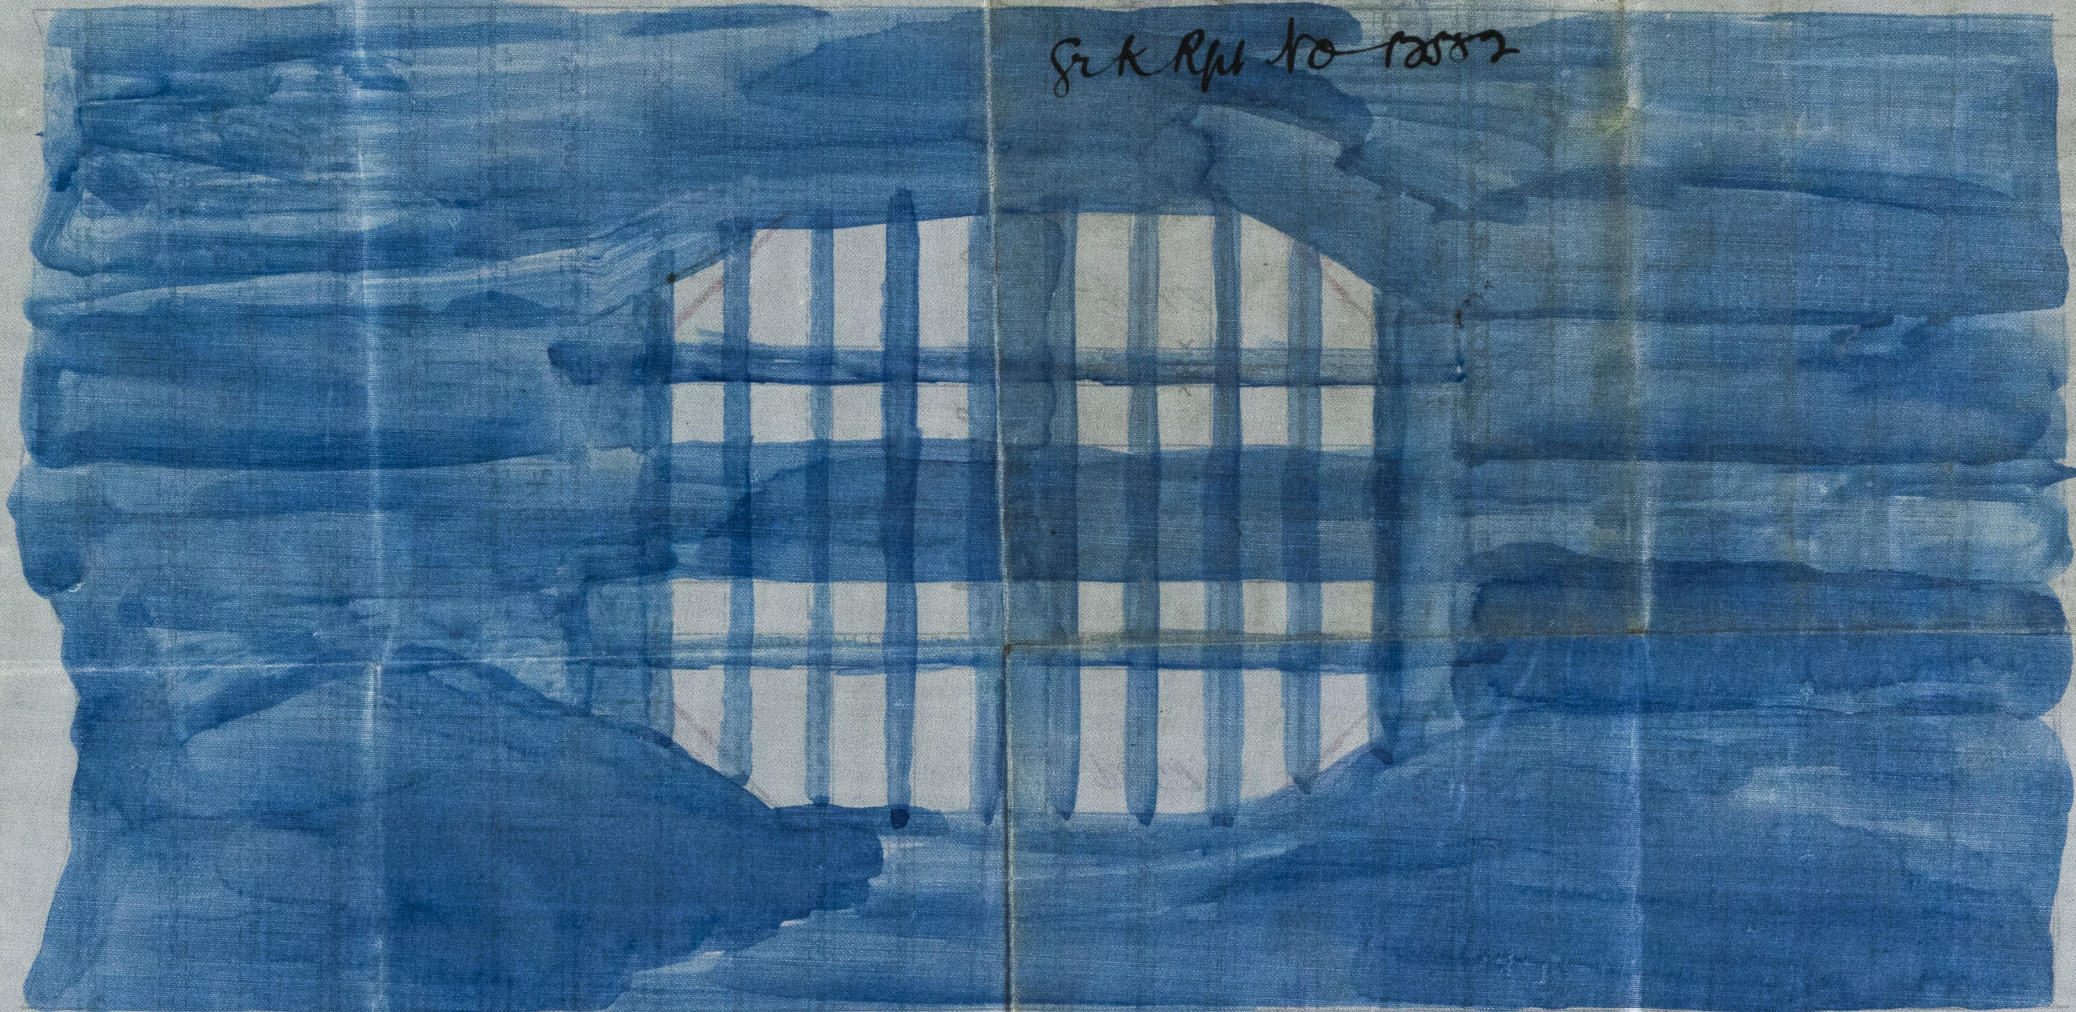

pp. 2-22

... ..

... ..



Lloyd's Register  
Foundation





23.5.99


S. S. N° 3

Plan of Inner Bottom in Boiler Space

Scale  $\frac{1}{4}$ "

Lauk top Iron.

margin plate & carried all fore & aft.

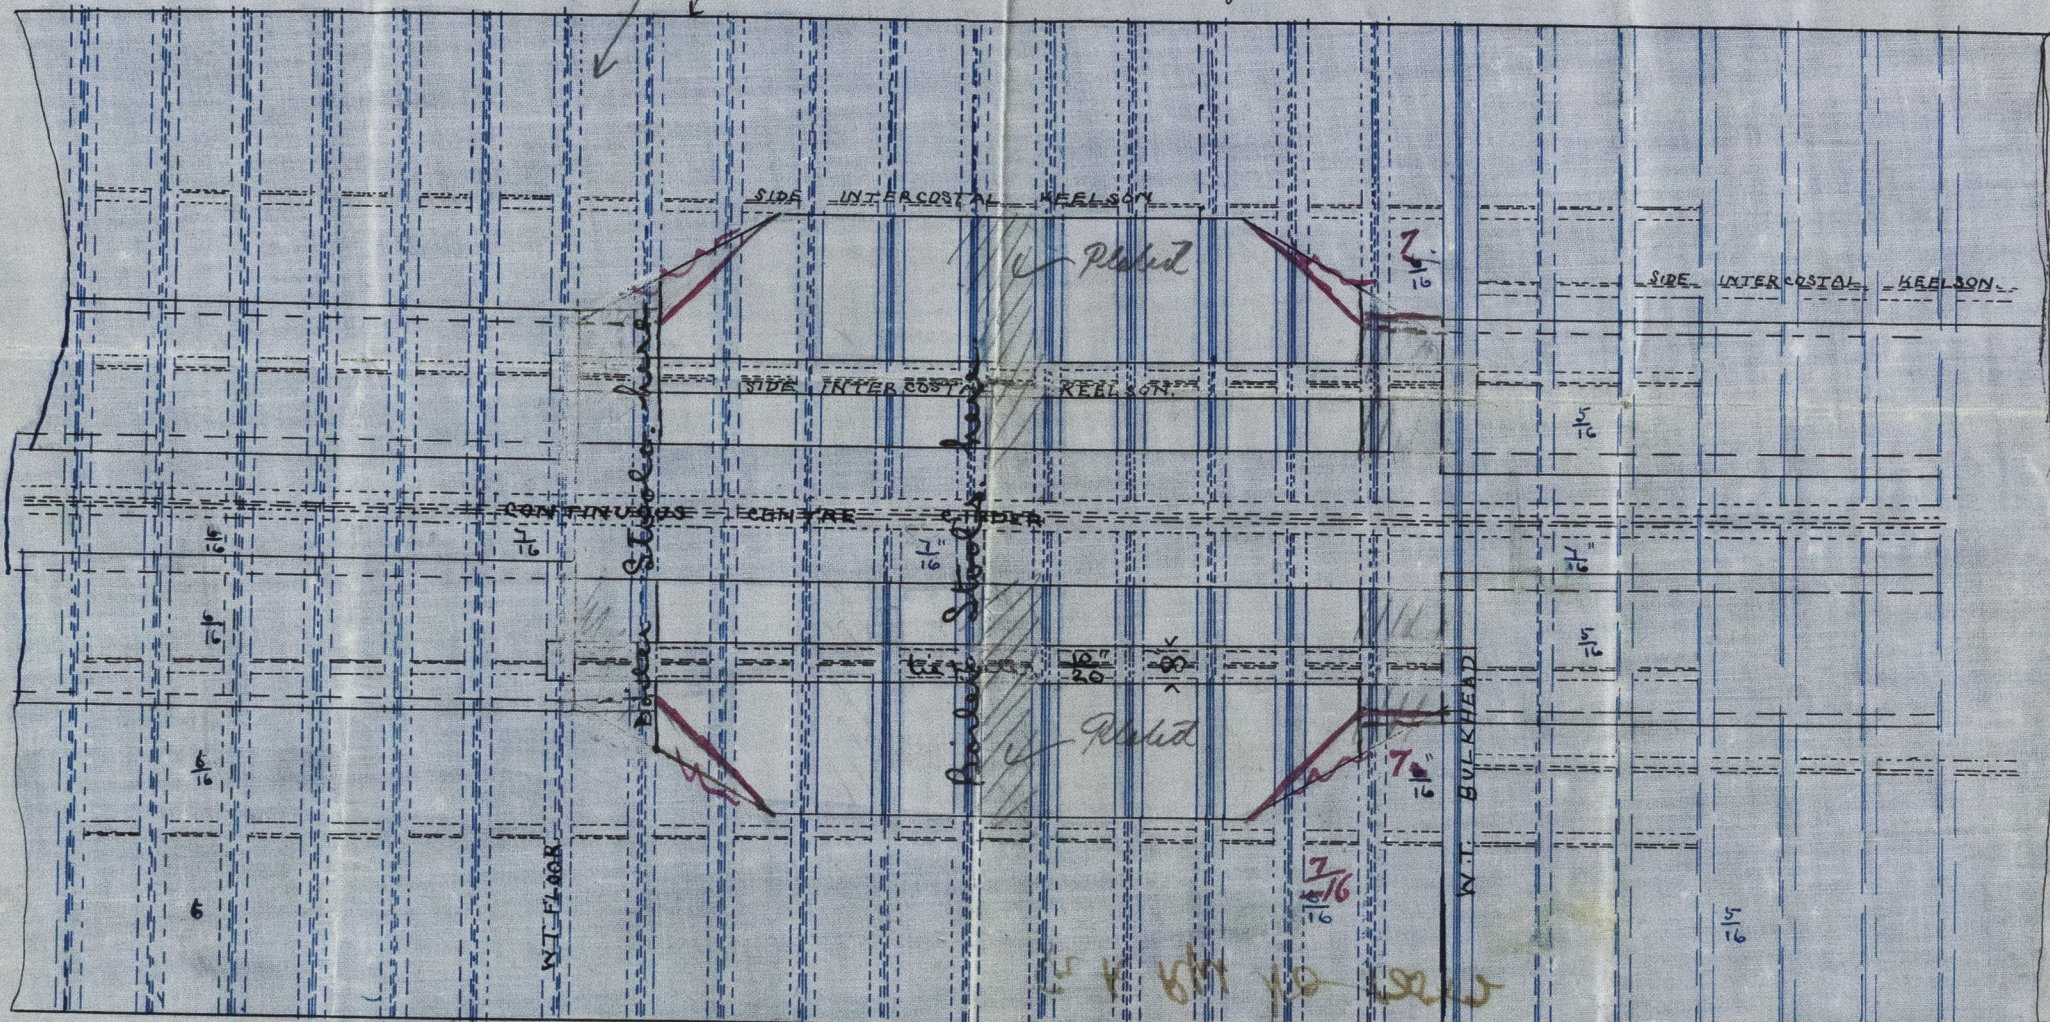

38 40 42 44 46 48 50 52 54 56 58 60  
Water Ballast — X — no double bottom for Water Ballast but cellular system carried thru. — X — Water Ballast.

2019  
22/5/99  
J.D.L.  
Greenock  
19/5/99  
Foundation