

J. S. Fresham

Received at

Greenock

Office.

31-10-99

Lloyd's Register of British and Foreign Shipping.

(Report on Vessel No. 12582 Port Grk)

No. 7073 SHIP FORGINGS OR CASTINGS.

I have to report that the undermentioned Iron or Steel Forgings or Castings,
 manufactured by Mess Robt Kerr & Sons
 of Irvine for the Vessel No. 3, being built
 by Mess Taylor & Mitchell of Greenock
 have been inspected by me as set forth below, and found to be, so far as can be seen,
 Sound & efficient

Mark on Forgings.

Lloyd's


No. 7073

WH

William Hamilton
 Glasgow

	STERN FRAME.	RUDDER FRAME.	STEM.
Material* ...		Scrap iron	
How made ...		Forged	
Dimensions ...		4½ to 13½ x 3	
Progress on Inspection		Forging & smithing	
Date when Inspected		7 to 26/10/99	

SKETCHES OF FRAMES SHOWING POSITION AND DESCRIPTION OF WELDS OF FORGINGS, OR PARTICULARS OF TESTS APPLIED TO CASTINGS.

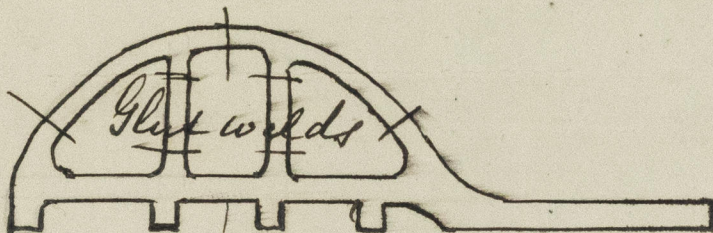

Fee (if any chargeable) £ : :

To be paid at

Yorquips
Laura Fritchett
K.E. 3.



© 2019

Lloyd's Register
Foundation