

ss. *Greenham*
For the information of Surveyors and the Committee only.

Received at *Greenock* Office, *11-7* 189*9*

Lloyd's Register of British and Foreign Shipping.

(Report on Vessel No. *11582* Port *JK*)

No. *4013* SHIP FORGINGS ~~OR CASTINGS.~~

I have to report that the undermentioned Iron ~~or Steel~~ Forgings ~~or Castings~~,
manufactured by *Mess Robt Kerr & Sons*
of *Glasgow* for the Vessel No. *3*, being built
by *Mess Taylor & Mitchell* of *Greenock*
have been inspected by me as set forth below, and found to be, so far as can be seen,
Sound & efficient


Mark on Forgings.

Lloyd's
No. *4013*
W. H.

William Hamilton
Glasgow

	STERN FRAME.	RUDDER FRAME.	STEM.
Material* ...	<i>Scrap iron</i>		<i>Scrap iron</i>
How made ...	<i>Forged</i>		<i>Forged</i>
Dimensions ...	<i>6 3/4 H. 4 1/4</i>		<i>7 1/2 H. 2</i>
Progress on Inspection	<i>Forging & smithing</i>		<i>Forging</i>
Date when Inspected	<i>30/3/99 to 3/7/99</i>		<i>30/6/99</i>

SKETCHES OF FRAMES SHOWING POSITION AND DESCRIPTION OF WELDS OF FORGINGS, OR PARTICULARS OF TESTS APPLIED TO CASTINGS.

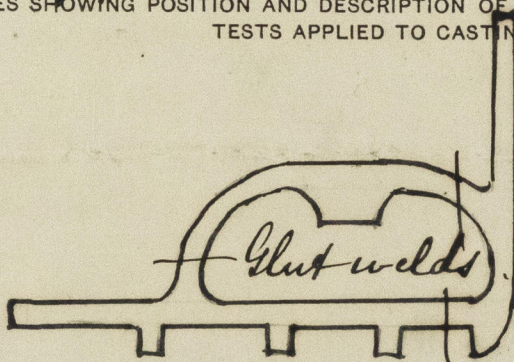

Fee (if any chargeable) £ : :

To be paid at



© 2019

Lloyd's Register
Foundation