



1. 12. 98
1. 3. 99
3. 5. 99
1. 9. 99

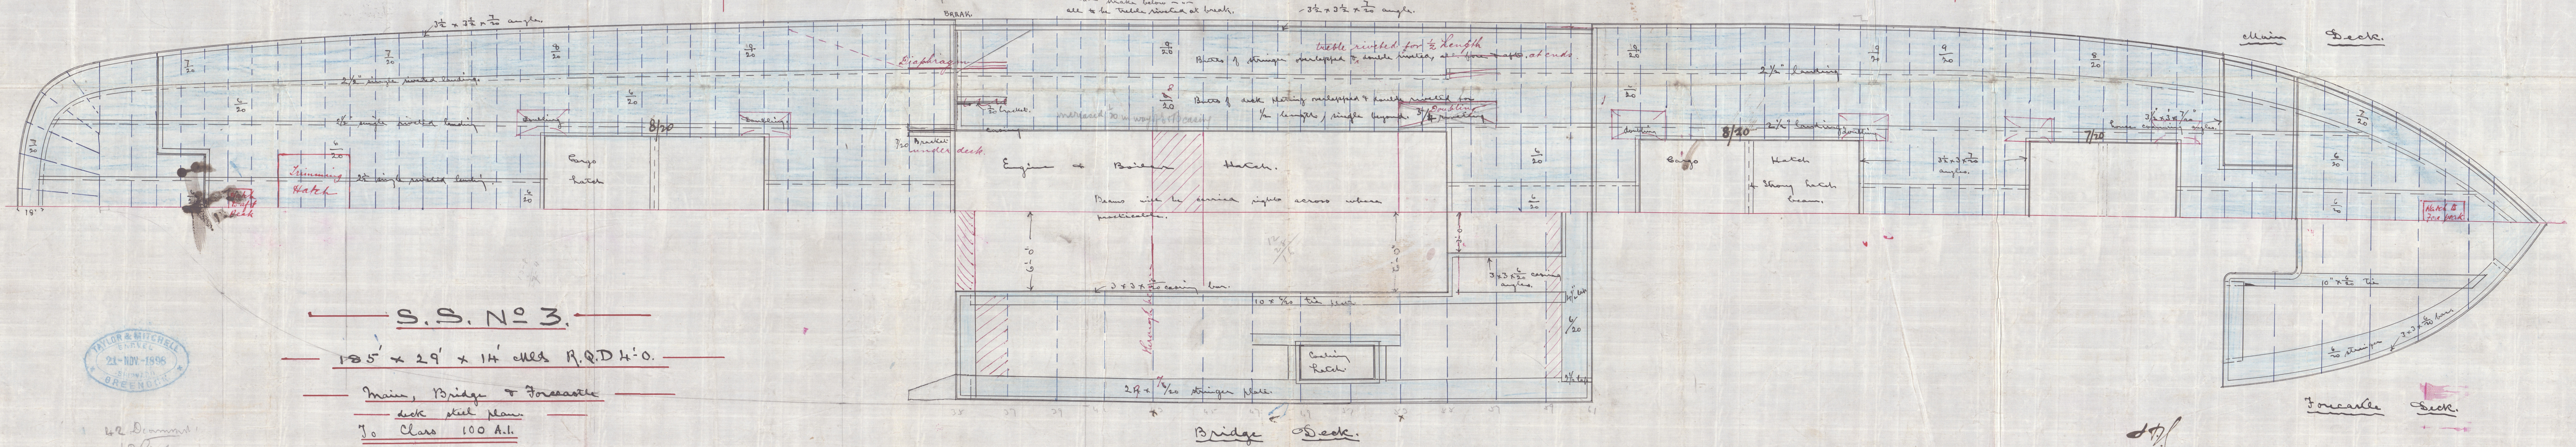

S.S. No. 3.
185' x 29' x 14' mld R.Q.D.H.O.
Main, Bridge & Forecastle
deck steel plan
To Class 100 A.I.

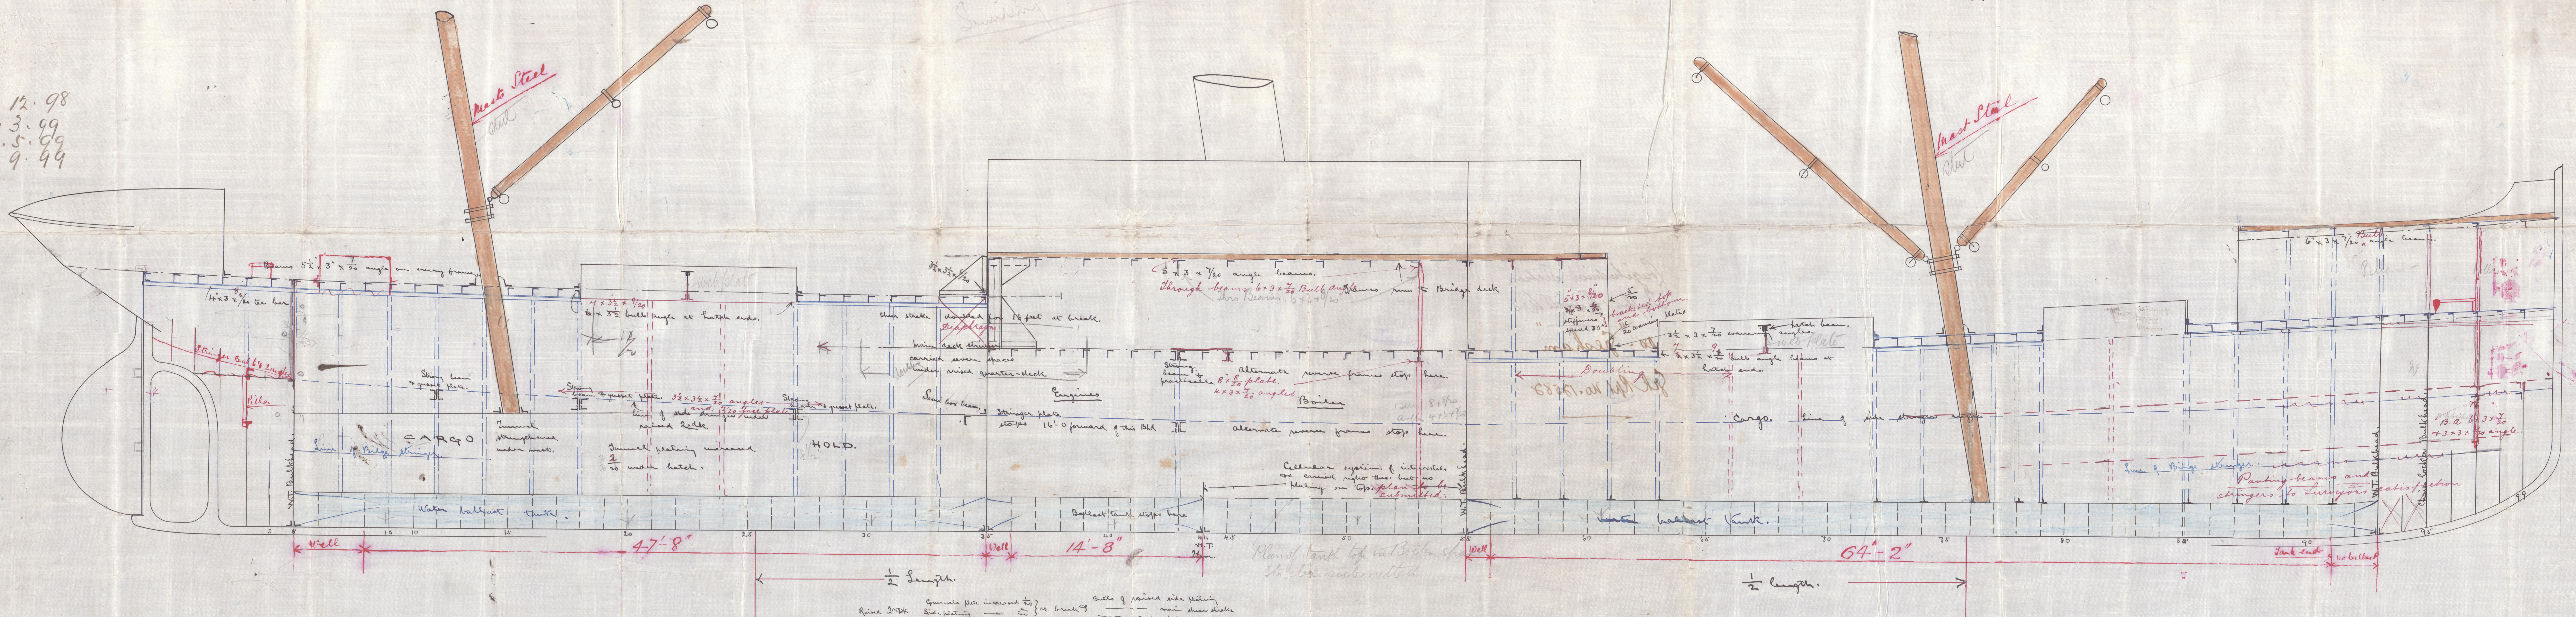

42 Decimals
12 Bars


11/10/98

Longitudinal Section
Taylor & Mitchell No. 3

10. Gresham

Grk Rpt No. 12582

GRK350-0062

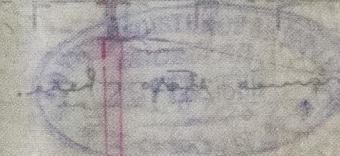

© 2020

Lloyd's Register
Foundation