

28.9.1
29

DECK
BREAK OF

BRIDGE DECK
BREAK OF

DECK
DOUBTING IN WAY OF BREAK

BREAK OF BRIDGE
DOUBTING IN WAY OF


DOUBLE BRIDGE AS BREAK

SINGLE BRIDGE AS BREAK


DOUBLE BRIDGE AS BREAK

SINGLE BRIDGE AS BREAK



BRIDGE TO YAW IN INITIAL
 $2.2 \div 1.1 = 2$
 $2000 \div 1.1 = 1818$

Plating in way of Bridge
 Taylor & Mitchell No 3

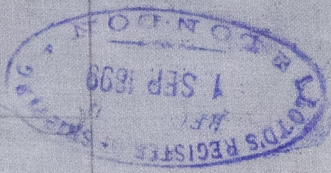

ss. Gresham
 Sth Rpt No 12582

GRK350-0063




© 2019

Lloyd's Register
 Foundation




1.9.99

*over on 1.9.99
made 1.9.99
1.9.99
1.9.99*

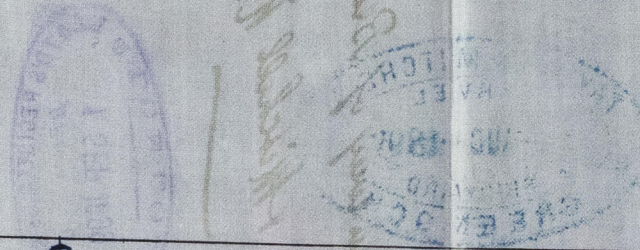


PLATING IN WAY OF BRIDGE
S. S. N^o 3
SCALE $\frac{1}{4}$ " = 1 FOOT

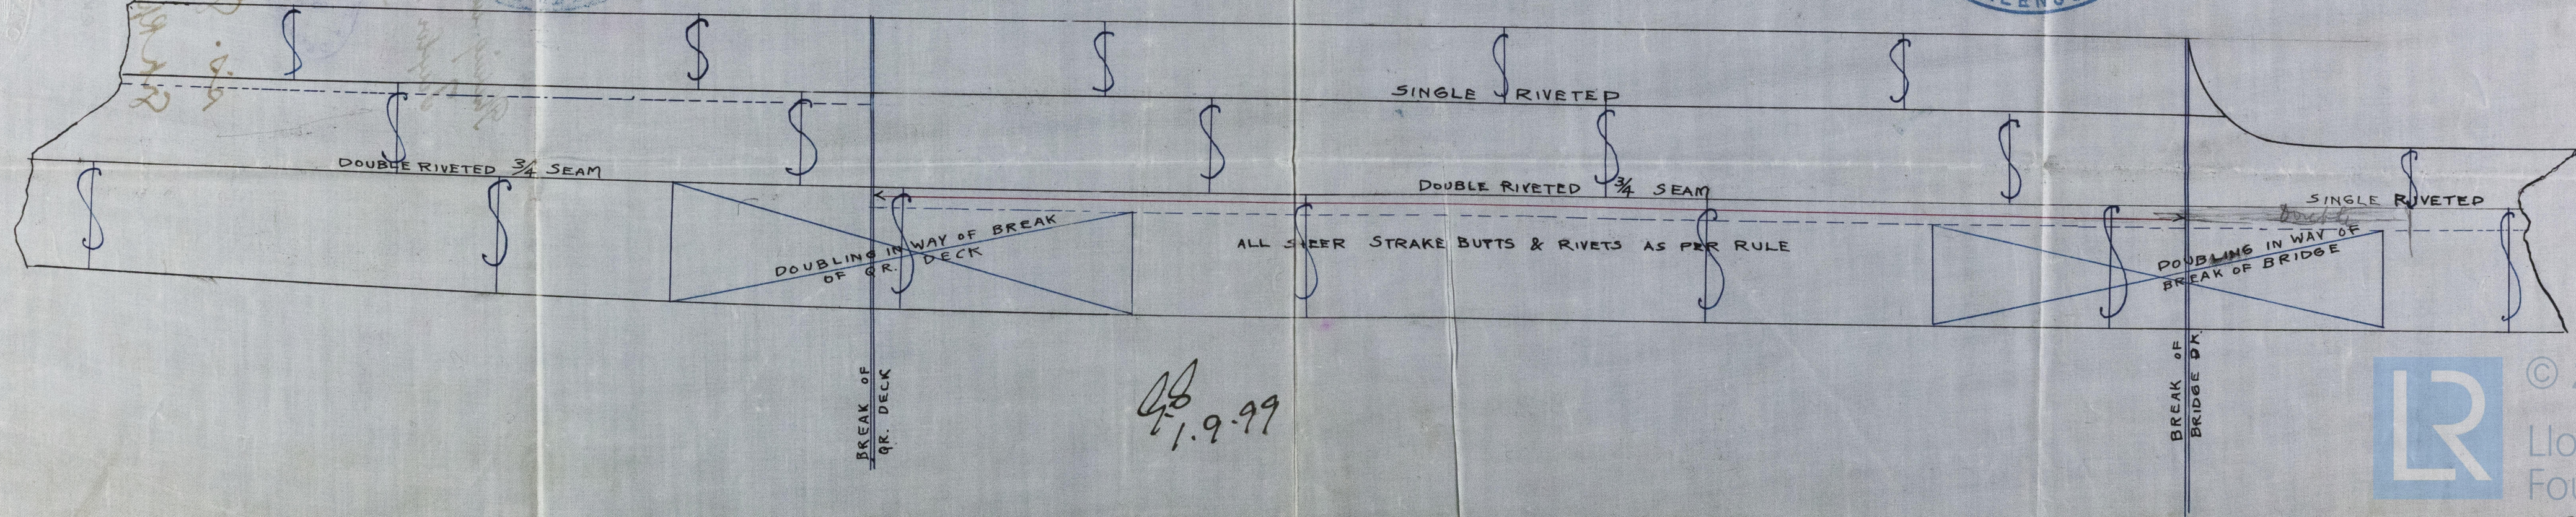

BREAK OF
BRIDGE DECK

1.9.99

BREAK OF
BRIDGE DECK

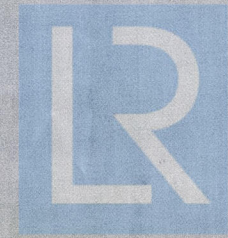

© 2019

Lloyd's Register
Foundation

GRK350-0063