

Messrs Taylor & Mitchell's no 3

Messrs Taylor & Mitchell's no 3

PAINTING
2
2 SCALE
ARRANGEMENT
2 N° 3
1/2 - 1 Ft.




2
p. 3.

ss. Green.

Soth Kphl. No 12582

053725
-0067

10/10/2011

10


© 2019

Lloyd's Register
Foundation

PANTING ARRANGEMENT

SS N° 3
SCALE $\frac{1}{4}'' = 1 \text{ Ft.}$

*Taylor & Mitchell

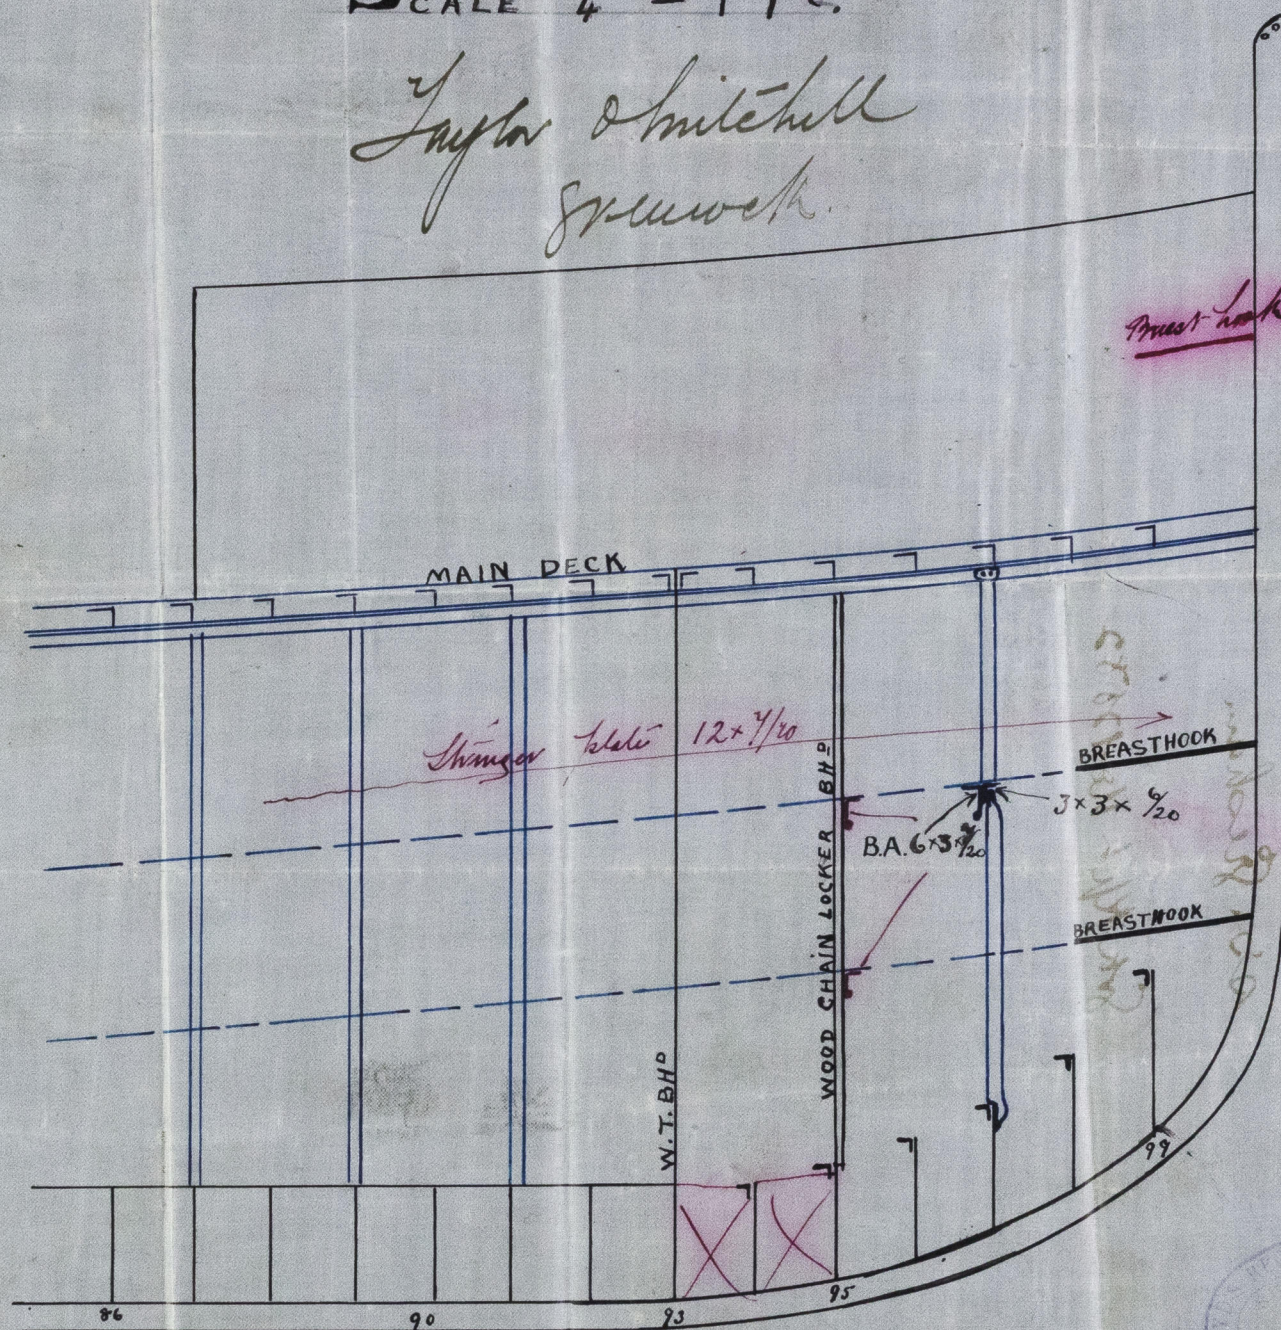

© 2019
Lloyd's Register
Foundation

GRK350-0067