


1.3.99

S.S. No 3.  
STERN POST  
SCALE  $\frac{1}{2}$ " = ONE FOOT

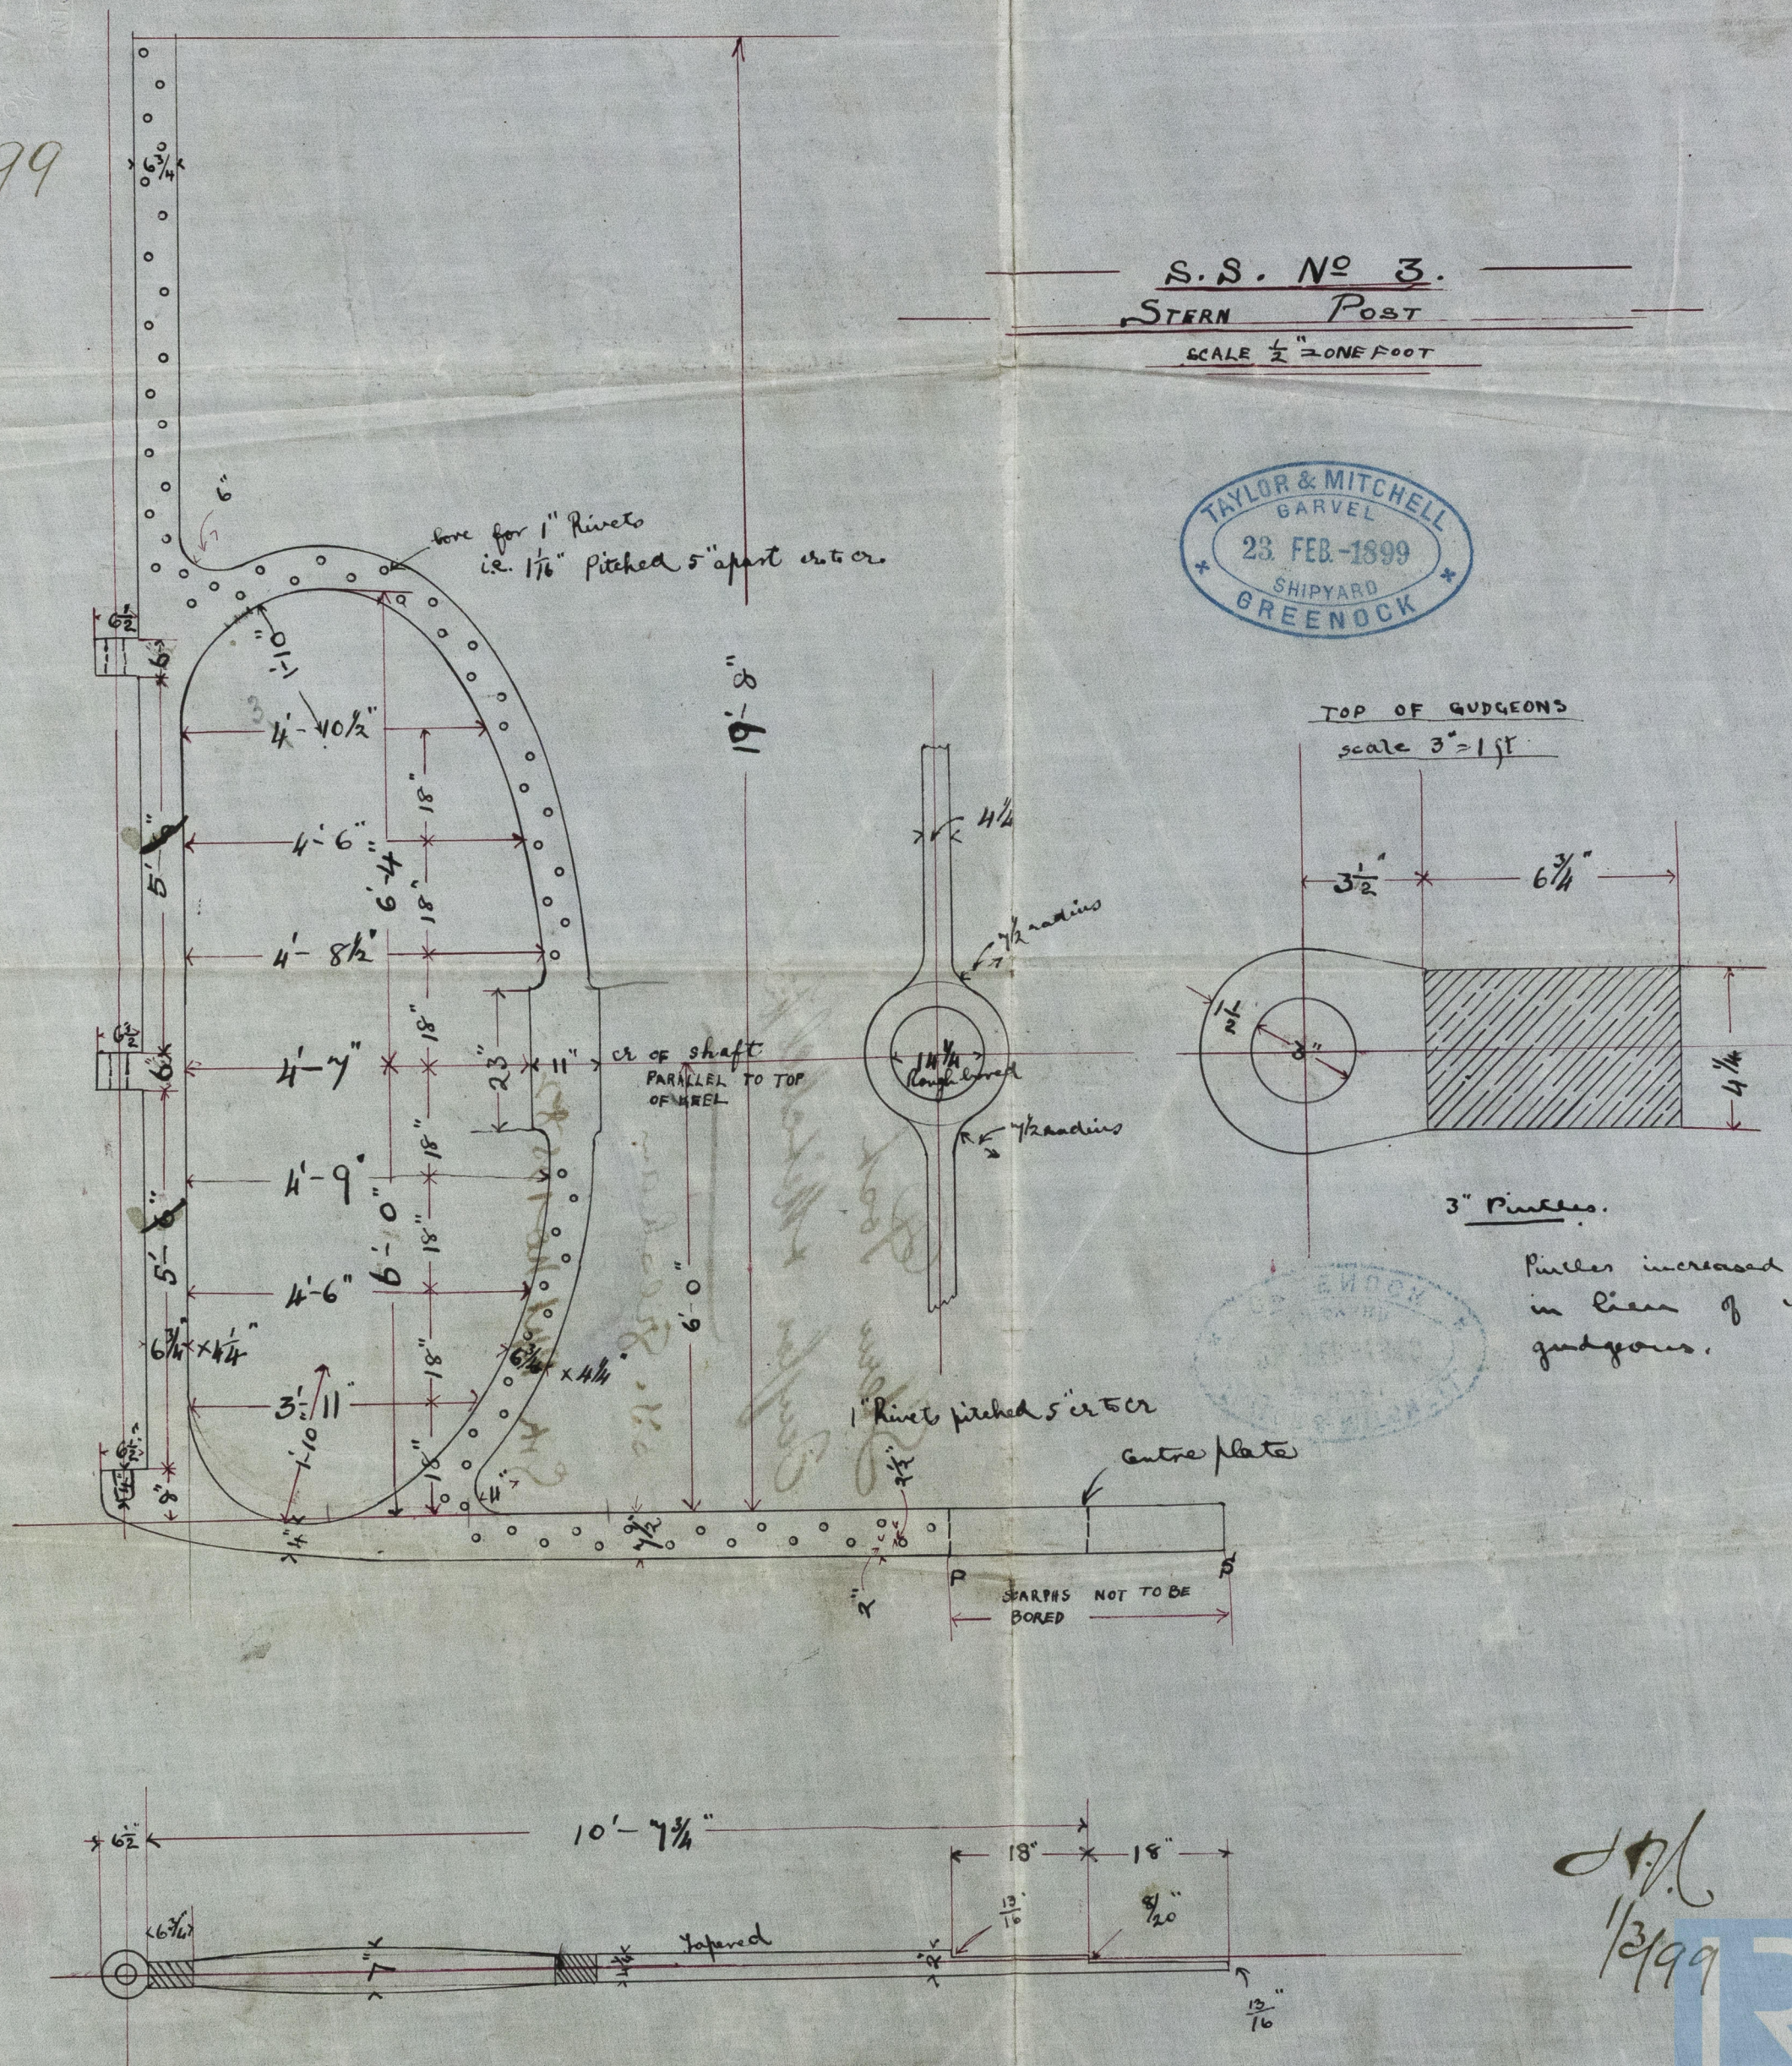

J. V. L.  
1/3/99



© 2020


Lloyd's Register  
Foundation  
GRK350-0068

GRK350-0068





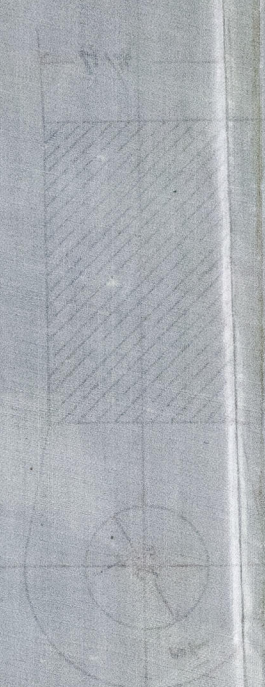

Stern Post  
Taylor & Mitchell & Co

SS. Gresham

Six Rpt no 17582

GRKBSO-0068



© 2020

Lloyd's Register  
Foundation