



16.2.99

8 1/2" Dia. Mackachlan Patent Coupled Rudder
for Mess Russell & Co's S.S. No 451/3

451 & 3

Plating 11 27254?
Is this not open deck
plating material
C.R.

Section through B

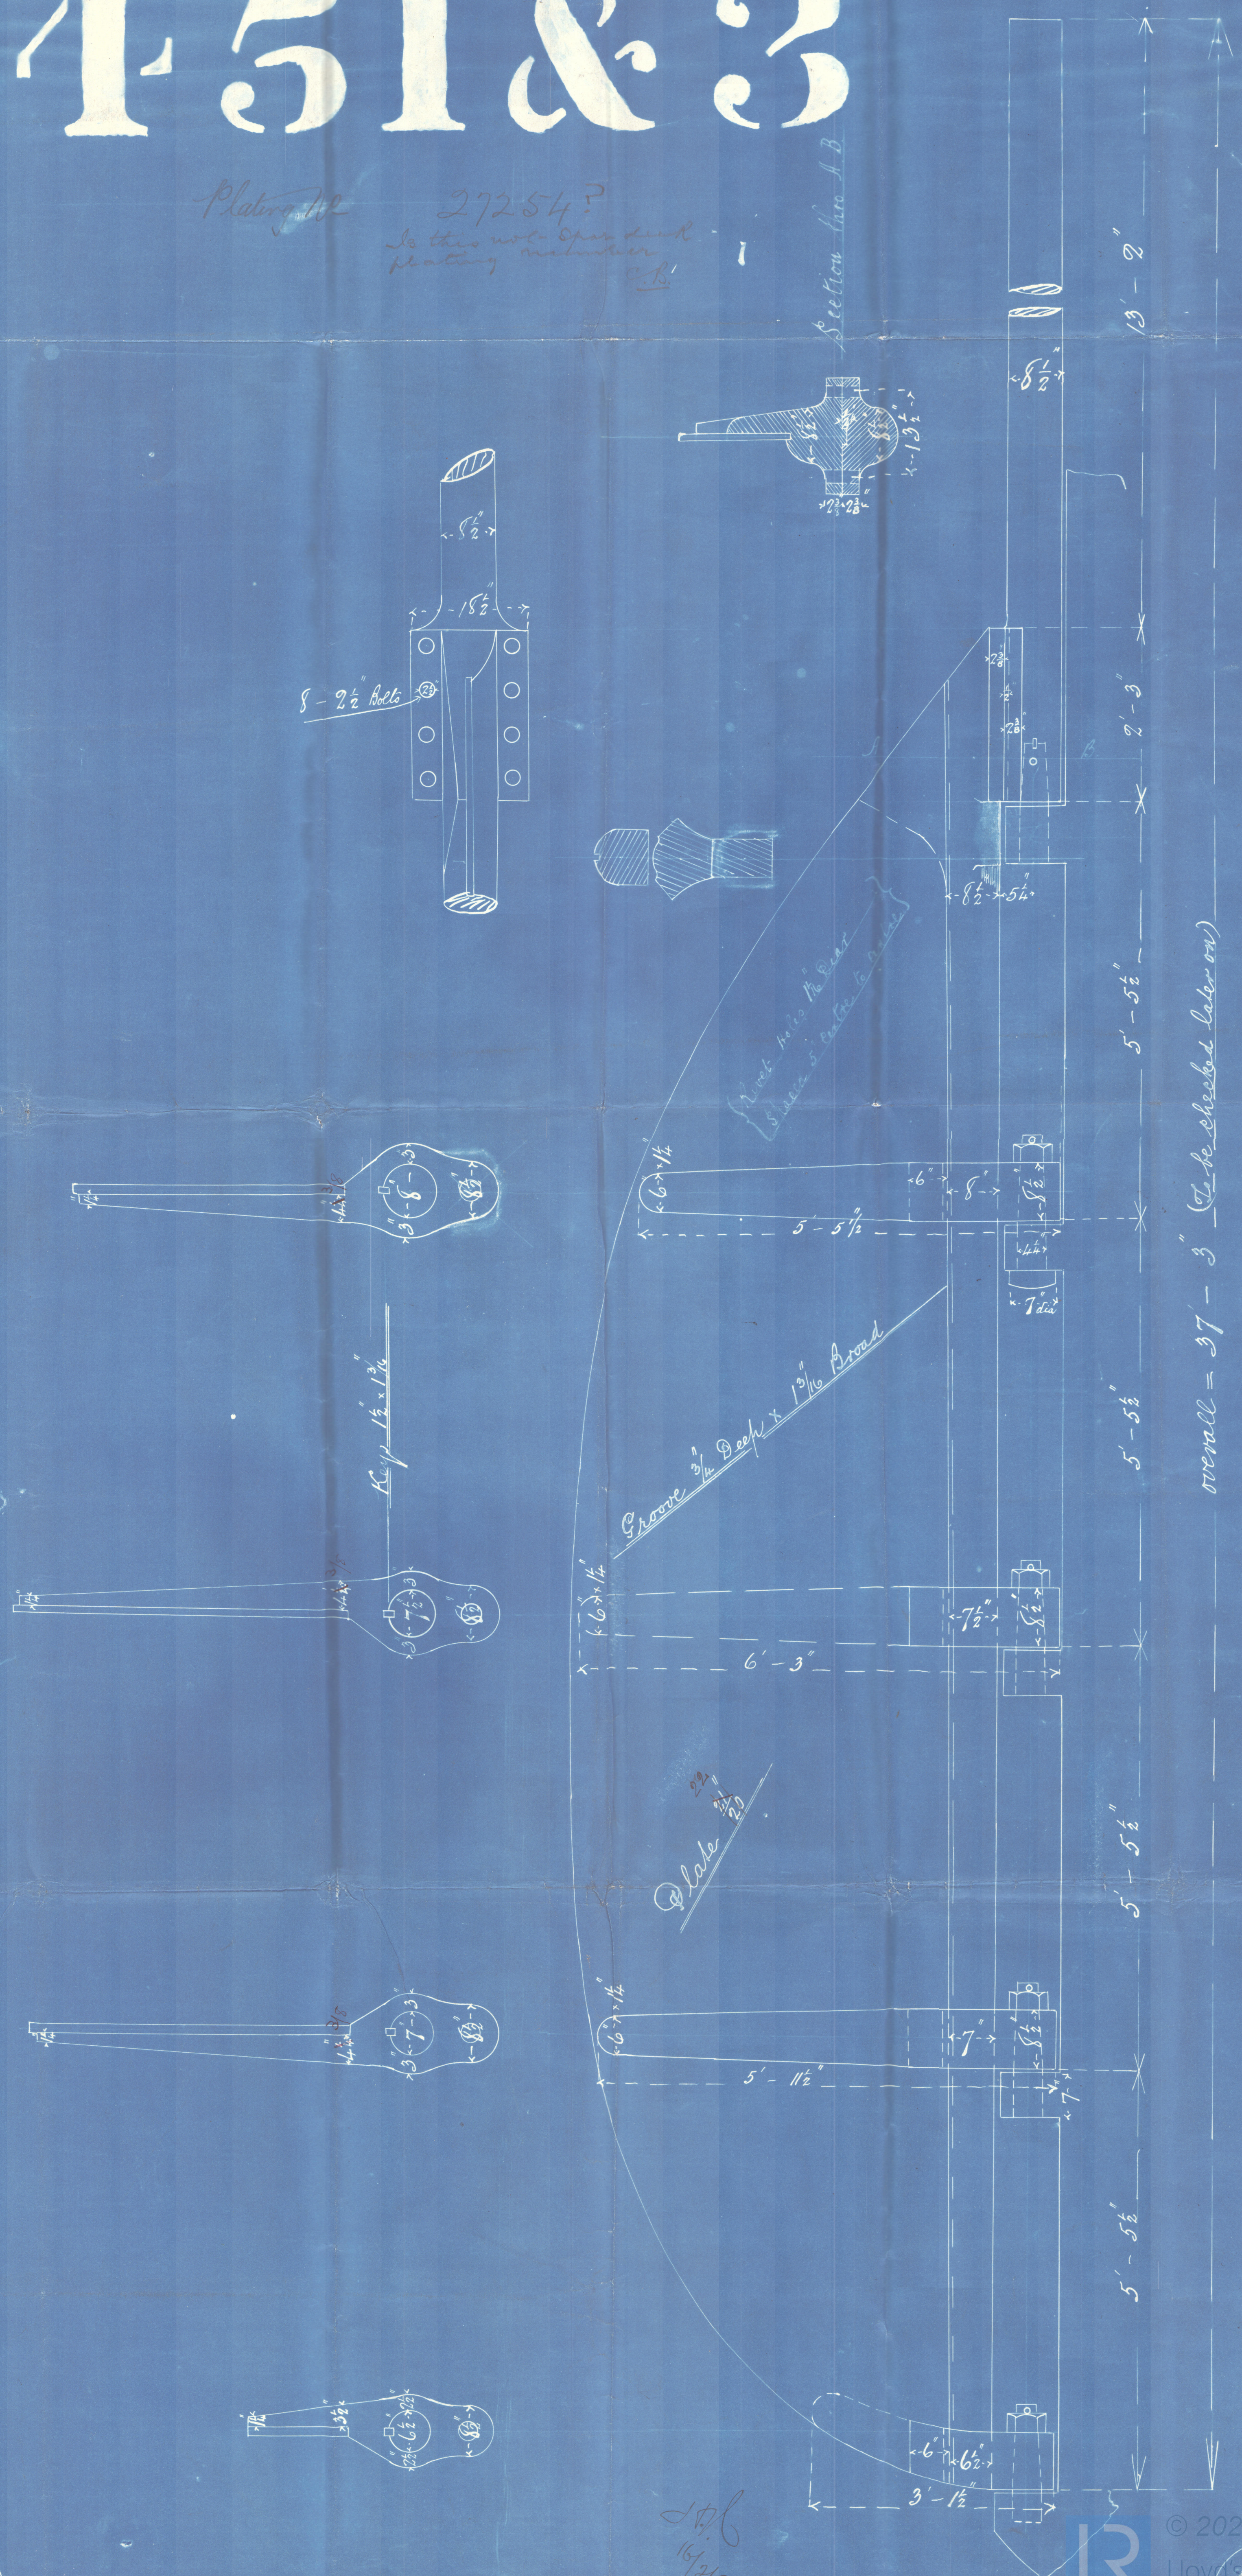

16/2/99



Plan of Rudder
Russell & Co's Nos 451 & 3

No 451. S.S. "Sirius"

GR report No 12621

No 453: S.S. "Pandora"

GR report No 12672

GRK350-0168



© 2020

Lloyd's Register
Foundation