

19.8.98


Longitudinal & Deck Plans


Scale 1/4 inch = One Foot

mm

Fore and Aft. Boats two plates in the round. Butts lapped and 1/2" above deck 2/4" below. Seams lapped and single rivetted.

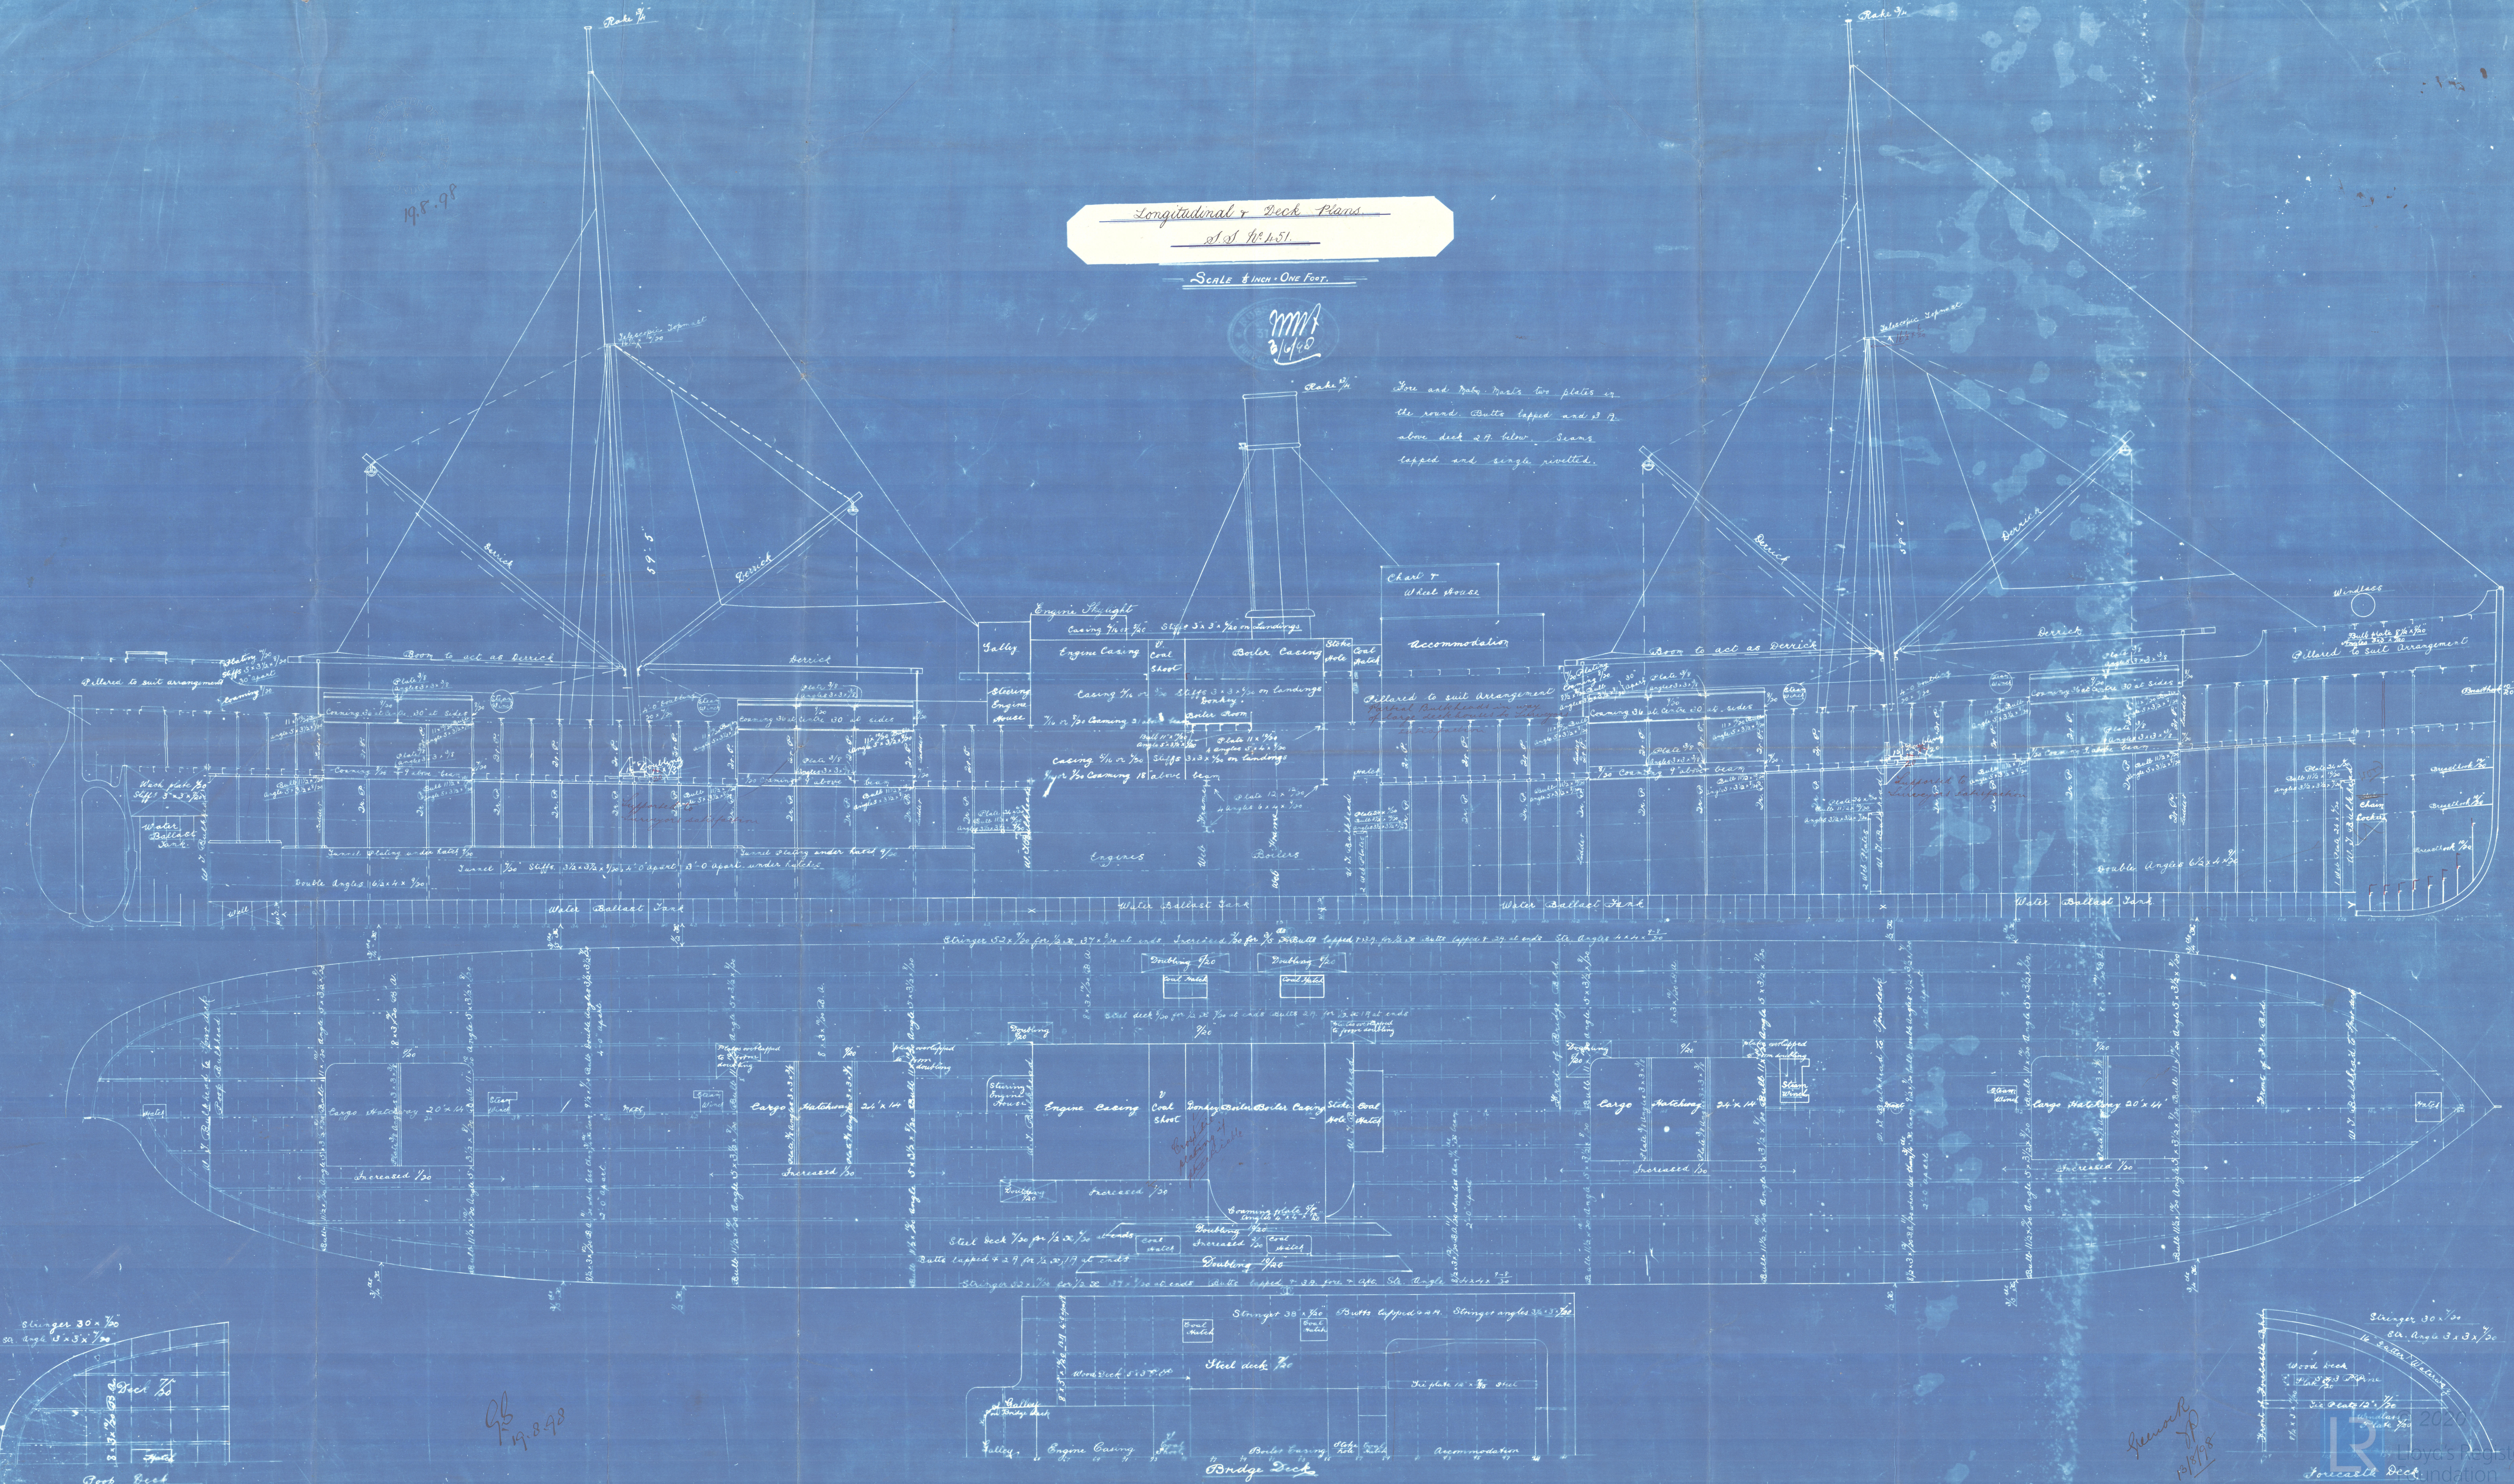

19.8.98

19.8.98

Longitudinal & Deck Plan.

Russell & Co's No 451

S.S. "Stirling"

Genl Report No 12621

also No 453.

GRK350-0169



© 2020.

Lloyd's Register
Foundation