
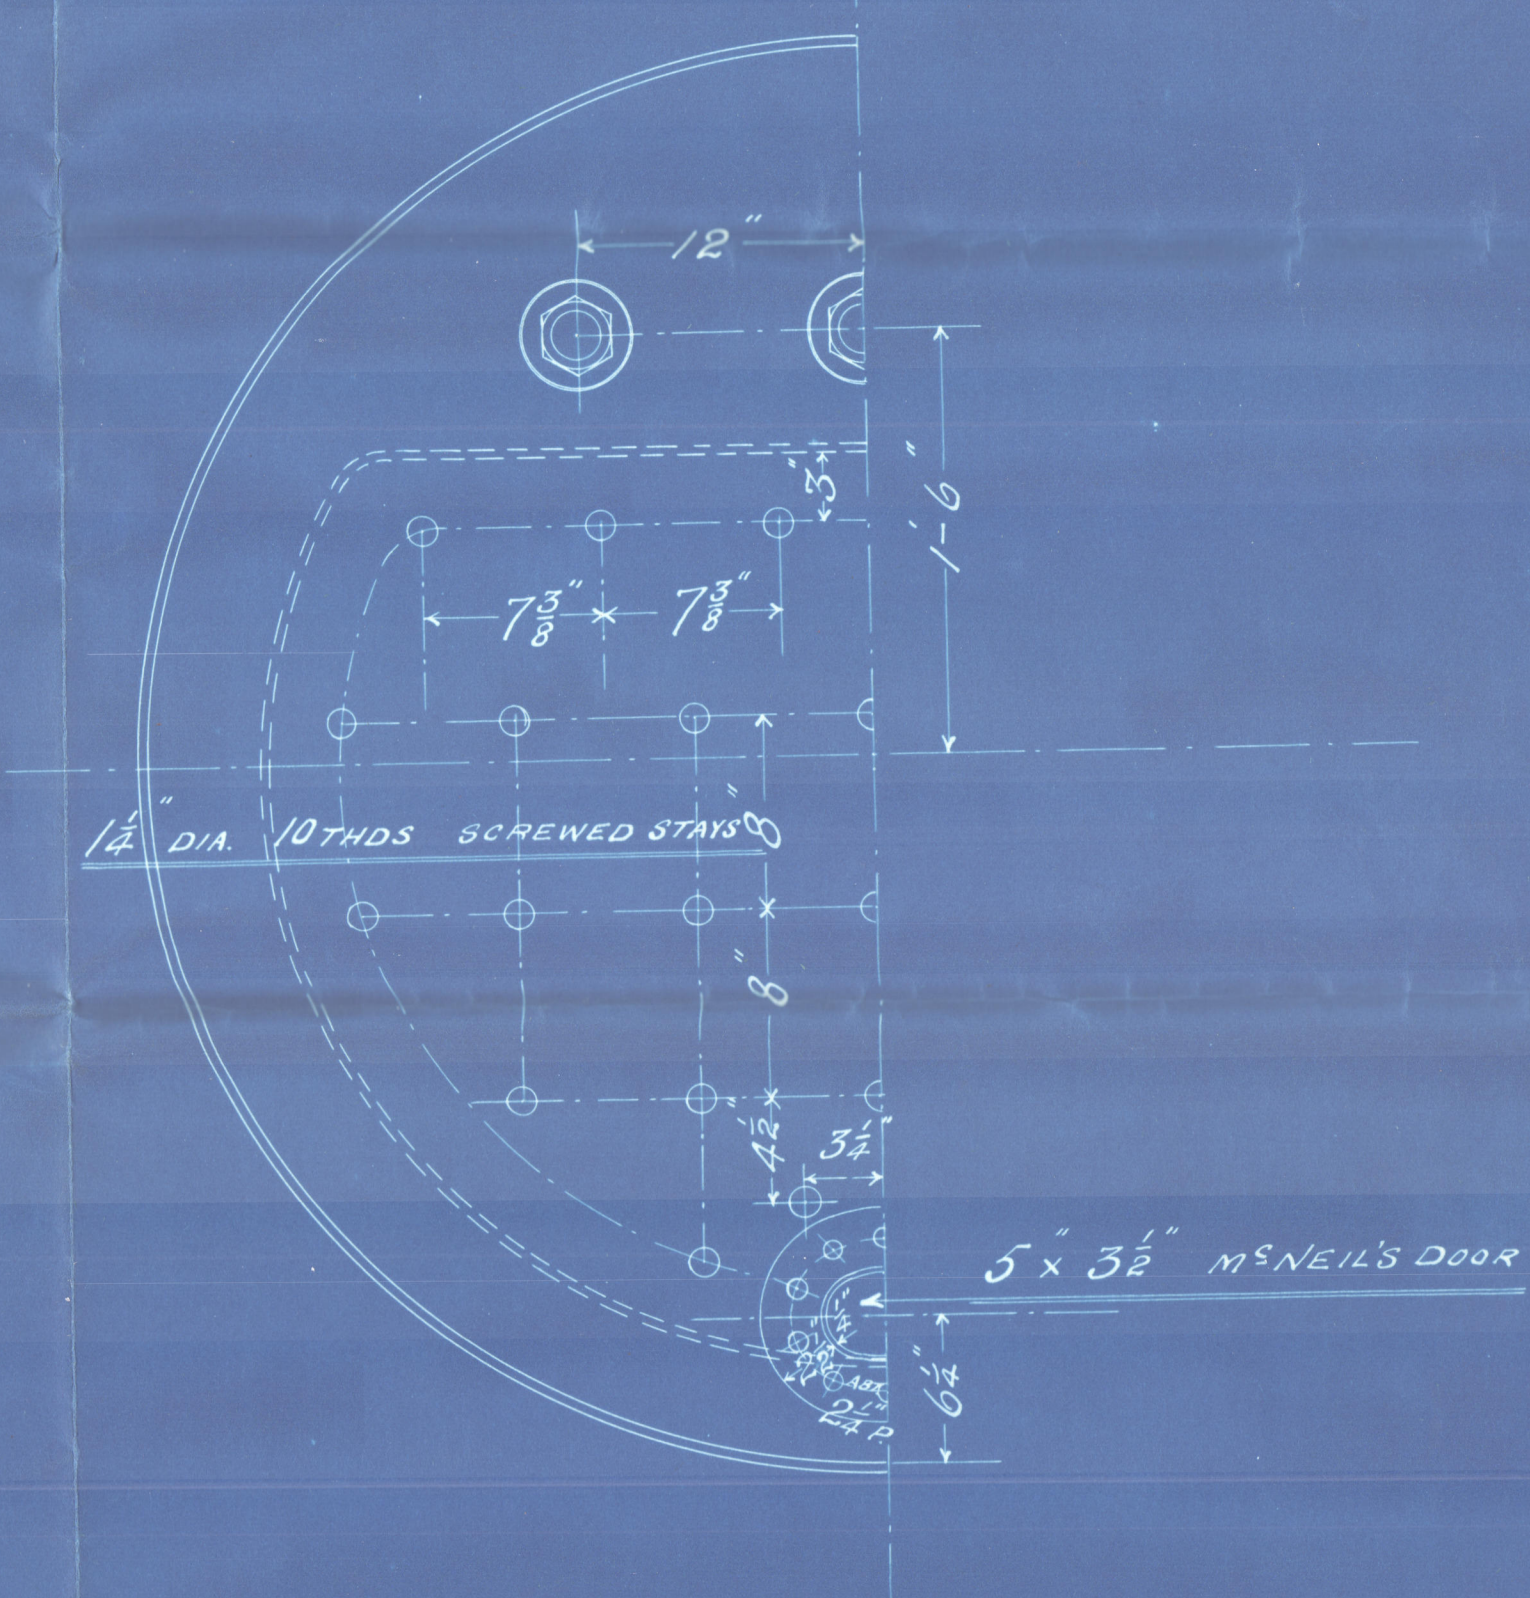
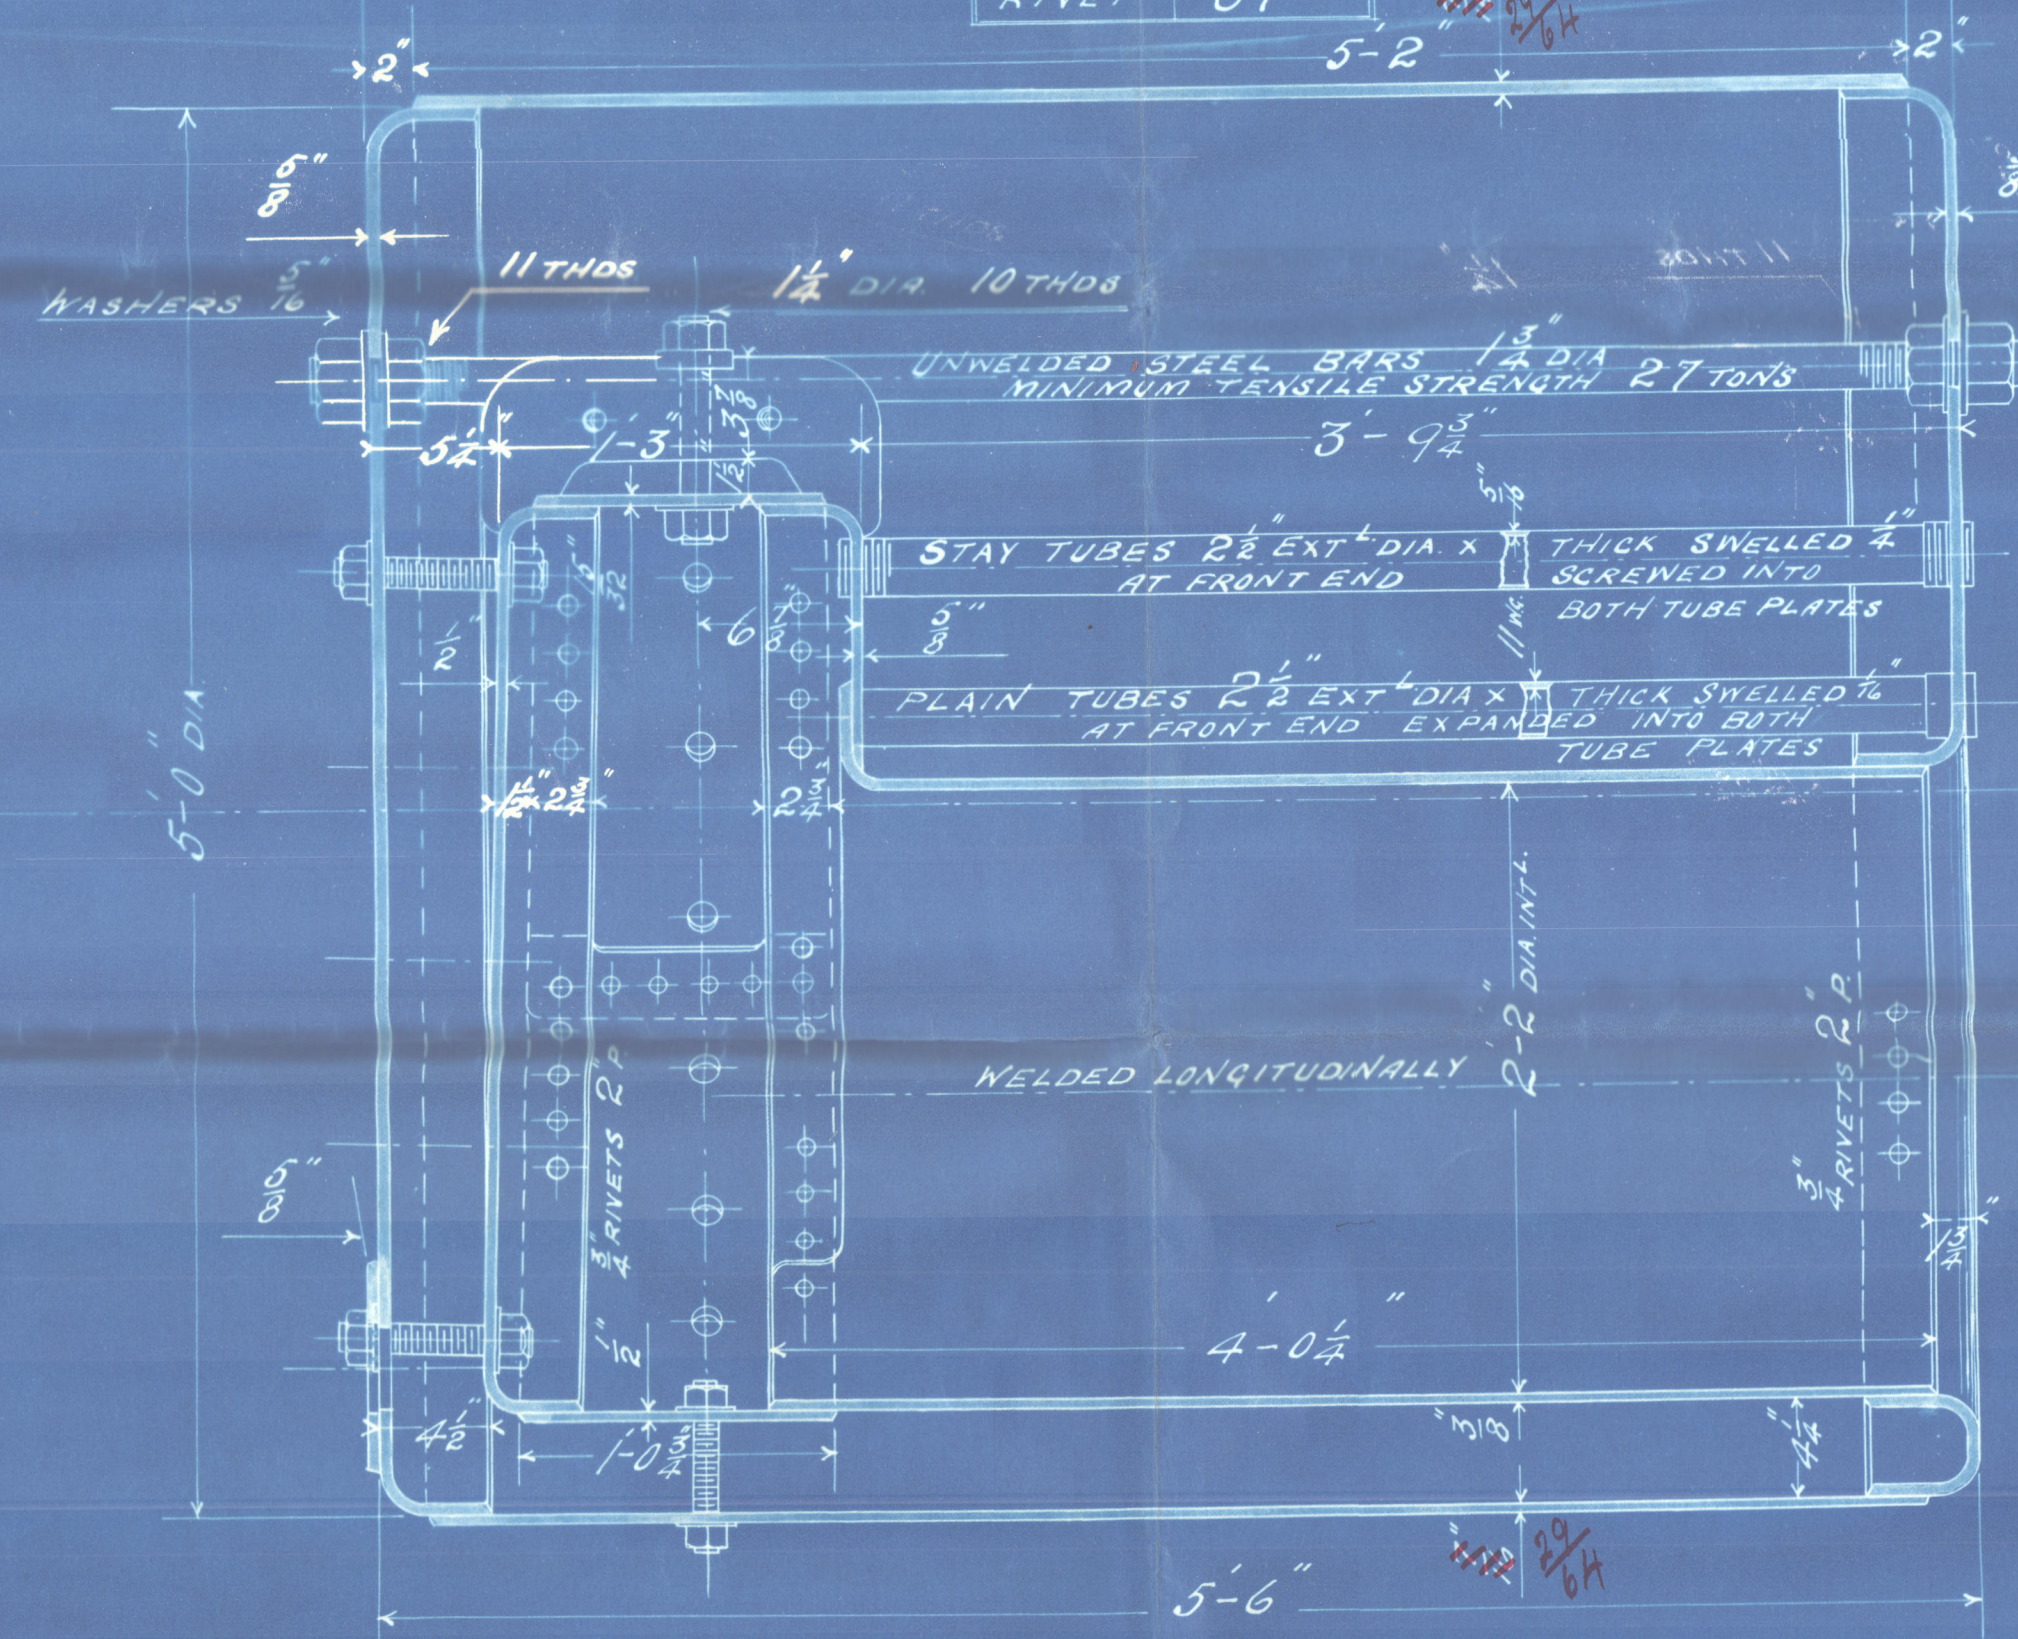
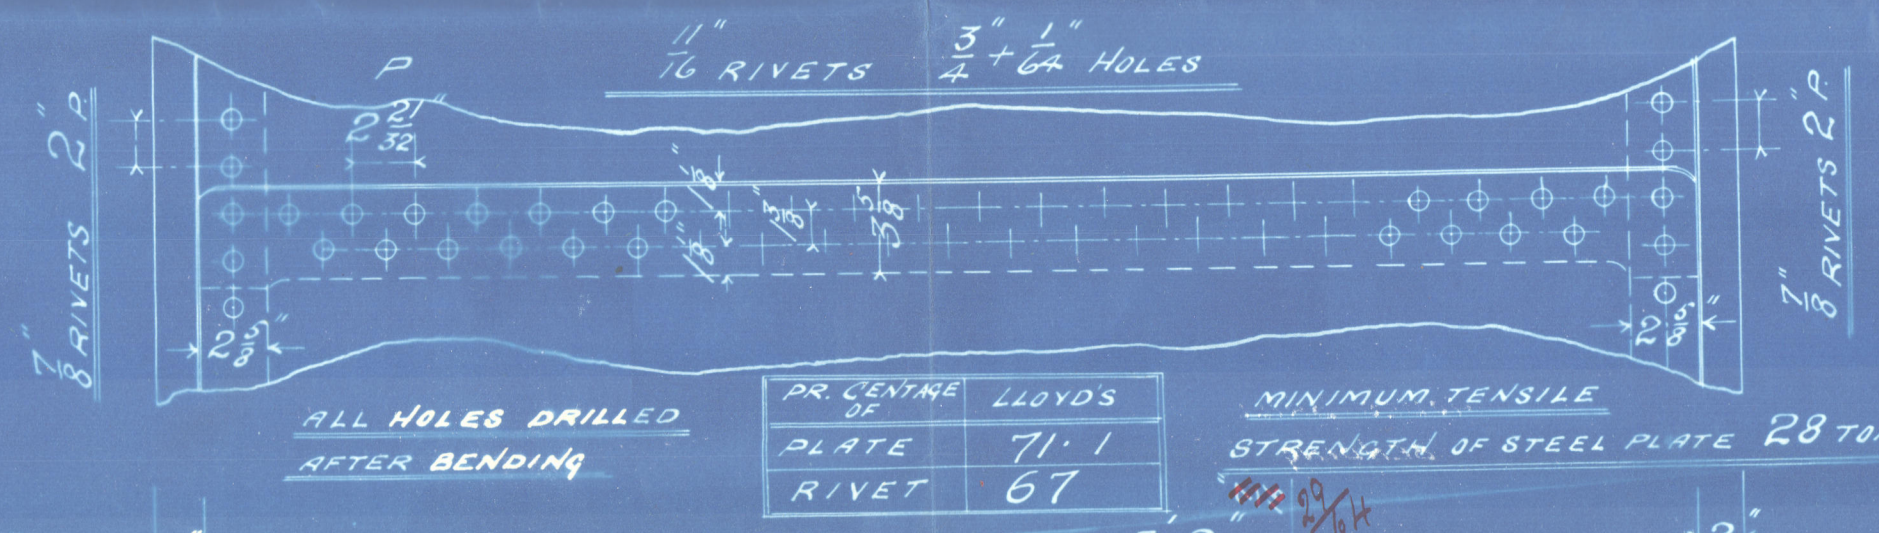



24.6.99.
LLOYD'S
GLASGOW

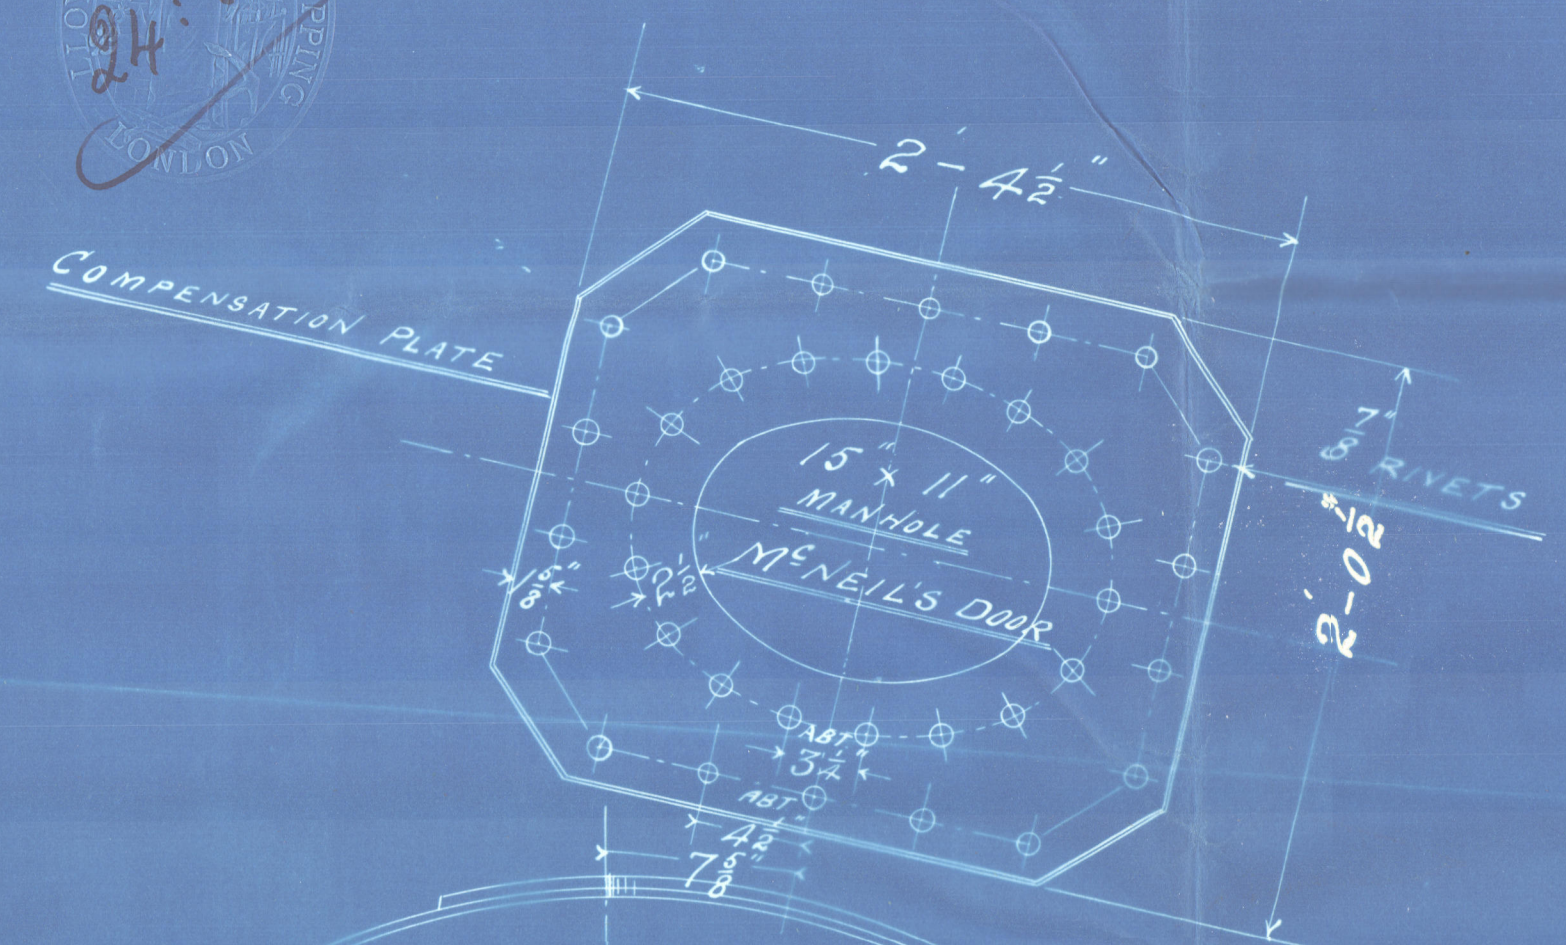

DESCRIPTION	NO. REQ.
STAY	14
PLAIN	32
TOTAL NO OF TUBES 46	

WPA
24.6.99.
LLOYD'S

120 LBS = W.P.
5'-0" DIA x 5'-6" BOILER
for
No 857
scale = 1/2" pr ft

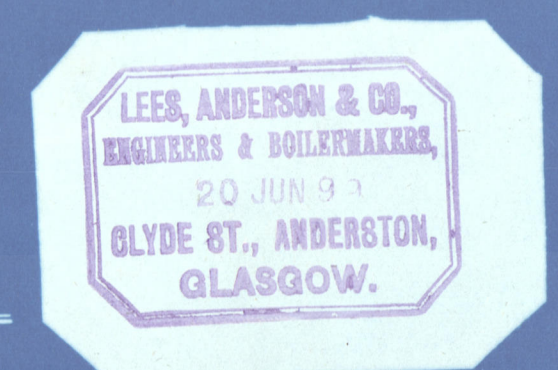


TO PASS LLOYD'S SURVEY.

Donkey Boilin No 854

3
Messrs Anderson & Co

Messrs Hindoch & Murray & Co 173 1/2

120 1/2 " working press"

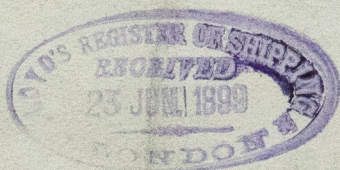

5/5 "Yamandua"

For 14643.



© 2021 GRK 351-0052

Lloyd's Register
Foundation