


Alt  
9. 11. 99

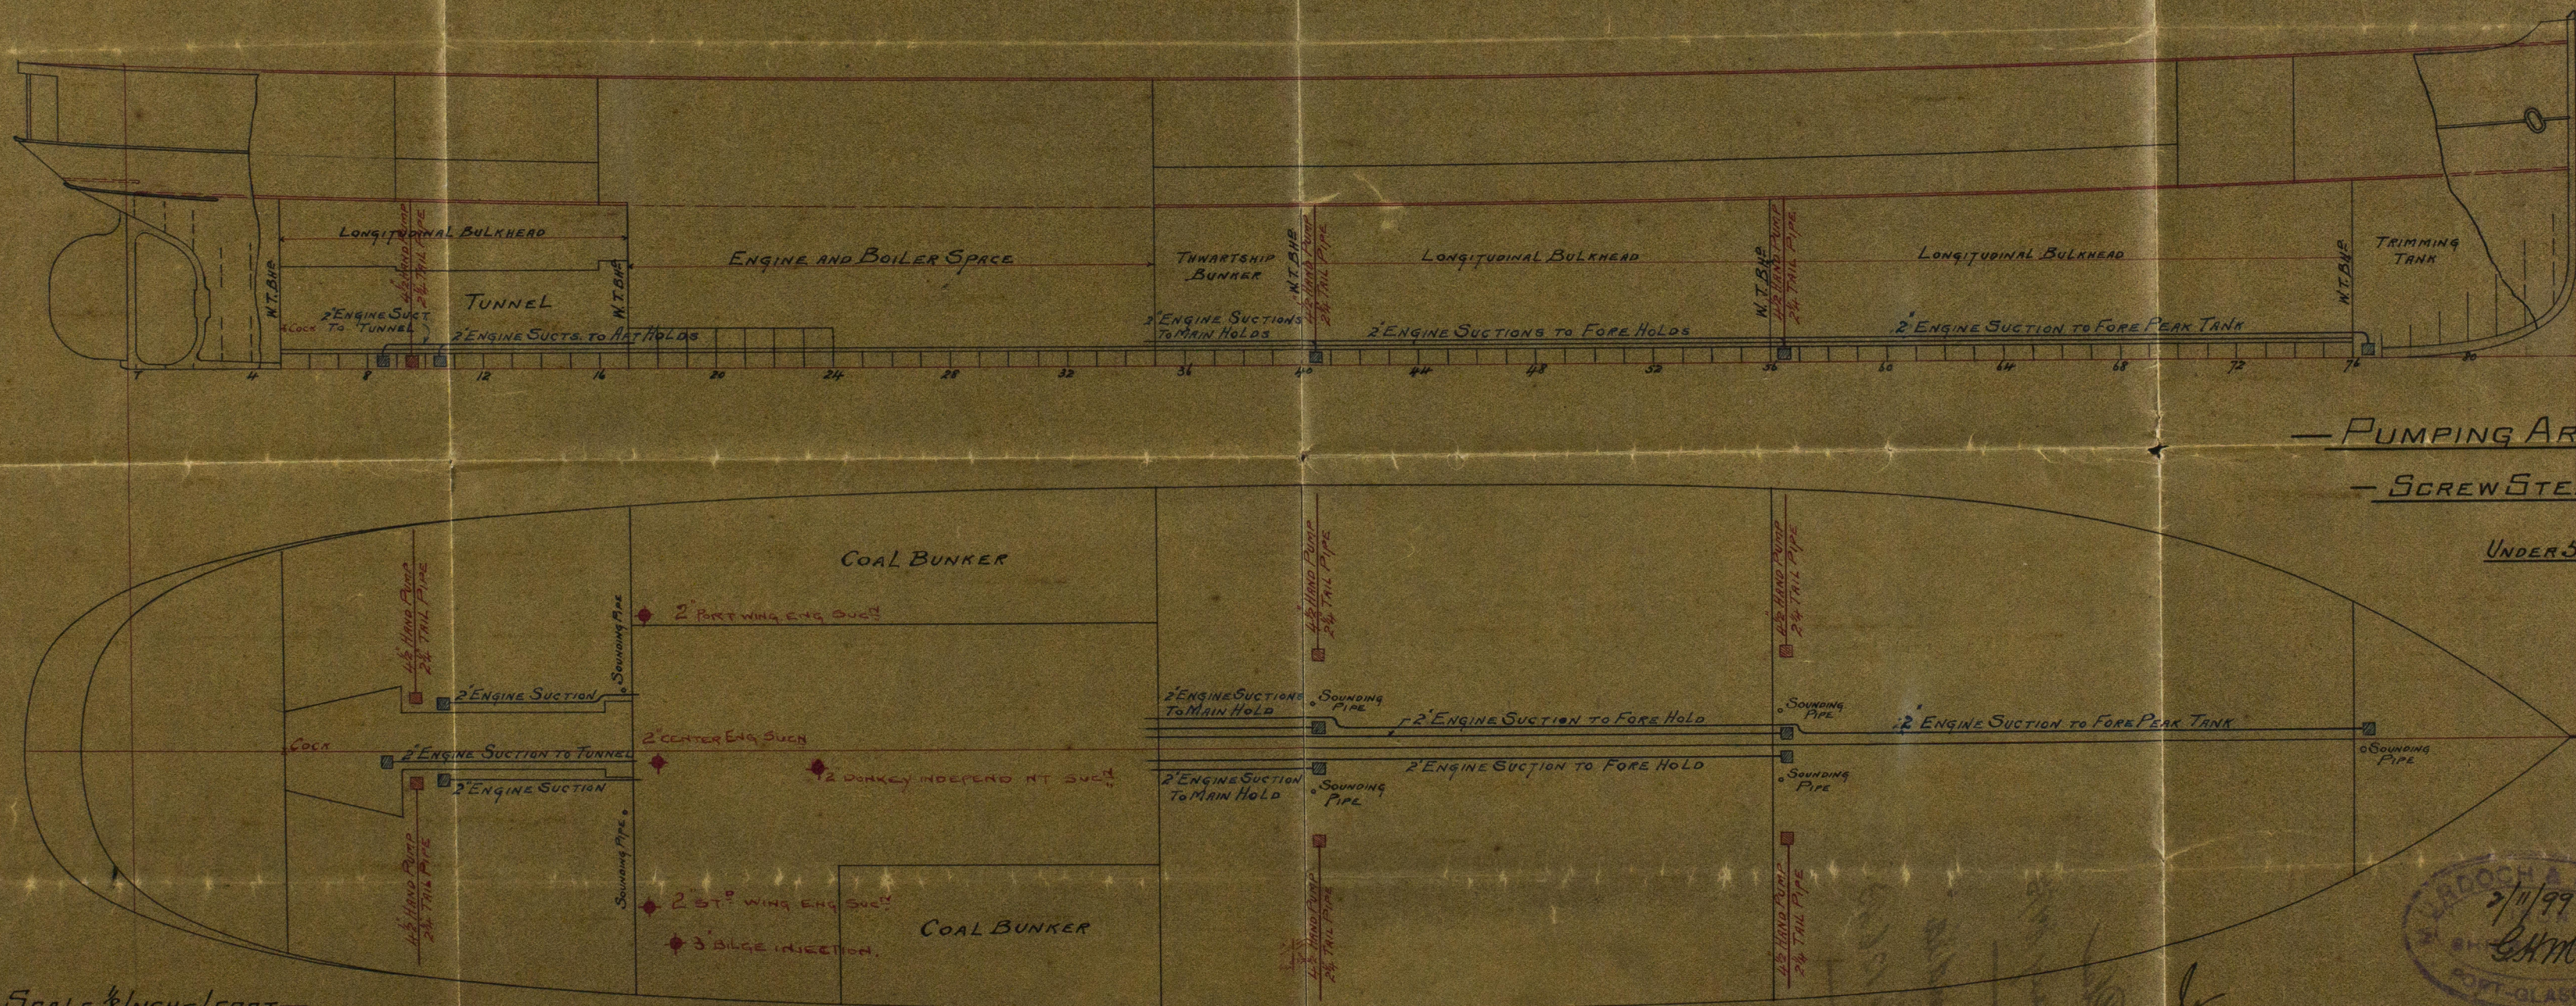


— PUMPING ARRANGEMENT —  
— SCREW STEAMER No 173 —

UNDER 500 TONS

— SCALE 1/4" = 1 FOOT —  
— DRAWING No 4049 —

Engineers Lees Anderson & Co

W. Glasgow 11/11/99

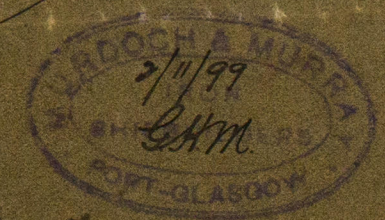

© 2007 Lloyd's Register Foundation



Pumping Plan  
Murdoch Murray 1873

S.S. "Damandua"  
Grk report No. 12643

GRK 351-0053



© 2021

Lloyd's Register  
Foundation