





22.11.98

S. S. No 26
Plan showing Tank Top in way of Boiler Space
Scale $\frac{1}{4}$ inch = 1 foot



Sketch of Side Stringers
with face angle fitted, from
frame 36 aft, & frame 100 fwd
instead of flanging plate

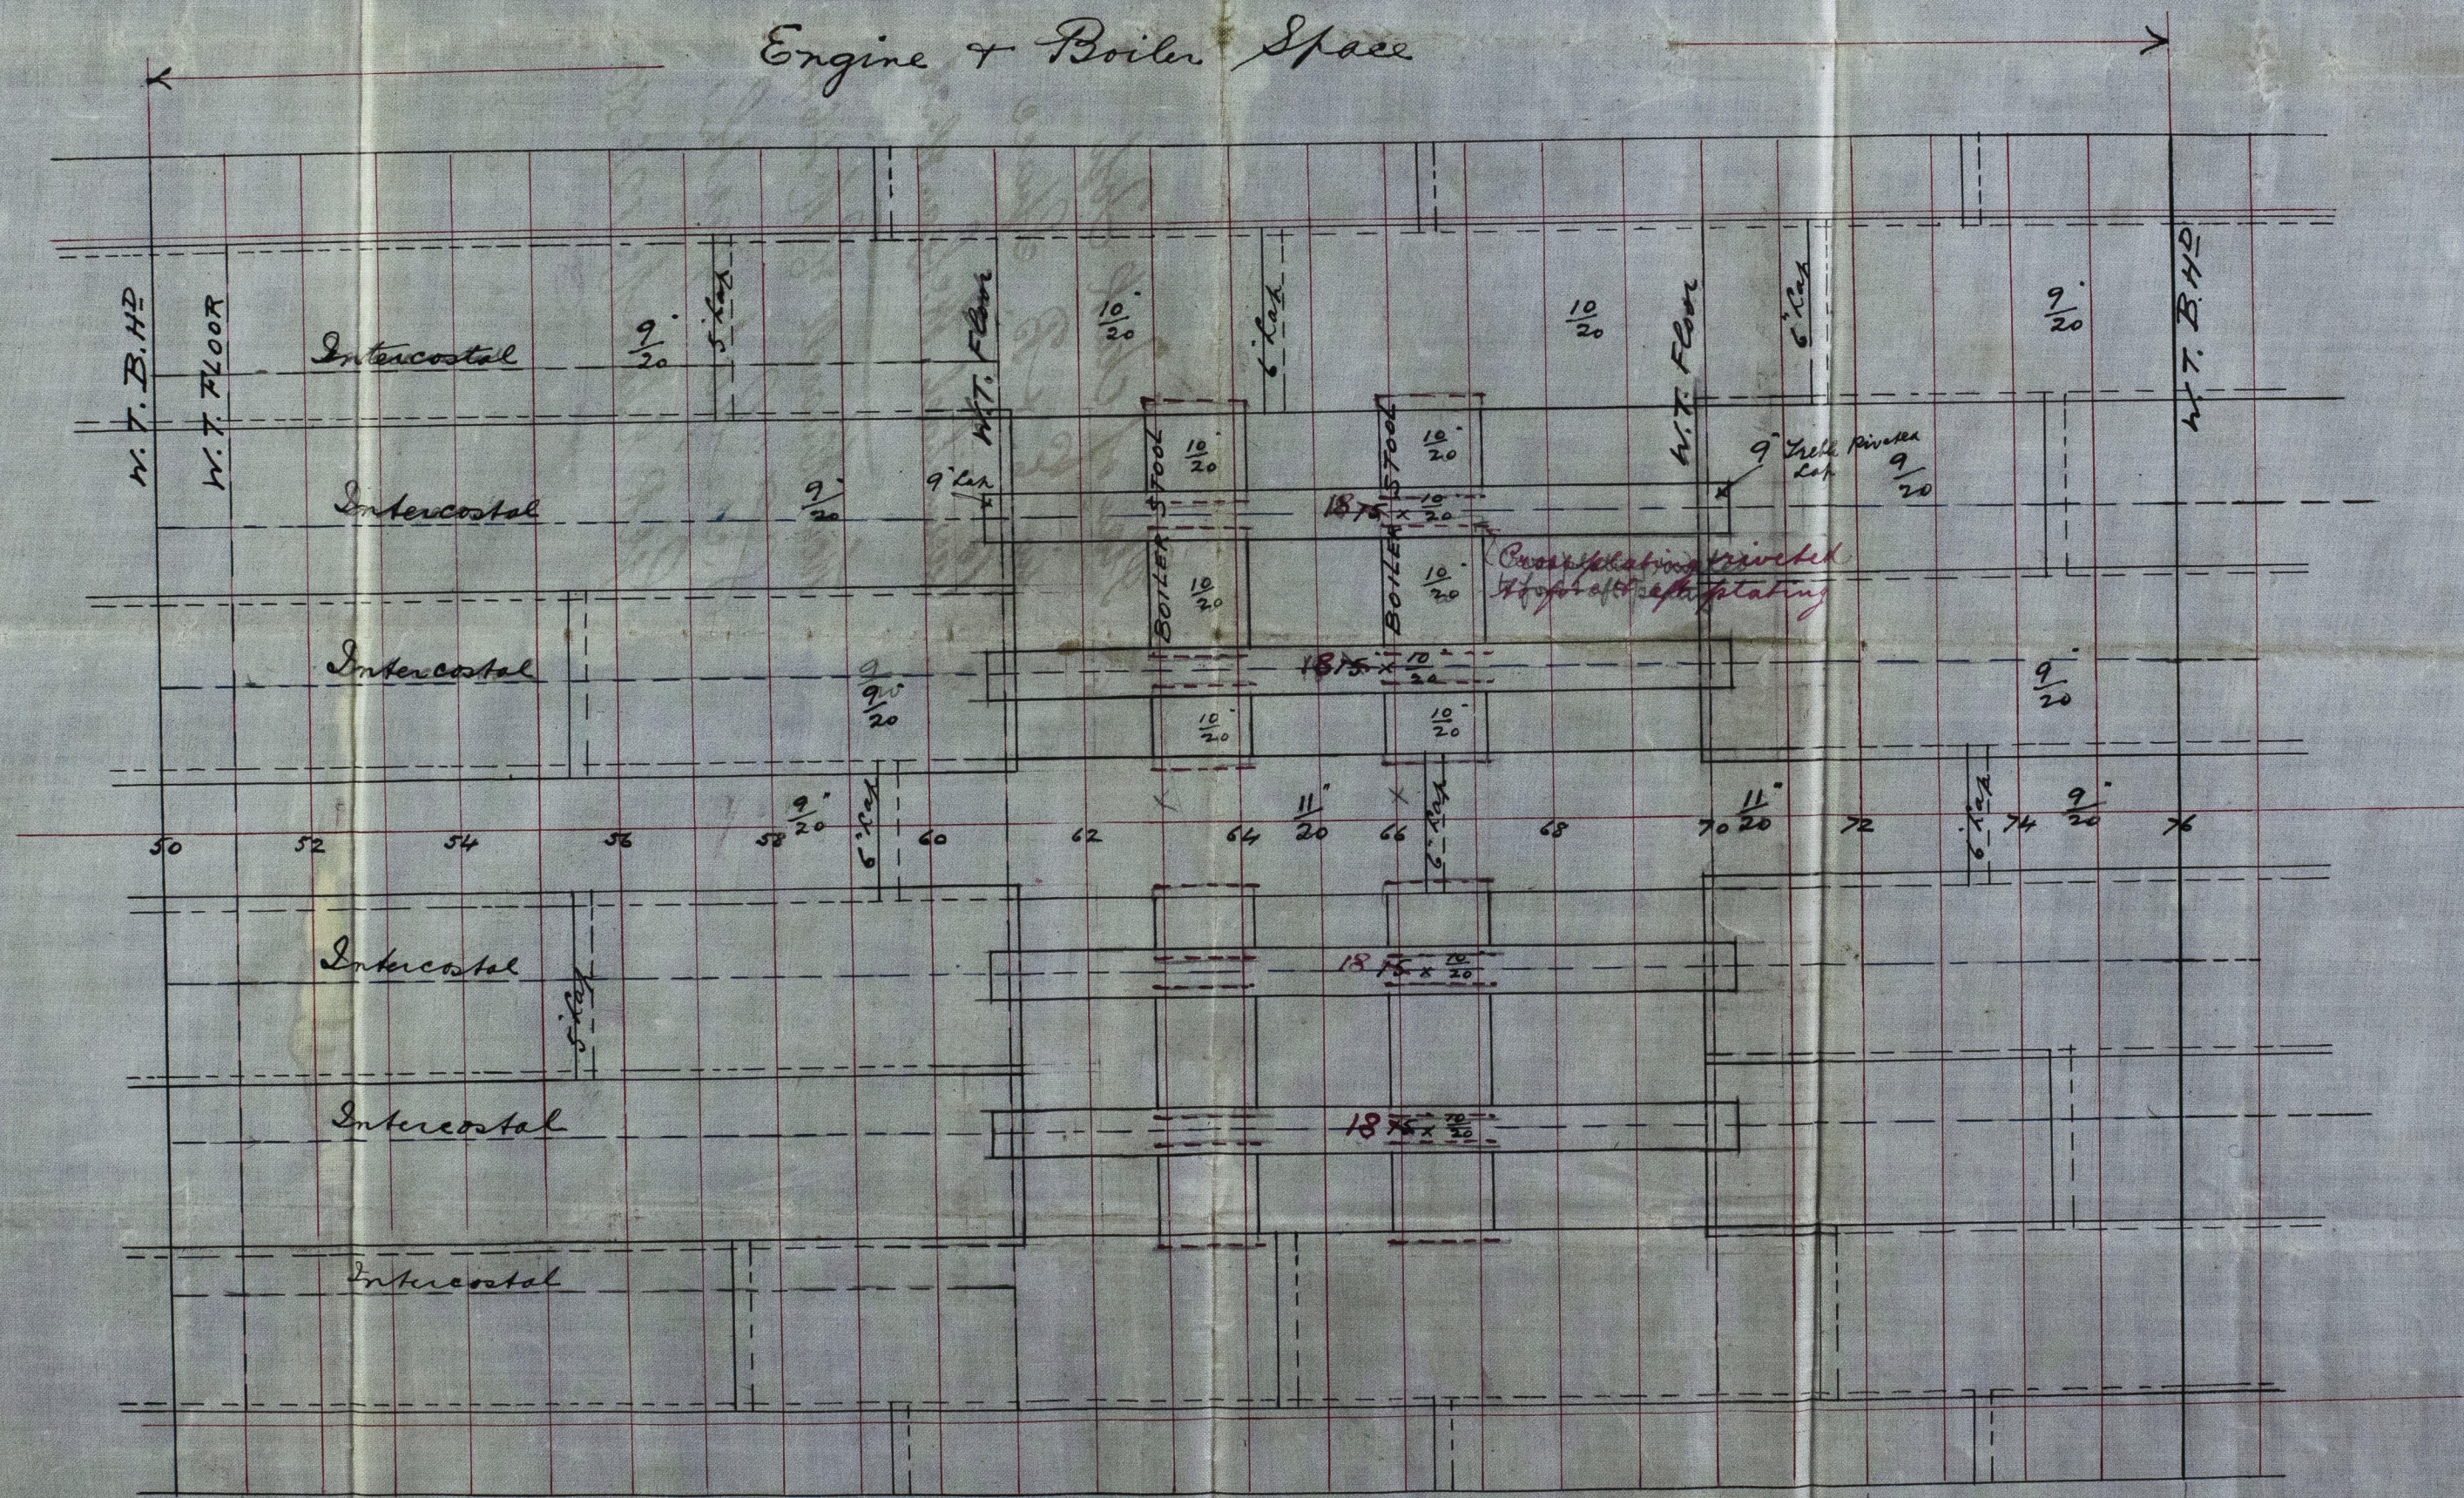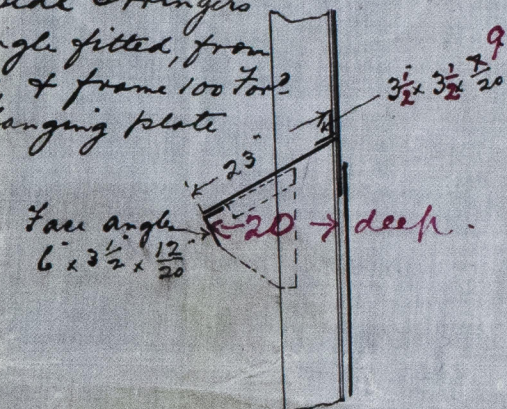

2 Cross Bunker

St. J.
19/11/98

Plan of Tank Top
in E. & B. Space
Carmichael McLean & Co
Now Russell & Co 464
S.S. "Gatesgarth",
GRK Report No. 12650



GRK351-0080



© 2019

Lloyd's Register
Foundation