

Scale $\frac{1}{2}'' = 1 \text{ foot}$

Reg No 862
Shipbuilders,
6/7/98
GREENOCK.

Numerals

$\frac{1}{2}$ Breadth	18.92
$\frac{1}{2}$ Girth	35.55
Depth	20.55

1^{st} Numeral $74.97 \times 268.5 = 20127.2^{nd}$ Numeral

$$\frac{L}{O} = 13.1$$
$$\frac{L}{B} = 7.09 \quad 7.20$$

<u>For Raised Quarter D^h</u>	74.97
	<u>3.46</u>

1st numeral $\frac{78.43}{\underline{\underline{\quad}}}$ $\times 268.5 = 21058$ 2nd numeral

$$\frac{L}{D} = 11.2$$

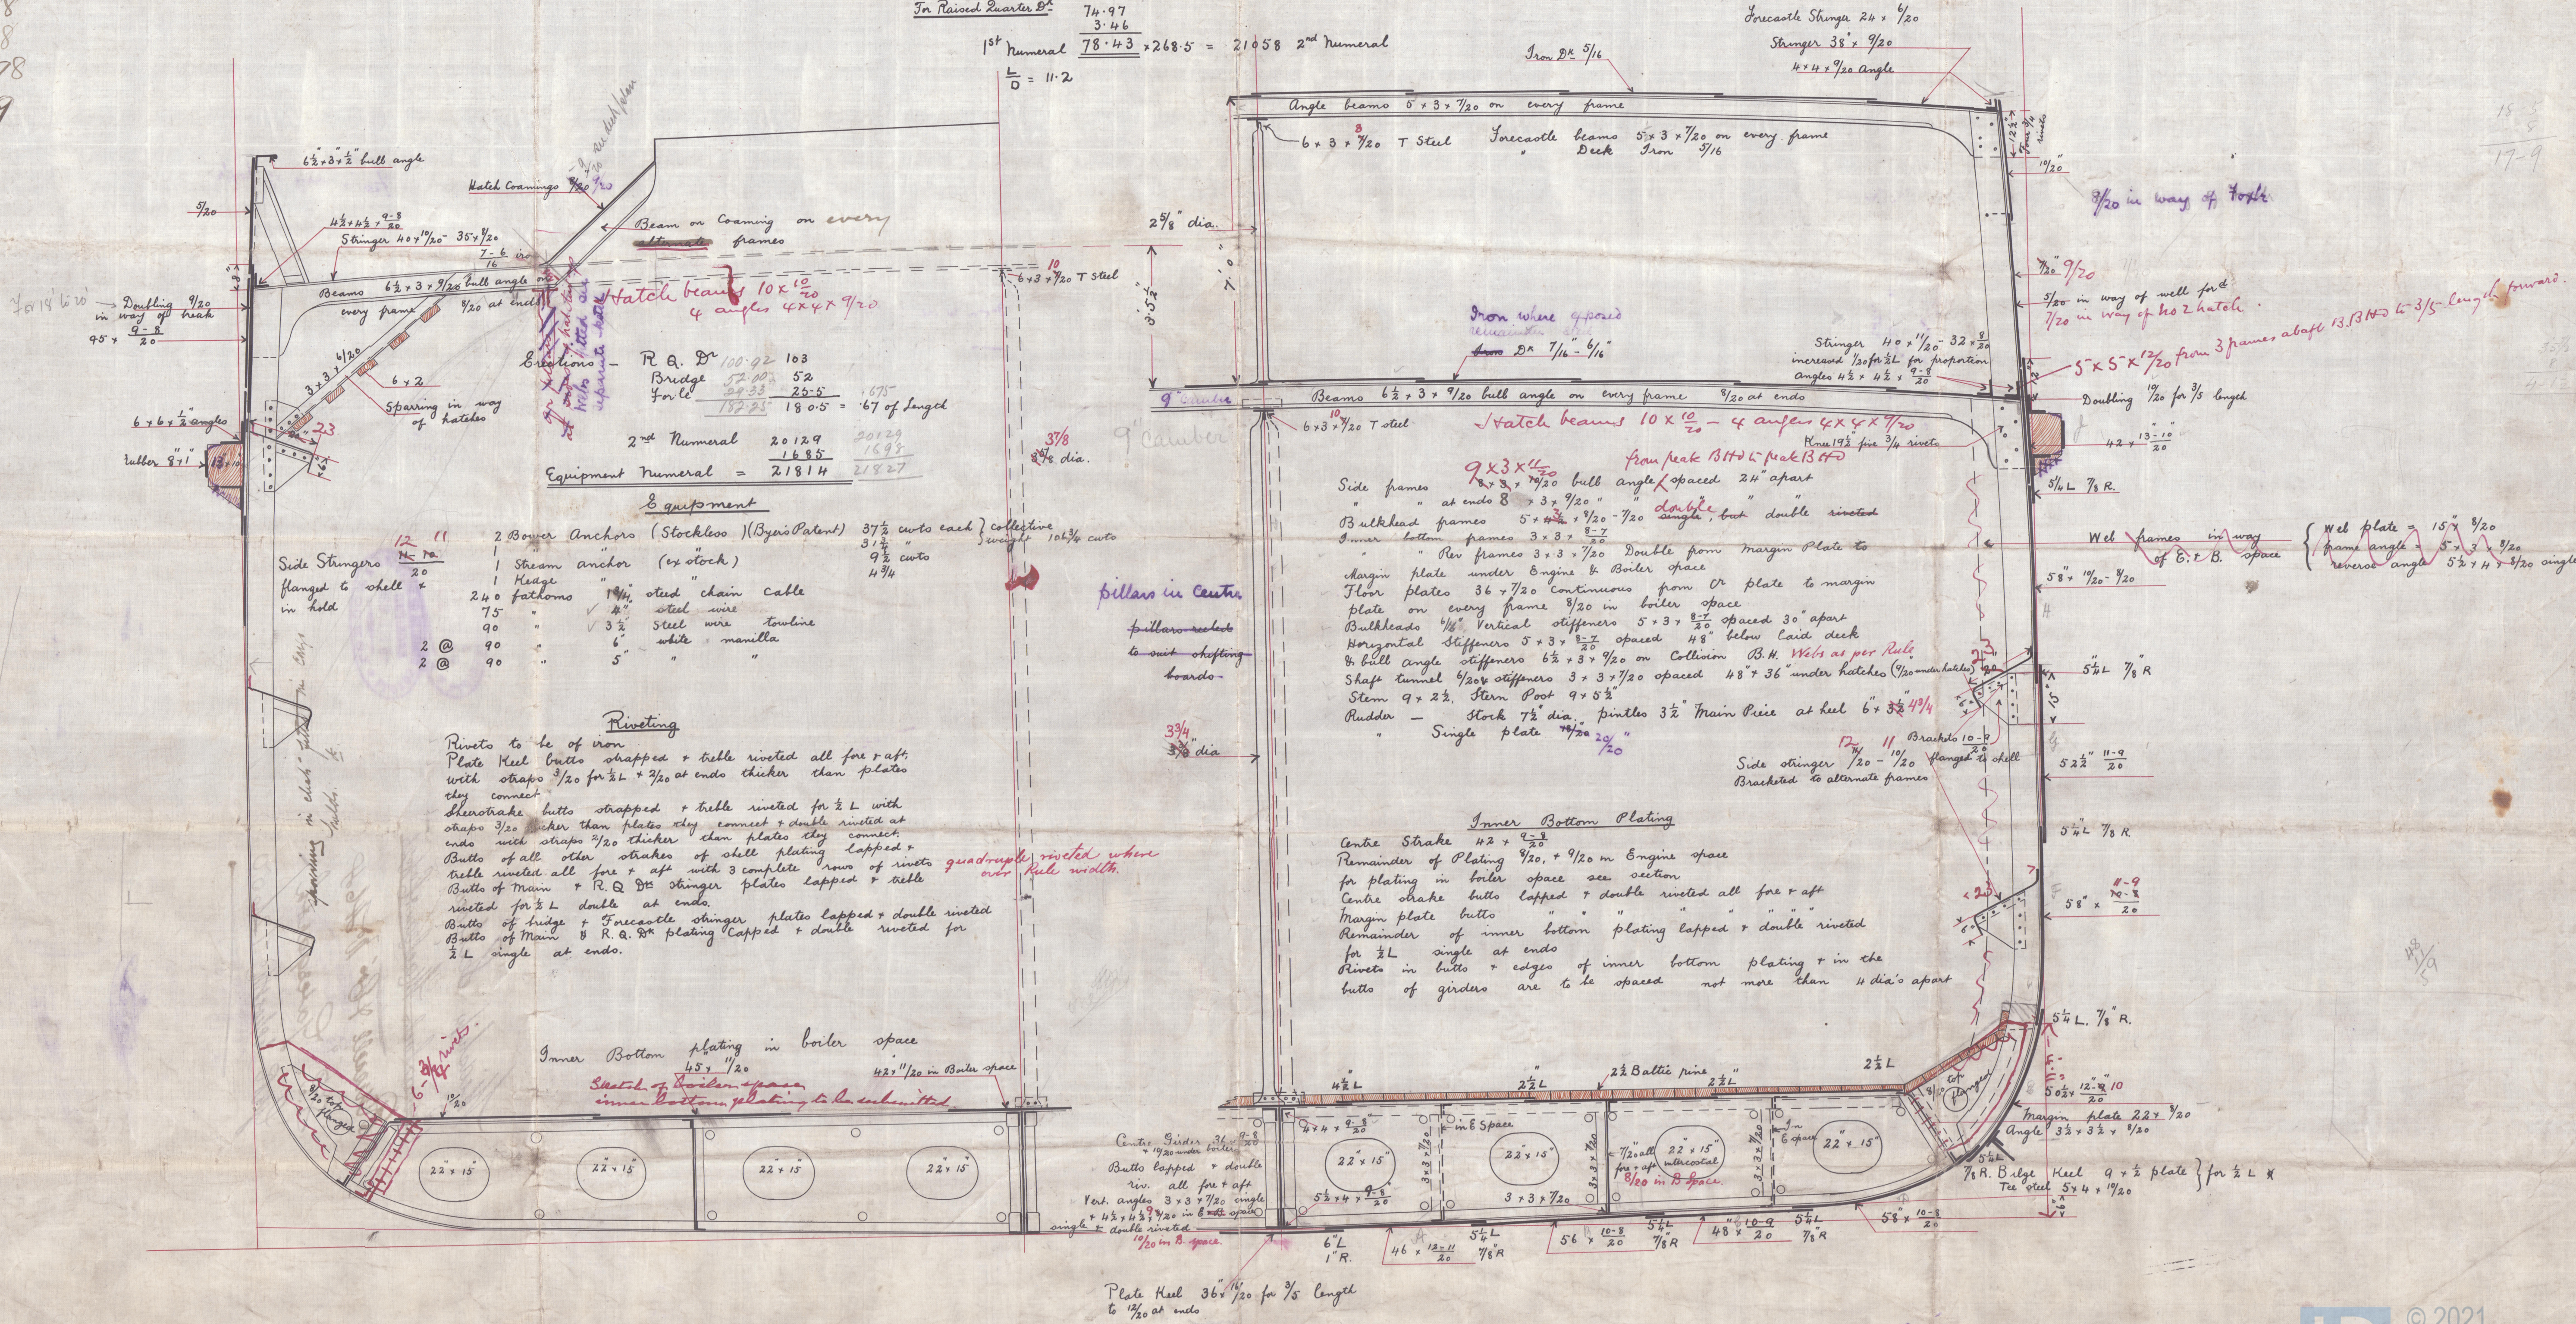


Plate heel $36 \times \frac{16}{20}$ for $\frac{3}{5}$ length
to $\frac{12}{20}$ at ends

Midship Section
~~Carmichael Maclean & Co~~

Russell & Co No 464

S.S. "Gatesgarth"

G.R. Report No 12650



© 2021

Lloyd's Register
Foundation