

# Midship Section

S.S. No 454


Dimensions 340' x 52' ex. 51'-9 1/2" mld. x 29'-11" moulded.

To class 100 A.1 at Lloyds. Three Deck Rule.

Scale 1/2" = 1 Foot.




24.11.98  
8.12.98

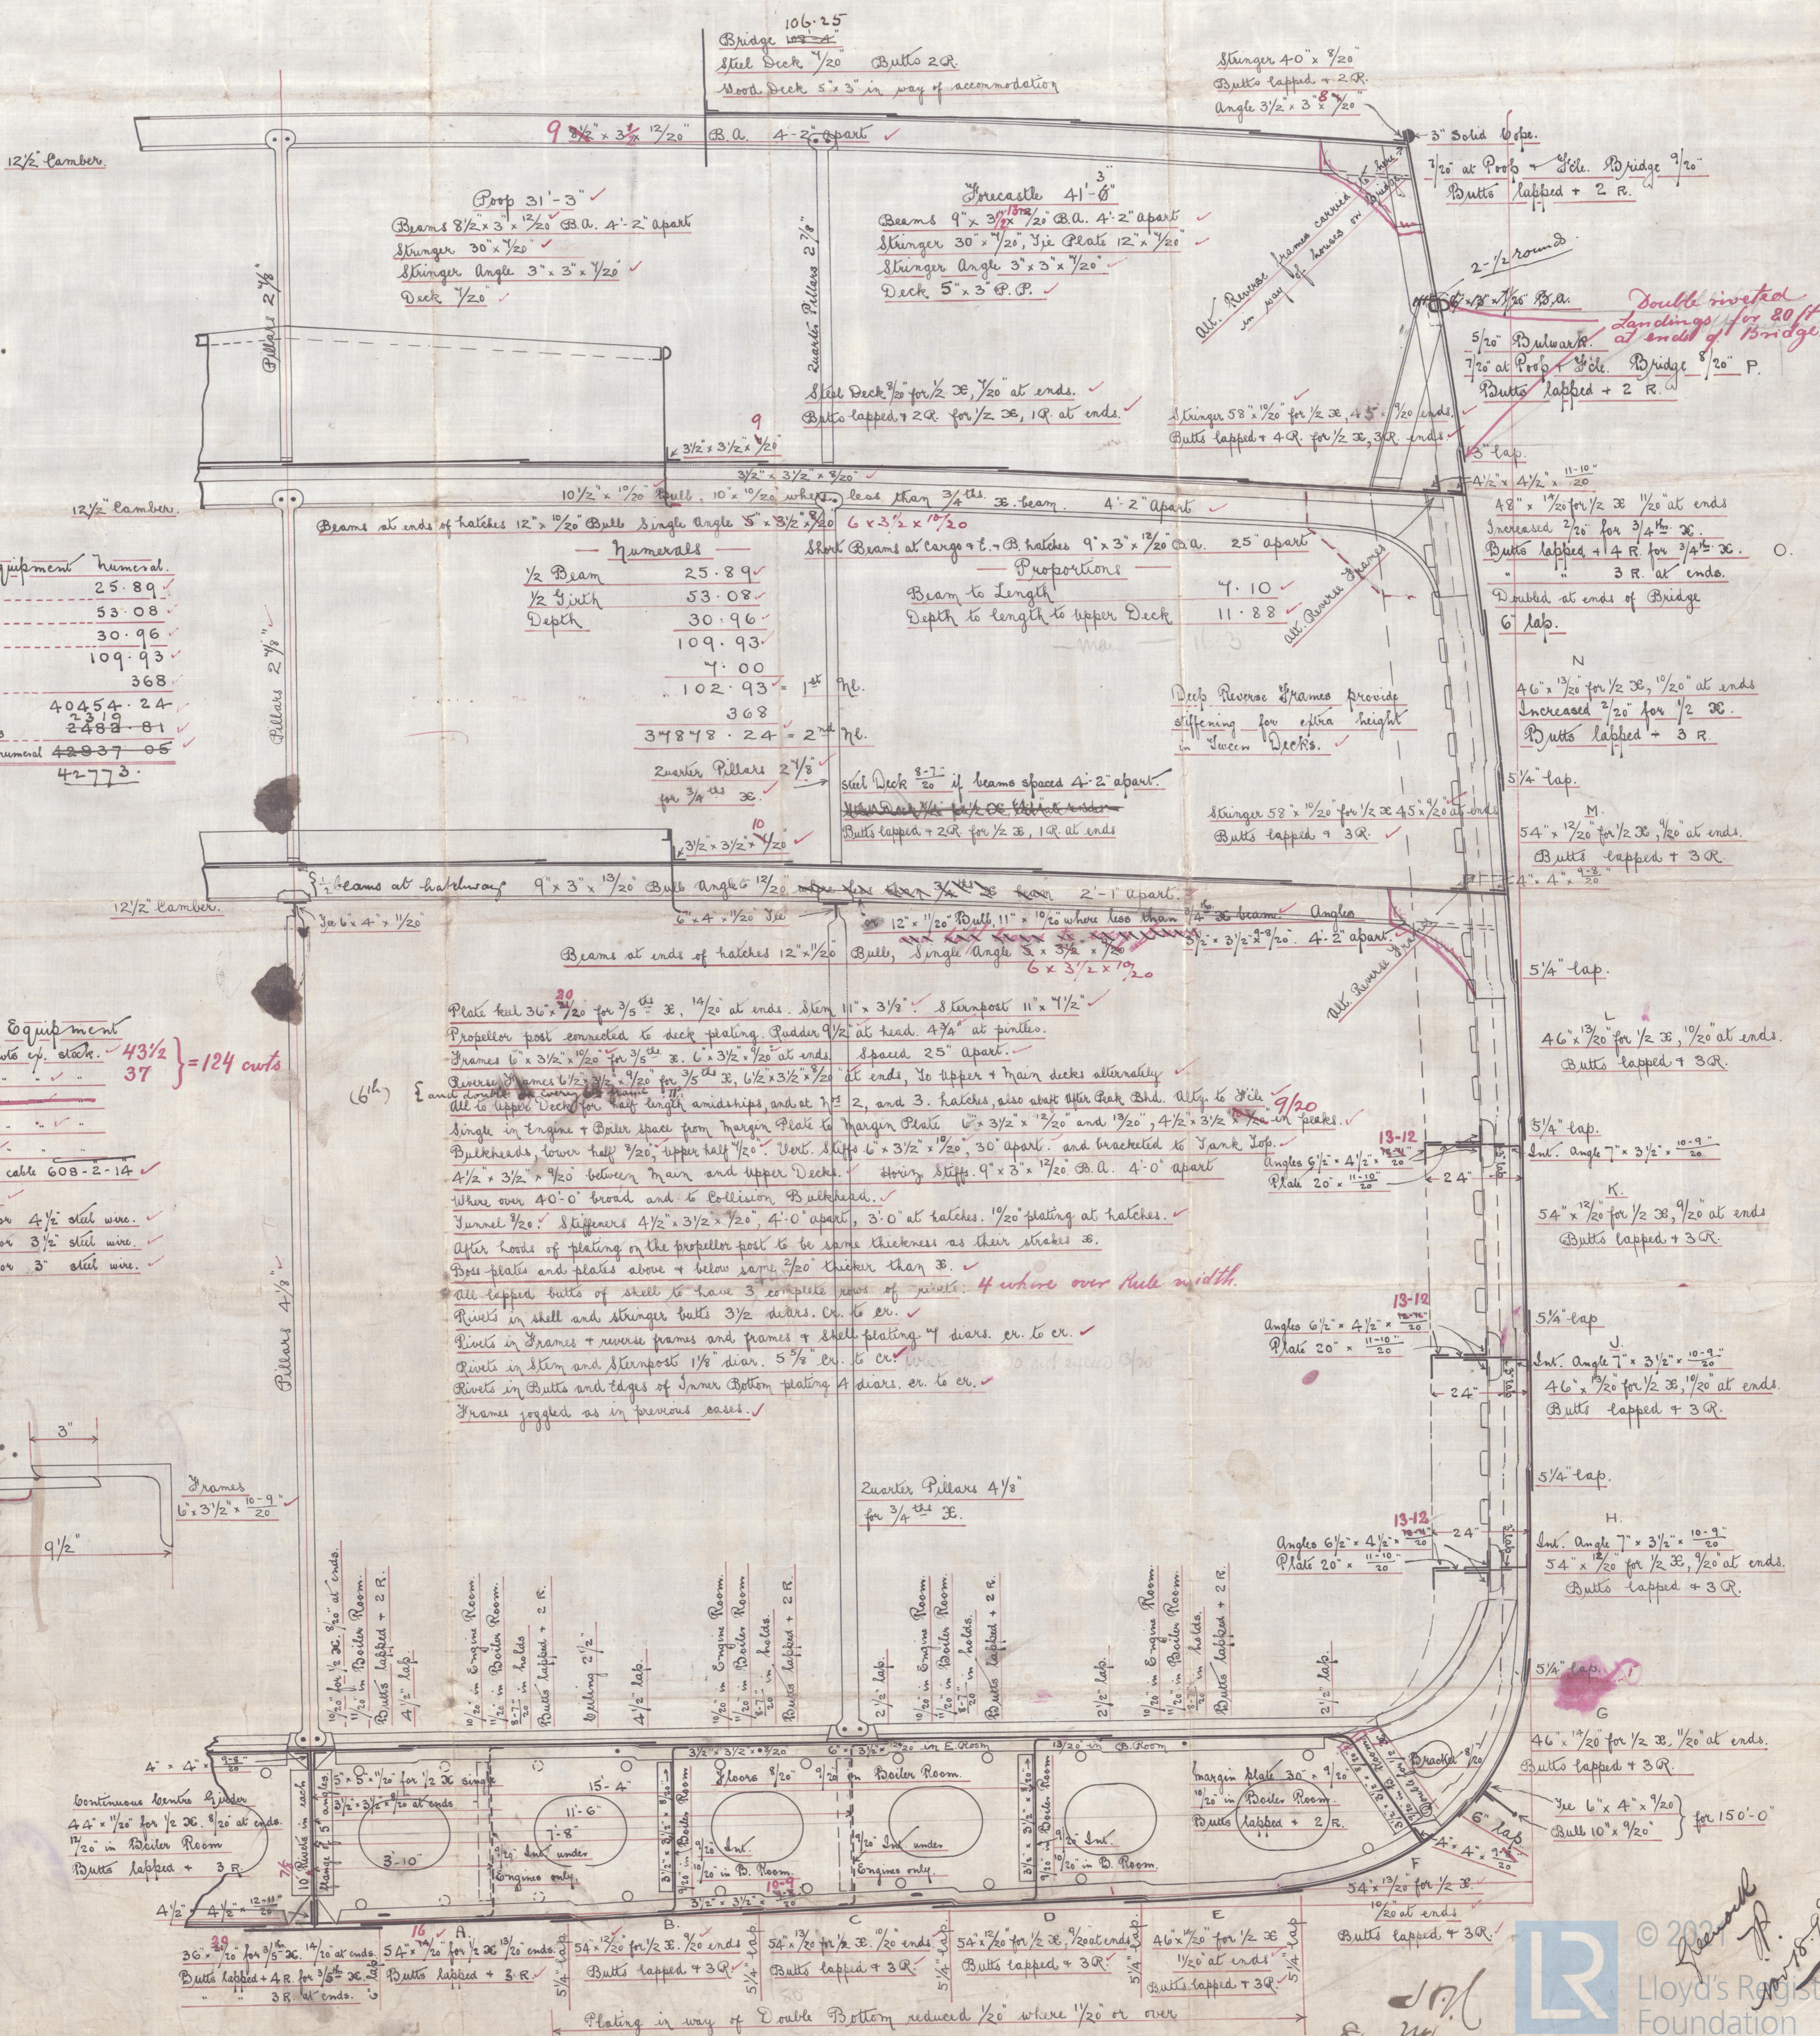

Midship Section  
Russell & Co No 454  
S.S. Oceano "  
Grk report No 17638.

GRK 351-0120

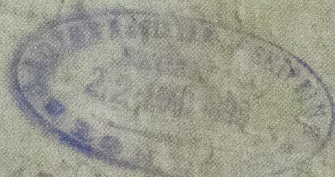

© 2021

Lloyd's Register  
Foundation