


17.11.98

Longitudinal & Deck Plans.

S.S. N°453

SCALE 1/8 INCH = ONE FOOT.

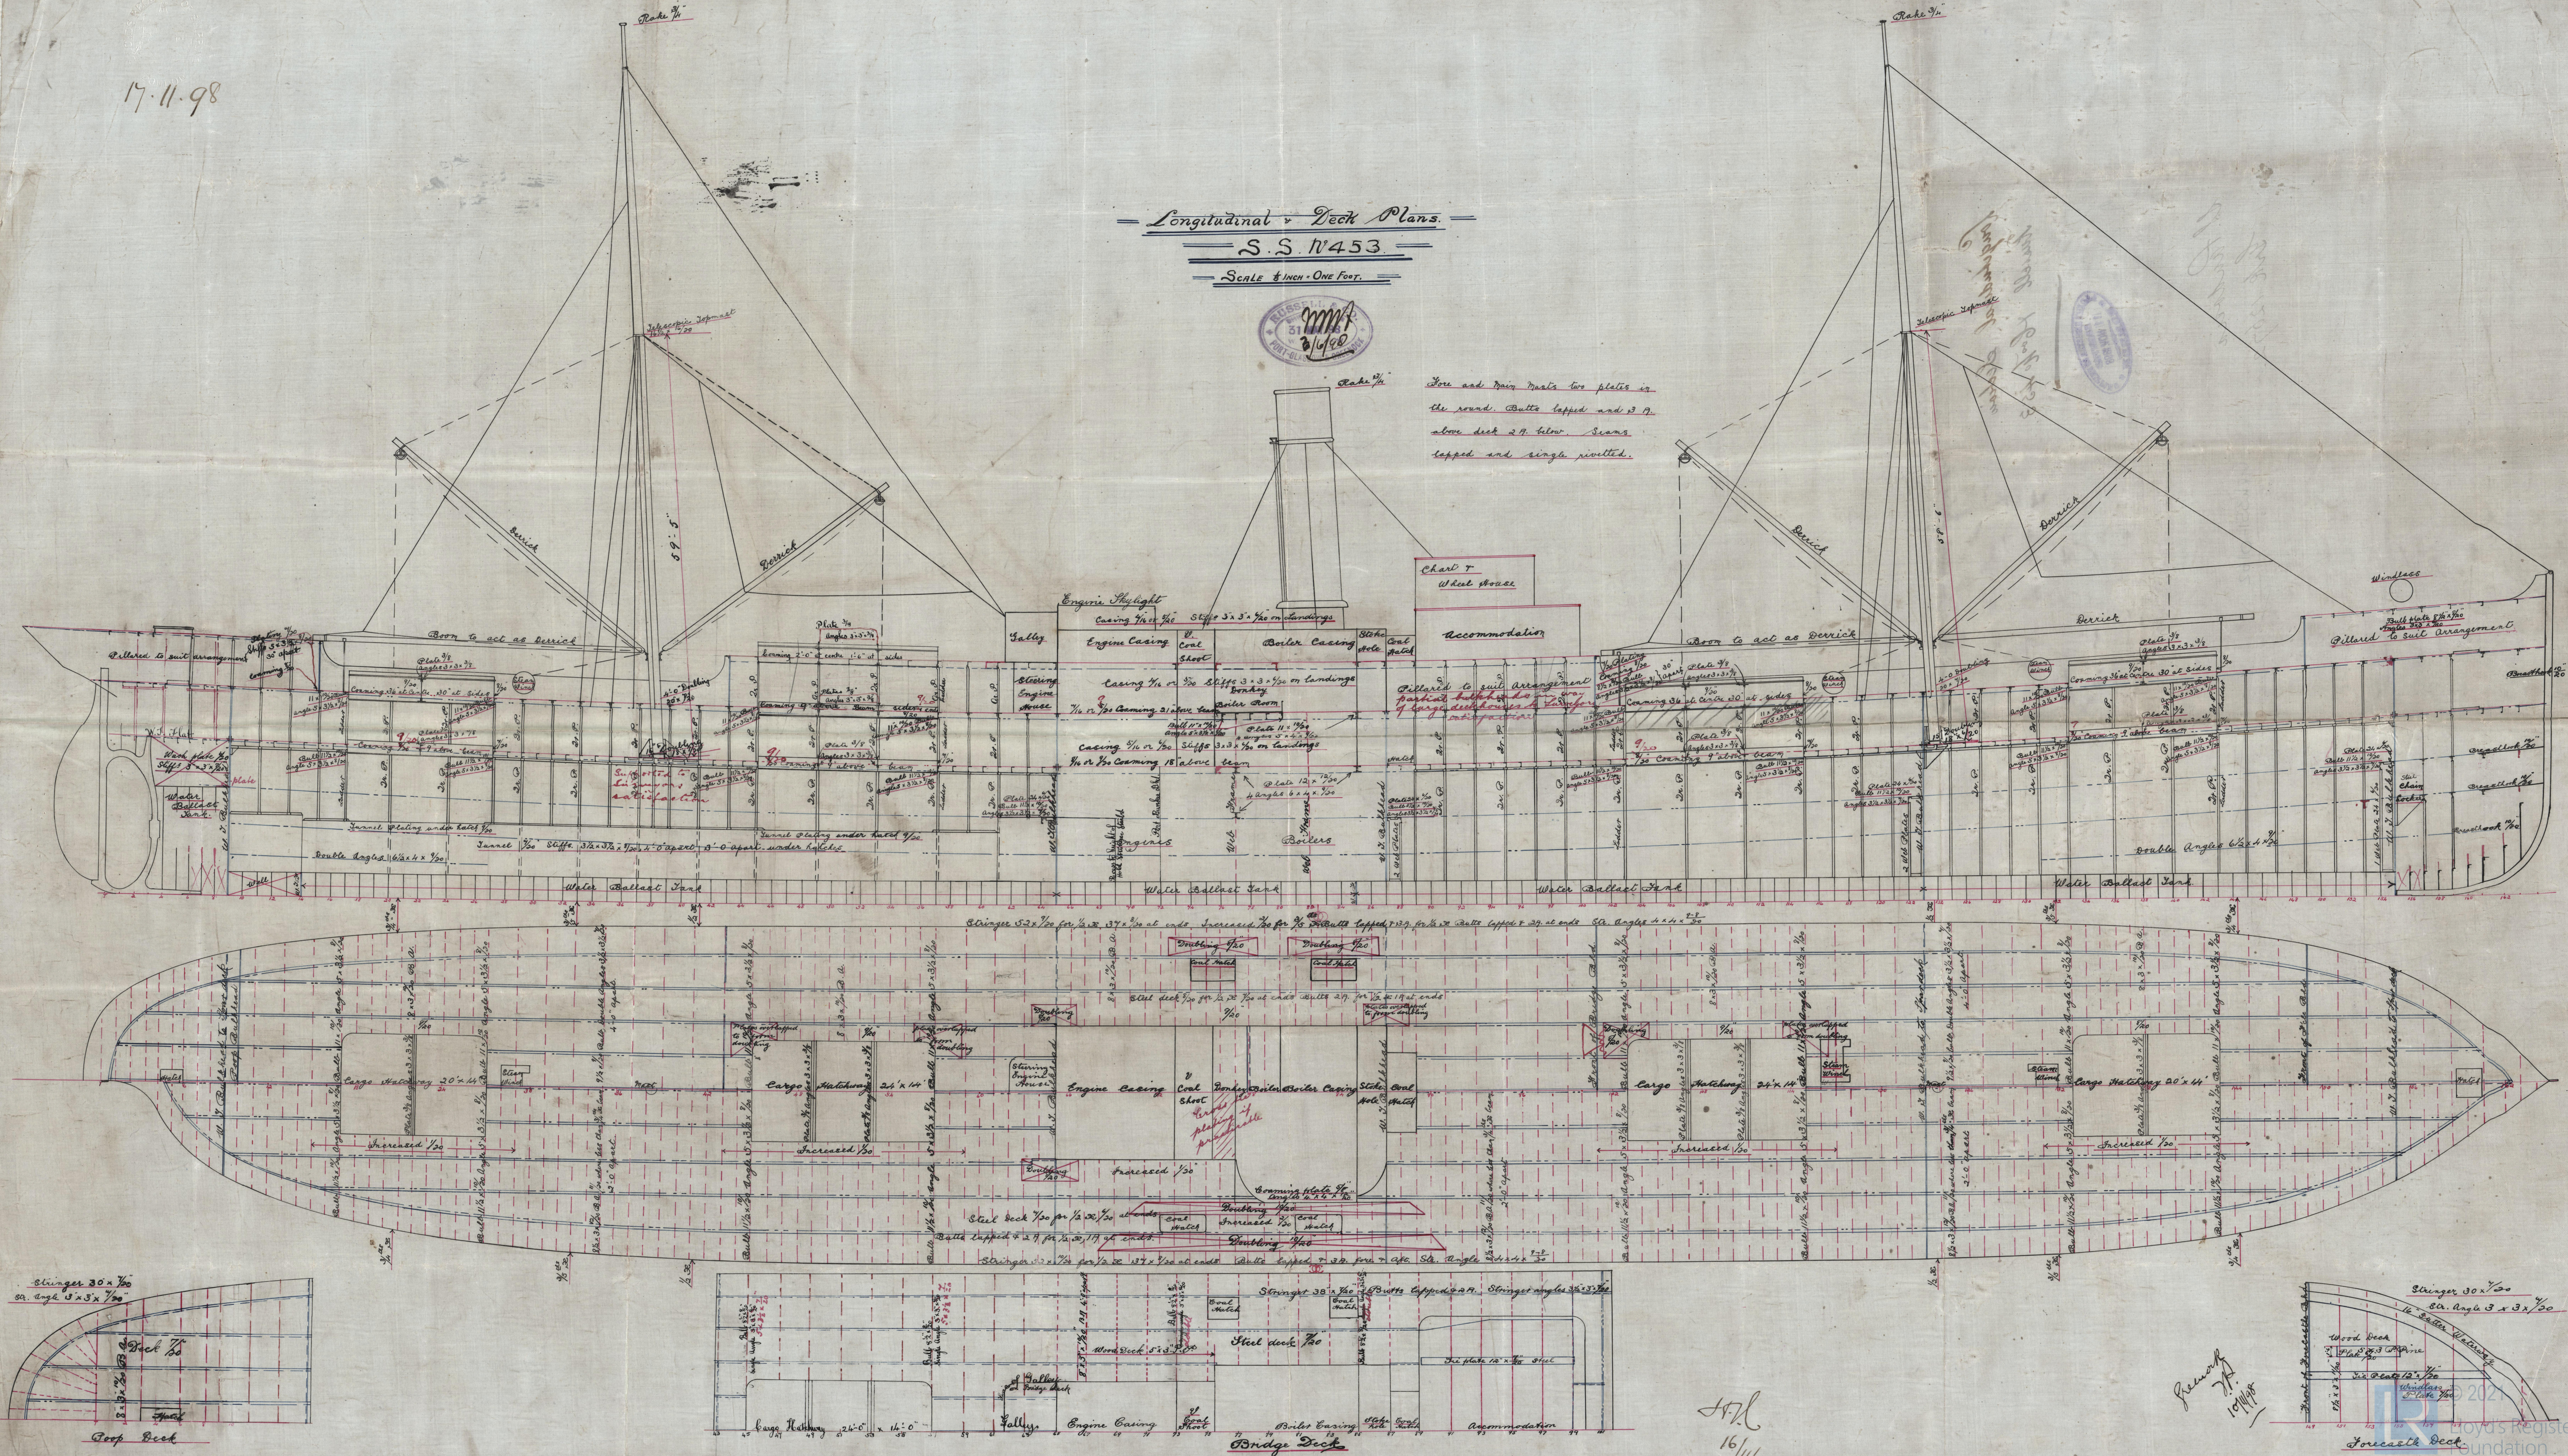

Longitudinal Section
Russell & Co No 453.



S. Paudras
Grk 12672.

Grk351-0162



© 2021

Lloyd's Register
Foundation