

27.7.99

— DIMENSIONS —

LENGTH AS PER RULE	149.16
HALF BREADTH MLD	15.0
" SPONSORED	17.5
DEPTH FROM TOP OF KEEL TO MNDK	9.08
HALF GIRTH	23.5

— MIDSHIP SECTION —

— T. S. S. N°174 —

— TO CLASS * AI AT LLOYDS. —

— FOR RIVER PURPOSES ONLY. —

— EQUIPMENT —


ANCHORS 2 BOWERS STOCKLESS EACH 10 CWTs	
" 1 KEDGE EX. STOCK	1 3/4 "
" " " "	3/4 "
CABLES 120 FATHOMS 1 5/8" STUD CHAIN CABLE	
" 50 " 3/4" STREAM CHAIN	

— Frames —

In way of forecastle, all to fore deck
" " sidehouses alt. to prom. dk
Between " every 4' to "
Intermediate frames to support bulwarks


— Riveting —

Butts of stringers & ties D.R.
" keel plates D.R.
" "shell" D.R.
All landings except keel
& sheerstrake S.R.
All rivets 3/8" except stem
sternpost, keel plate butts
& sheerstrake butts & landing

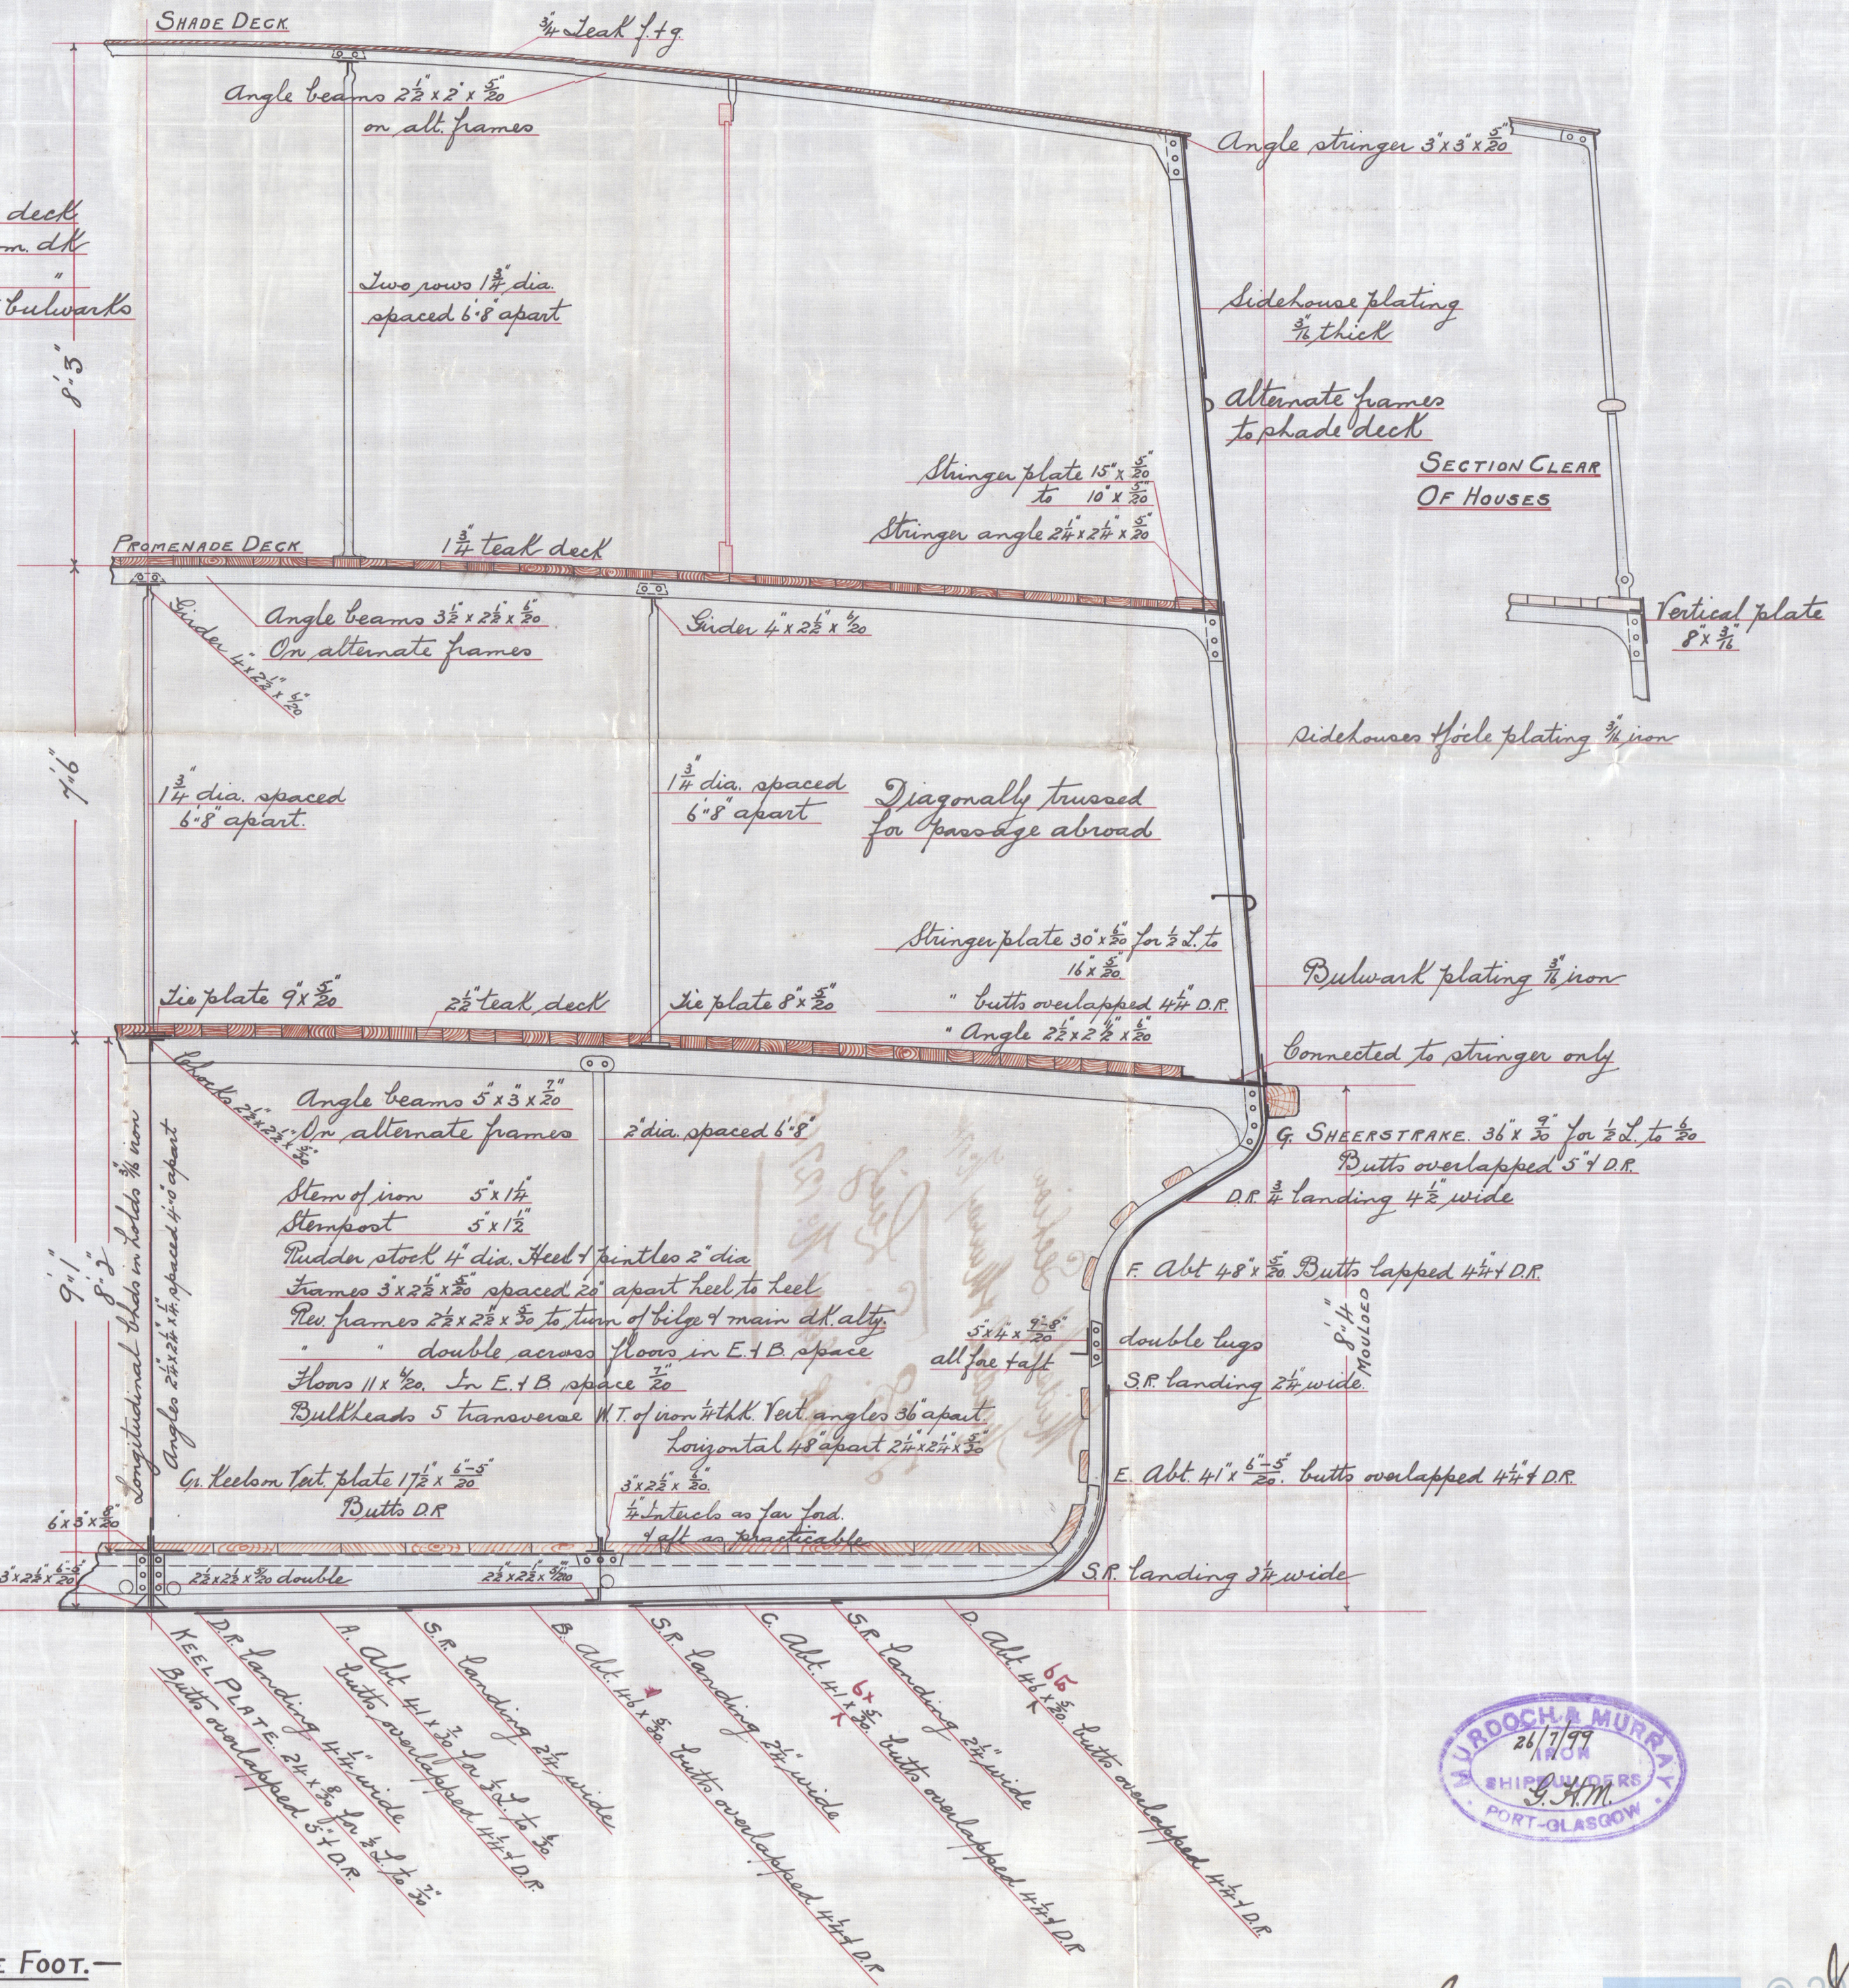

Not filled in.

SECTION OF GR. KEELSON
— IN E. & B. SPACE —

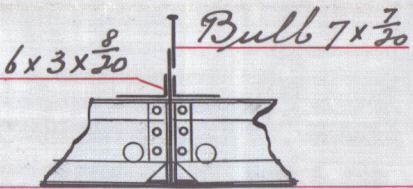

— SCALE 1/2 INCH = ONE FOOT. —
— DRAWING N° 3912. —



J.T.L.
27/7/99

Midship Section
Murdock & Murray No. 174

J. S. Lewis
Clerk Report No. 12715

© 2021

Lloyd's Register
Foundation

-0281