

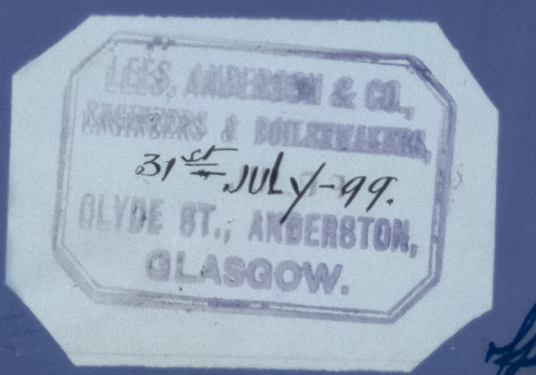


Mr. 8.99

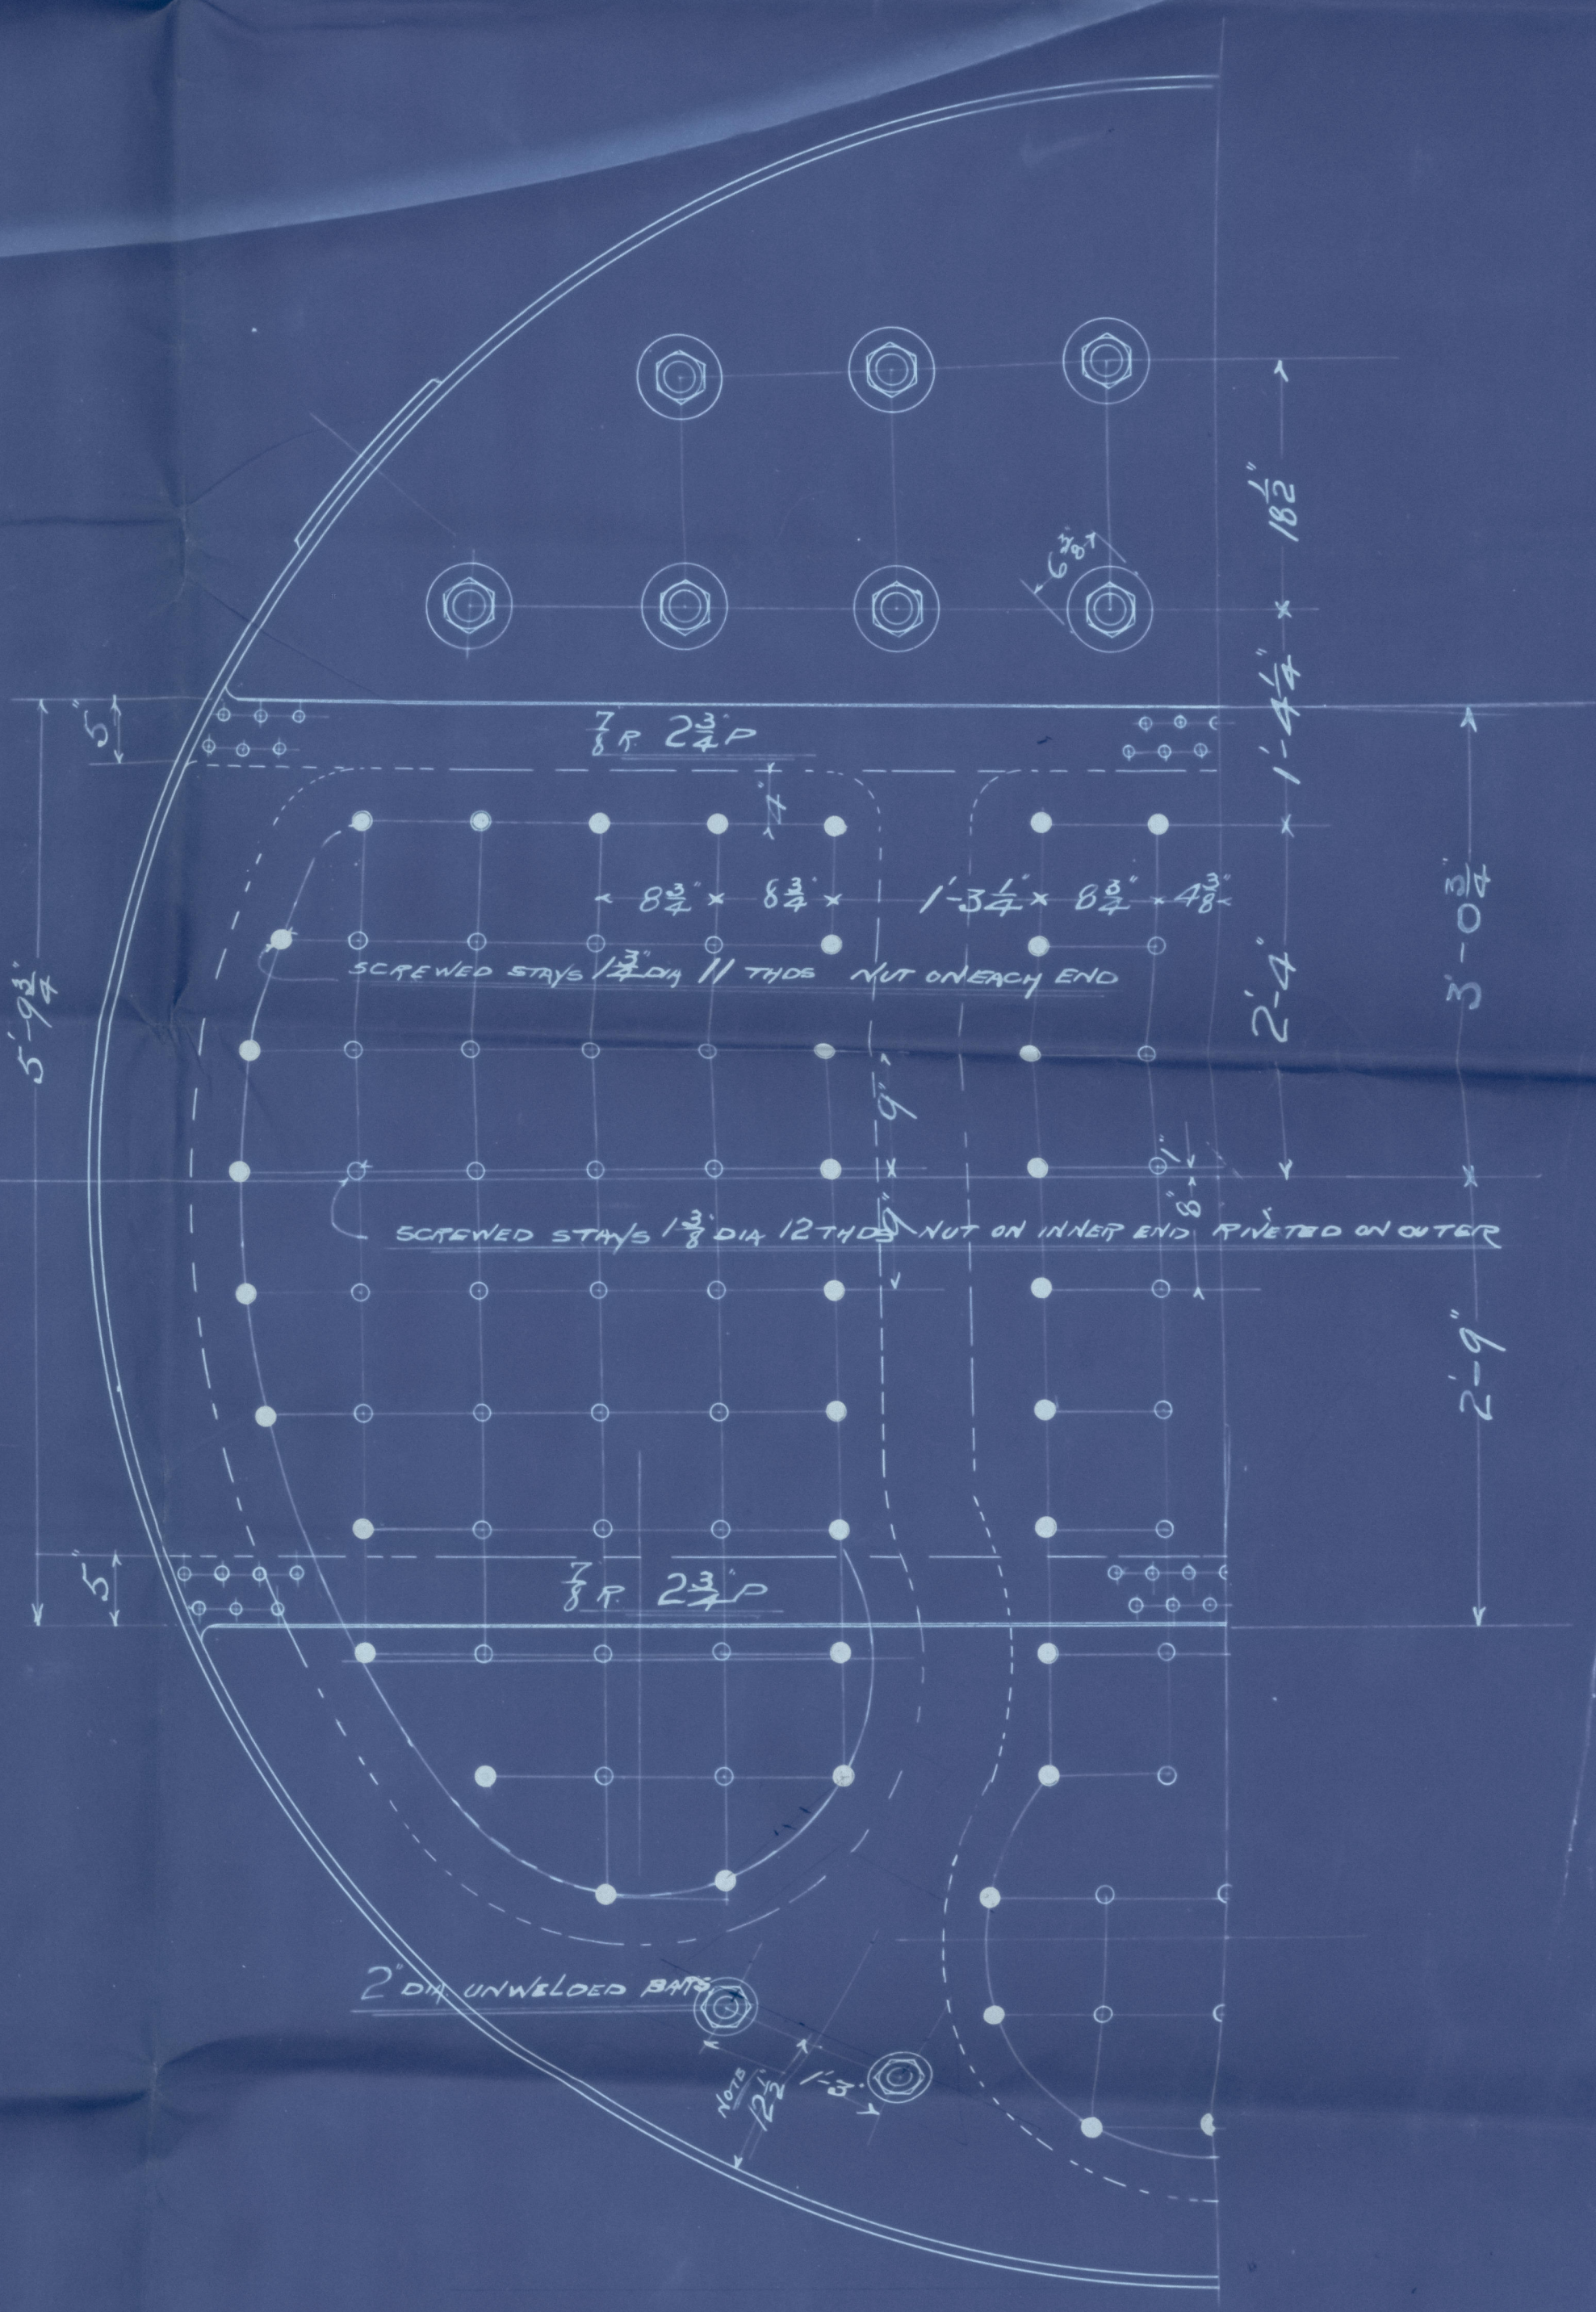

BOILER  
14'-0" DIA x 10'-6"  
1 OFF TO ORDER N° 869 M + M S T.S.S N° 174  
WORKING PRESS 120 LBS — SCALE 1"=1'

21/10/99

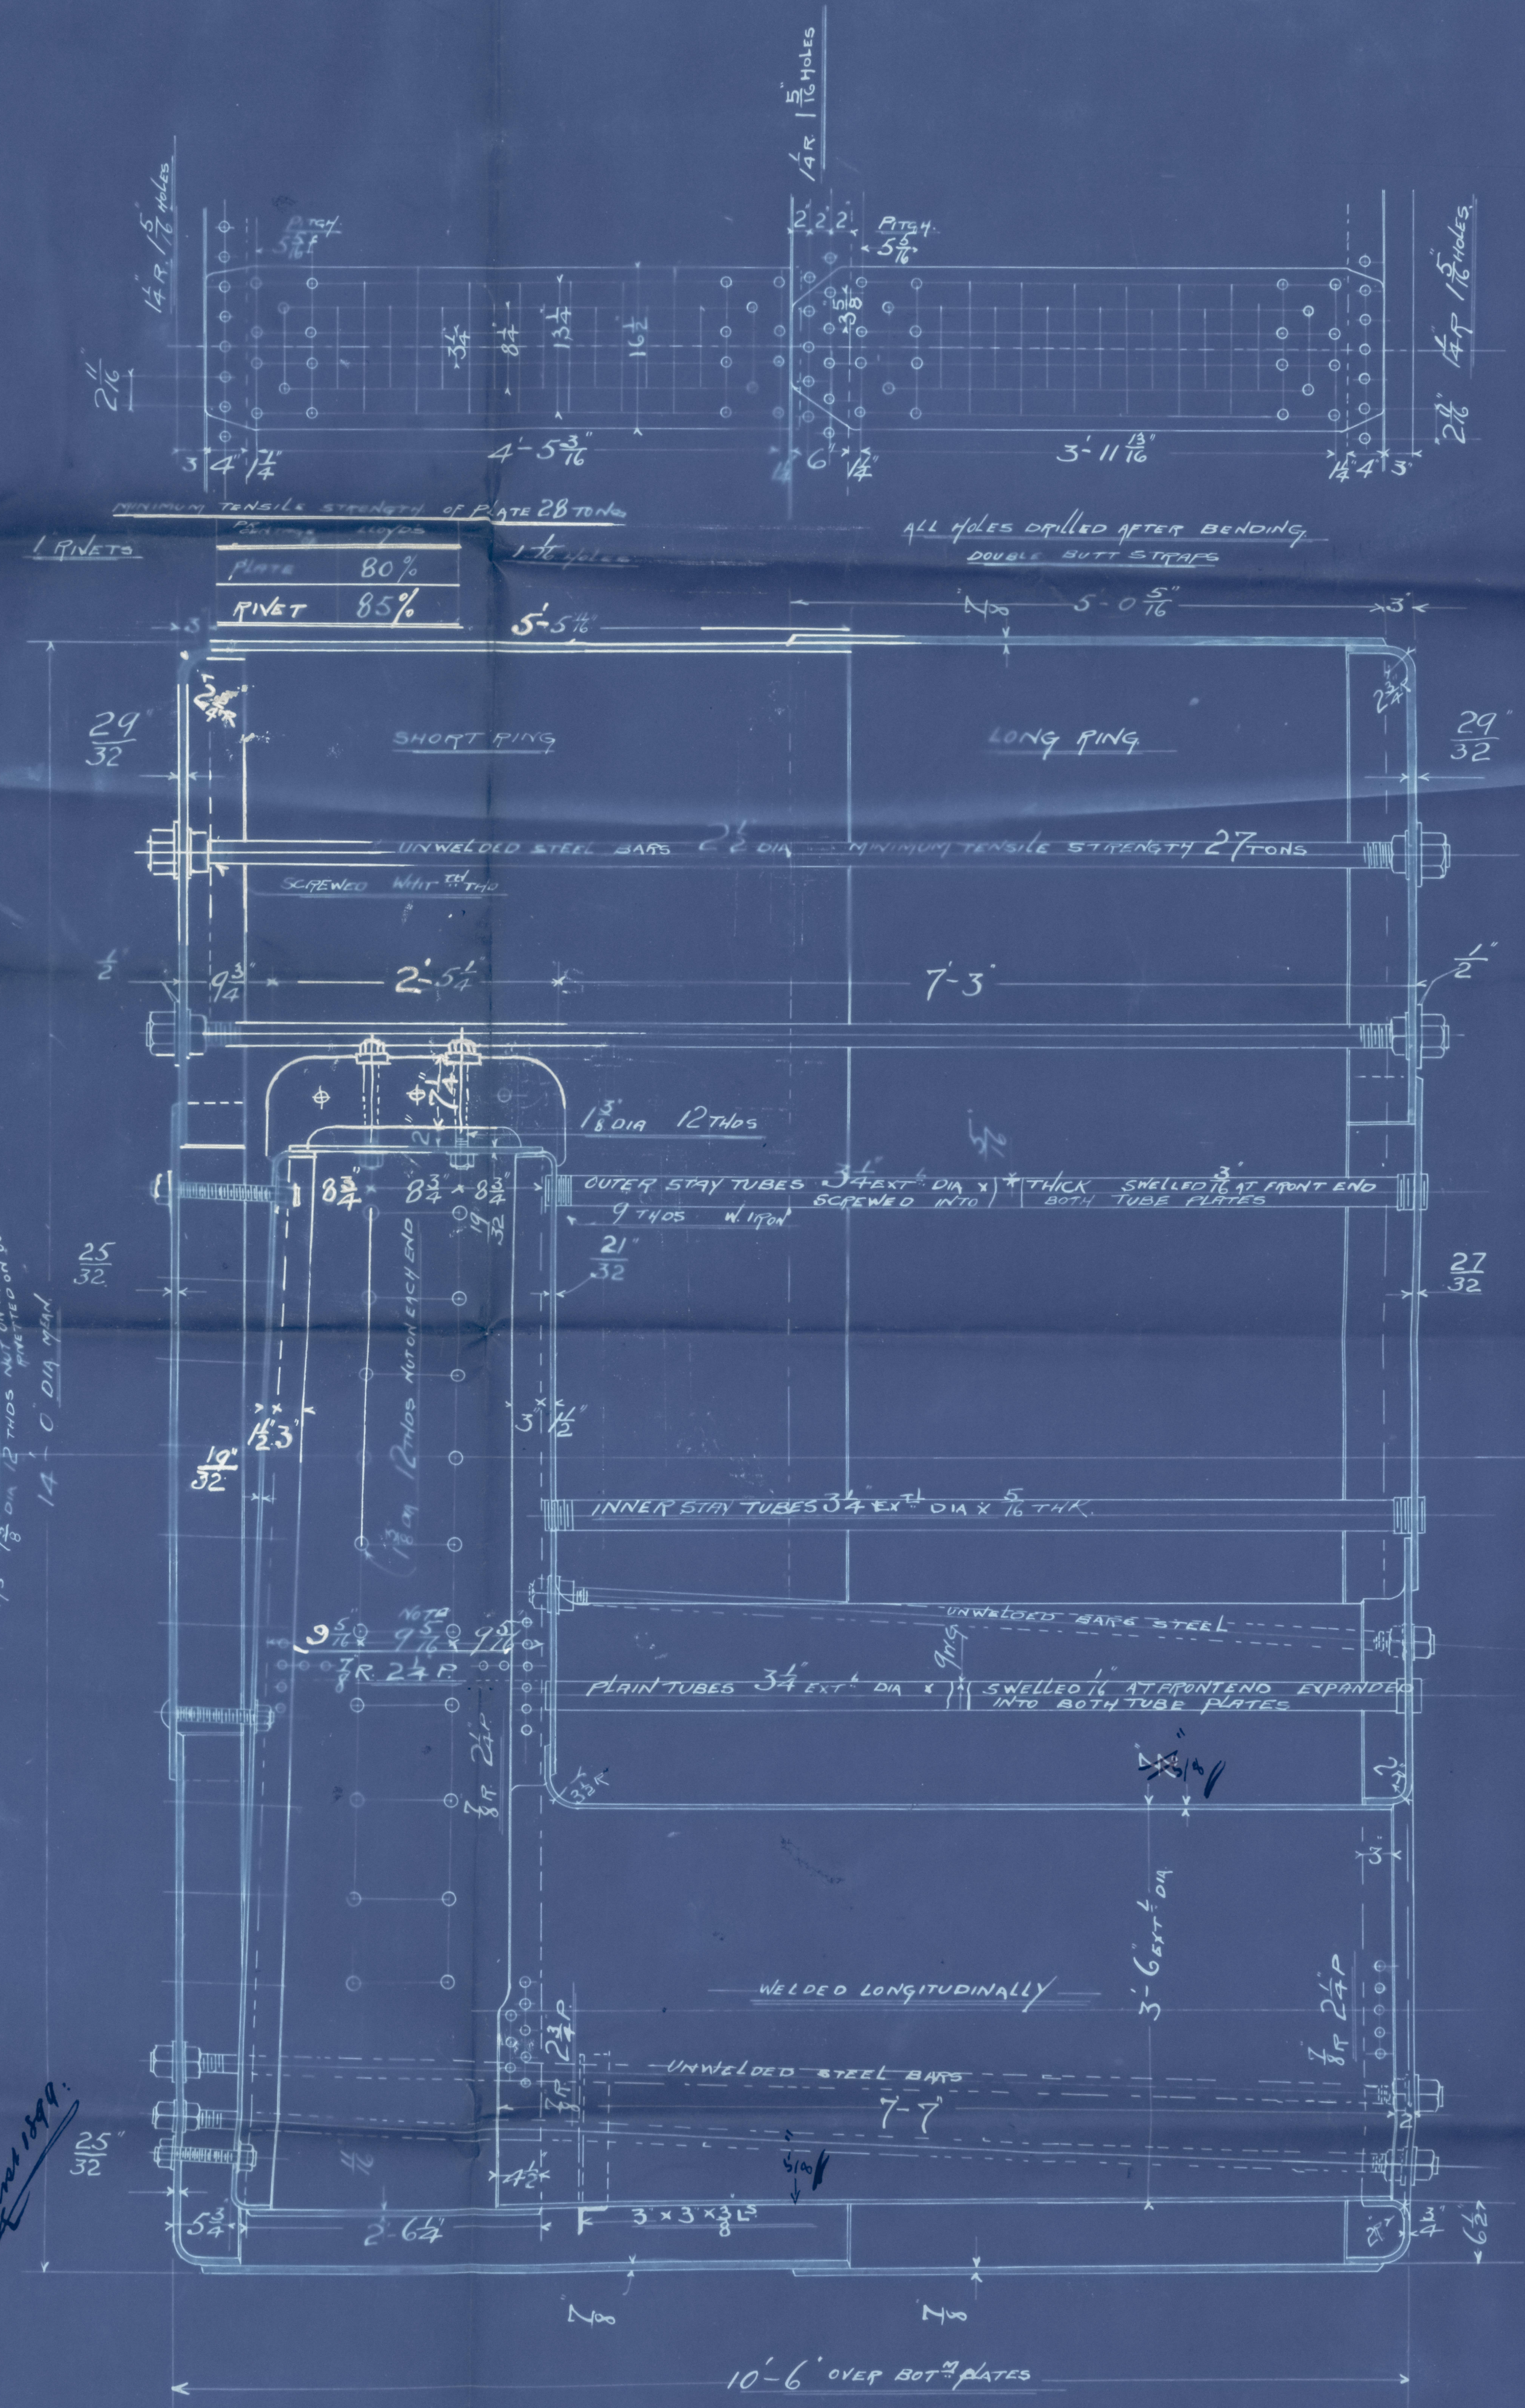



Muel' Stue main Boelii


711 860

Lee Anderson 163

for

Murdoch Murray h: 174½

120 lbs "Upun"

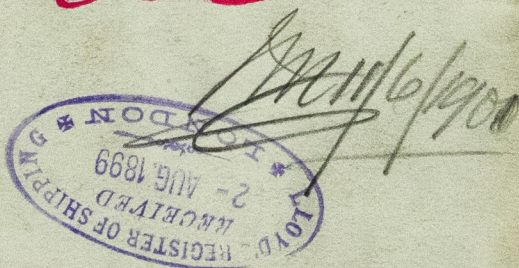

S. S. "S. Luiz"

File Rpt No. 18019

GRK 12715

GRK 351-0283



© 2021

Lloyd's Register  
Foundation