

Kotukui Feb. 1880

It is submitted that Mr Dodd be
requested to state whether the blow
off cocks are filled with a spirit &
brass covering plate, what pipes
are carried through the bunkers &
if any, how are they protected as this
information is not stated on the report.

B.D.

3. 4. 00

L.S.

3. 7. 00




© 2019

Lloyd's Register
Foundation

GRK352-0007

ing pressure of furnace by ... combustion chamber plates: Material *steel* Thickness: Sides

Pitch of stays to ditto: Sides $8\frac{1}{2} \times 8\frac{1}{2}$ Back $7\frac{1}{2} \times 7\frac{1}{2}$ Top $7\frac{1}{2} \times 7\frac{1}{2}$ If stays are fitted with nuts or riveted heads *Auto*.

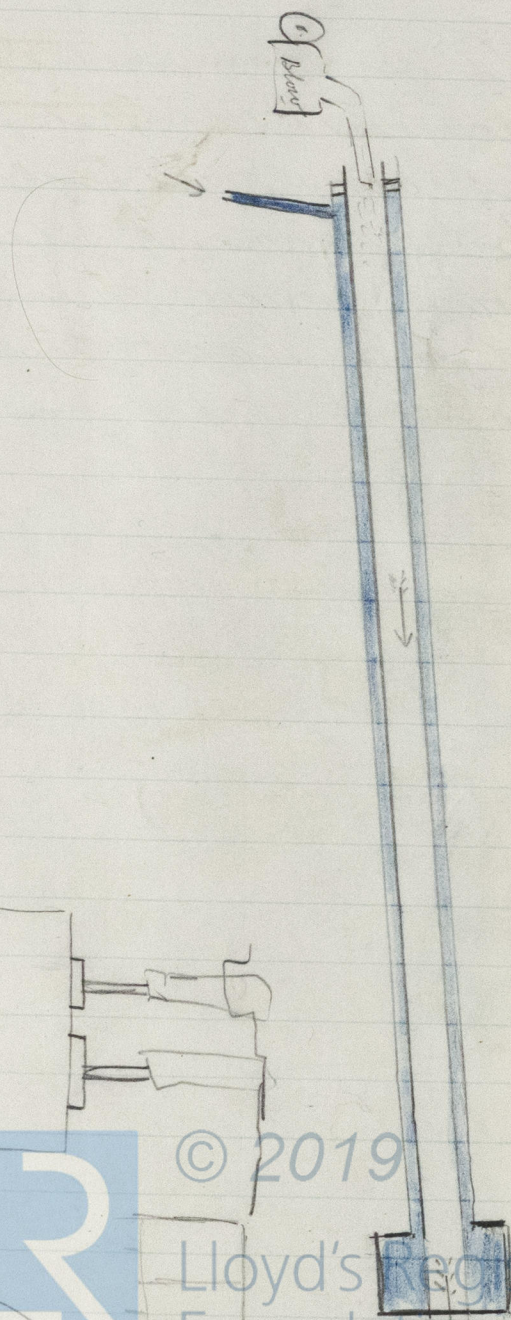

© 2019

Lloyd's Register
Foundation