

Lloyd's Register of British and Foreign Shipping.

(Report on Vessel No. 12731 Port Greenock)

6822 Titled in No 28. (Unclassified) S.S. 'Hokutaka'

No. 6840 SHIP FORGINGS OR CASTINGS.

The words FORGINGS or CASTINGS, IRON or STEEL, should be struck out as may be required.

I have to report that the undermentioned Iron ~~or Steel~~ Forgings ~~or Castings~~,
manufactured by The Irvine Forge Coy
of Irvine for the Vessel No. 30, being built
by Messrs Carmichael & McLean of Greenock
have been inspected by me as set forth below, and found to be, so far as can be seen,
Sound & efficient


Mark on Forgings.

Lloyd's
No. 6840
F.C

Frank Cook. William Hamilton
Glasgow 1/31/99

	STERN FRAME.	RUDDER FRAME.	STEM.
Material*	<u>Scrap iron</u>		
How made	<u>Forged</u>		
Dimensions	<u>7 1/2 x 14 3/4</u>		
Progress on Inspection	<u>Forging & smithing</u>		
Date when Inspected	<u>26/12/98 to 23/2/99</u>		

SKETCHES OF FRAMES SHOWING POSITION AND DESCRIPTION OF WELDS OF FORGINGS, OR PARTICULARS OF TESTS APPLIED TO CASTINGS.

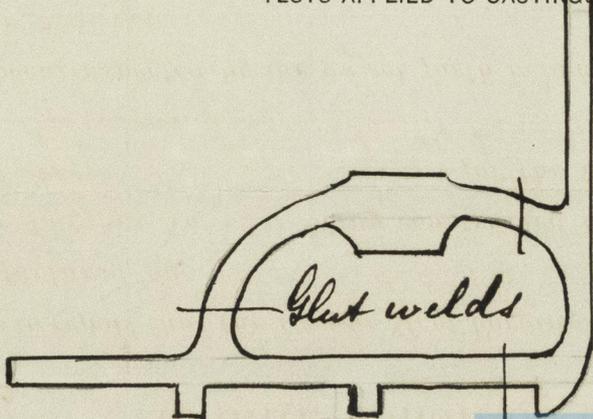

Fee (if any chargeable) £ : :

To be paid at