

Received at Greenock Office, 7th April 1900.

Lloyd's Register of British and Foreign Shipping.

(Report on Vessel No. 12731 Port Greenock)
Rudder fitted in No. 28 (Unclassed) L.S. 'Koduku'

No. 6822 SHIP FORGINGS OR CASTINGS.

I have to report that the undermentioned Iron or Steel Forgings or Castings,
 manufactured by The Irvine Forge Coy
 of Irvine for the Vessel No. 39, being built
 by Mess Carmichael & McLean of Greenock
 have been inspected by me as set forth below, and found to be, so far as can be seen,
Sound & efficient


Mark on Forgings.

Lloyd's
 No. 6840
W.H

William Hamilton
Glasgow

	STERN FRAME.	RUDDER FRAME.	STEM.
Material*	Scrap iron	Scrap iron	
How made	Forged	Forged	
Dimensions	5 1/2 to 14 1/4 x 3 1/8	8 1/2 to 2 1/2 to 4 x 2 3/8	
Progress on Inspection	Forging & smithing	Forging	
Date when Inspected	10/11/99 to 28/3/00	24. 27/3/99	

SKETCHES OF FRAMES SHOWING POSITION AND DESCRIPTION OF WELDS OF FORGINGS, OR PARTICULARS OF TESTS APPLIED TO CASTINGS.

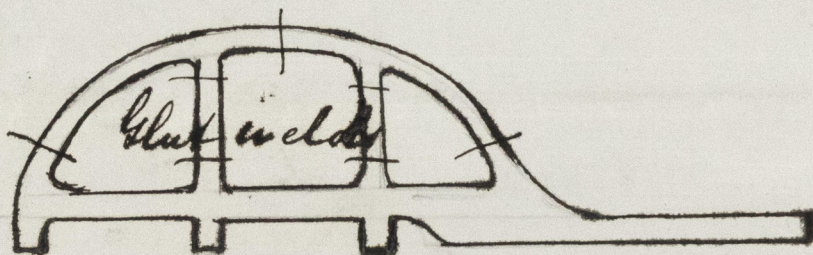

Fee (if any chargeable) £ : :

To be paid at



© 2019

Lloyd's Register
Foundation