

Received at Greenock Office. 11-8-1899

Lloyd's Register of British and Foreign Shipping.

(Report on Vessel No. 12731 Port Greenock)

Greenock

S.S. 'Kohuku'

No. 4095 a. SHIP FORGINGS OR CASTINGS.

The words FORGINGS or CASTINGS, IRON or STEEL, should be struck out as may be required.

I have to report that the undermentioned Iron or Steel Forgings or Castings, manufactured by The Wreath Quay Forge Co. of Sunderland for the Vessel No. 30, being built by Mp^r. Carmichael Maclean & Co. of Greenock have been inspected by me as set forth below, and found to be, so far as can be seen, sound



Mark on Forgings.

Lloyd's
No. 4095 a.
N.B.

Wm Cameron
Sunderland
10/8/99


	STERN FRAME.	RUDDER FRAME.	STEM.
Material*	<u>Scrap</u>	<u>Scrap</u>	
How made	<u>Forged</u>	<u>Forged</u>	
Dimensions	<u>7 1/2 x 4 3/4</u>	<u>5 1/2 - 3 1/2</u>	
Progress on Inspection	<u>Forged & Smithed</u>	<u>Forged & Smithed</u>	
Date when Inspected	<u>April 6th to 26/99</u>	<u>May 8th to July 6/99</u>	

SKETCHES OF FRAMES SHOWING POSITION AND DESCRIPTION OF WELDS OF FORGINGS, OR PARTICULARS OF TESTS APPLIED TO CASTINGS.

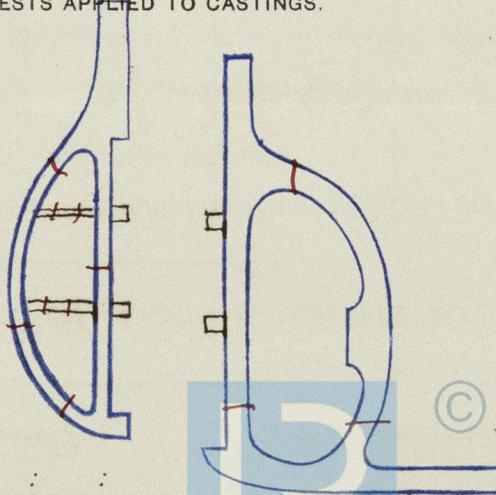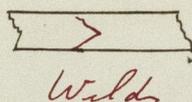

Fee (if any chargeable) £

To be paid at

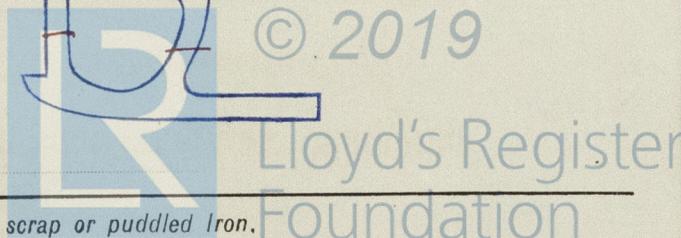




© 2019

Lloyd's Register
Foundation