

base Steel Sternpost.


S. S. No. 459-60-1

Scale 1" = 1' Foot

Sternpost to be rivet hole bored with holes 1 3/16" spaced 5 5/8" cr. to cr.

Boes to be rivet hole bored.

Vessel to be classed at Lloyd's 100 A.I. 5th Steel.

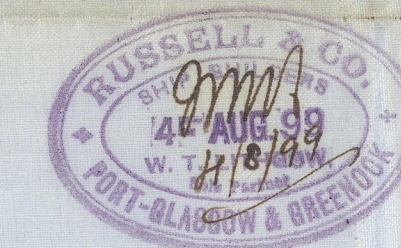



Plan of Cast Steel  
Stern frame  
Russell & Co. No. 459, 460, 461

No. 459: S.S. "Amstelland"  
Grk report No. 12764

No. 460: S.S. "Zaanland"  
Grk report No. 12833

No. 461: S.S. "Rijnsland"  
Grk report No. 12871

1-00-924 GRK 352-0081

No. 461 = "1" class

No. 461 = "1" class

Lloyd's Register  
Foundation