


Corner
Landing

11. 12. 99

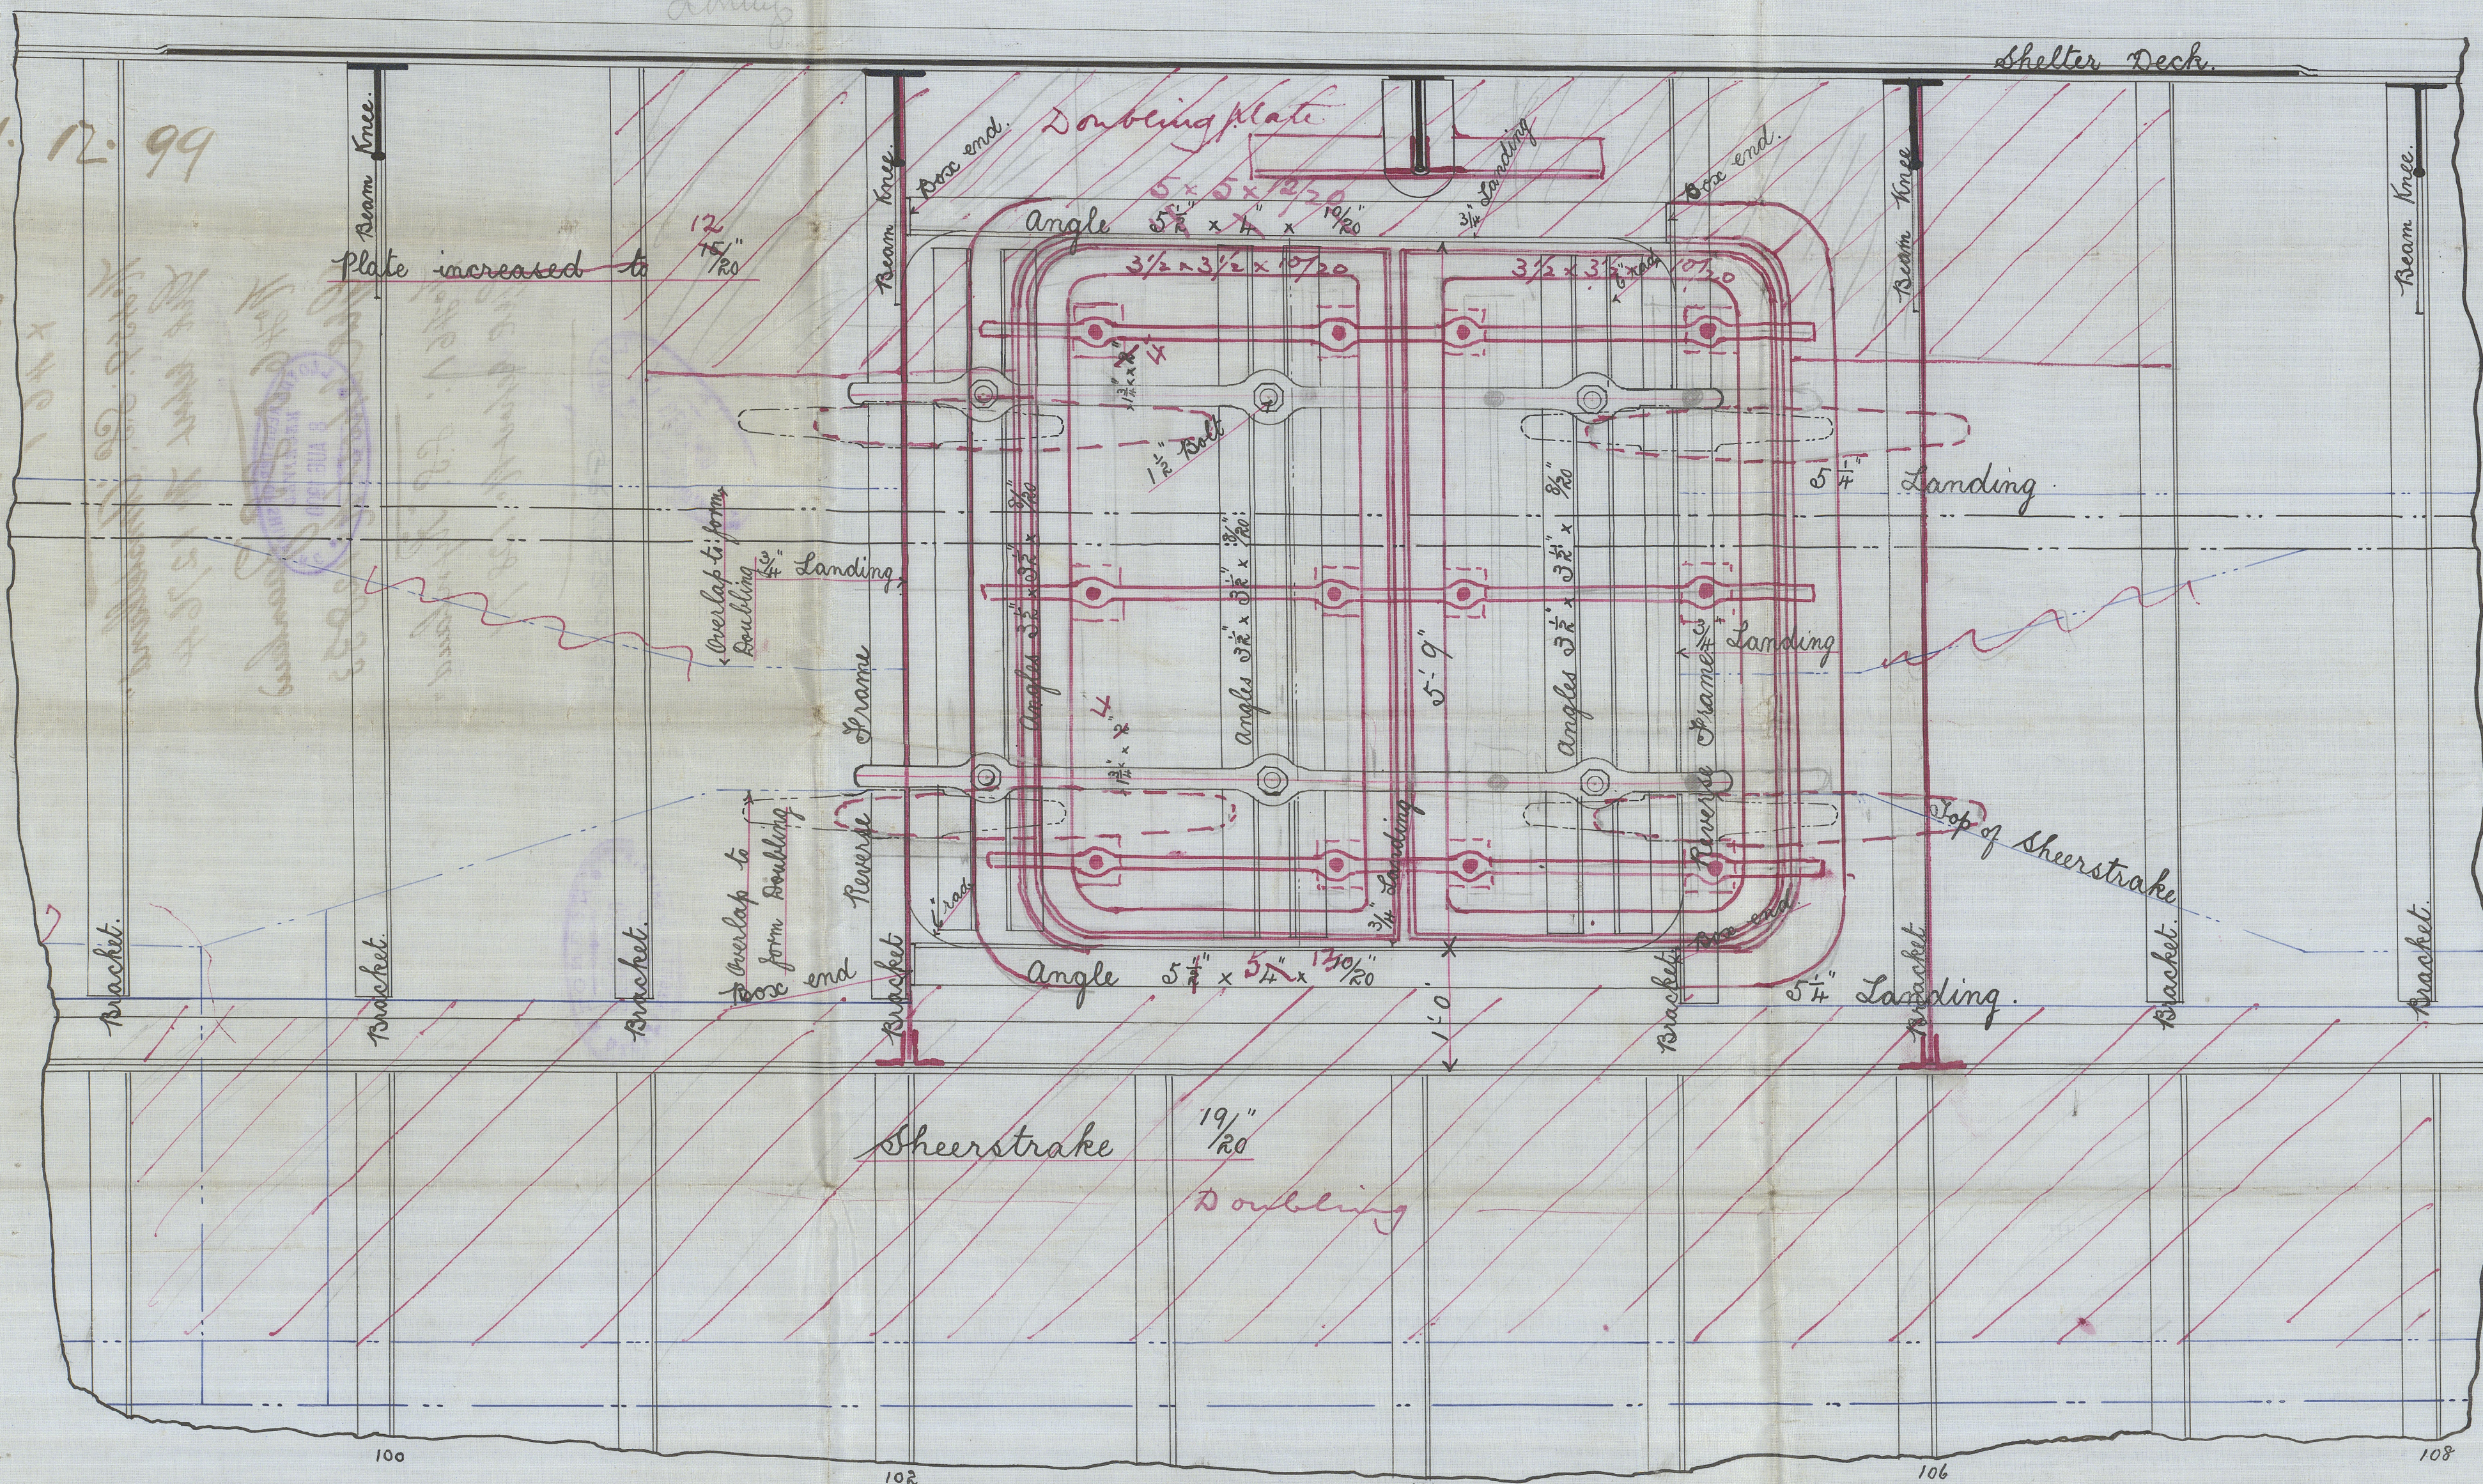

Longitudinal Section


Coaling Door Port & Starboard

S. S. Nos 459 - 60 - 61


Scale One inch = One foot.



11/12/99

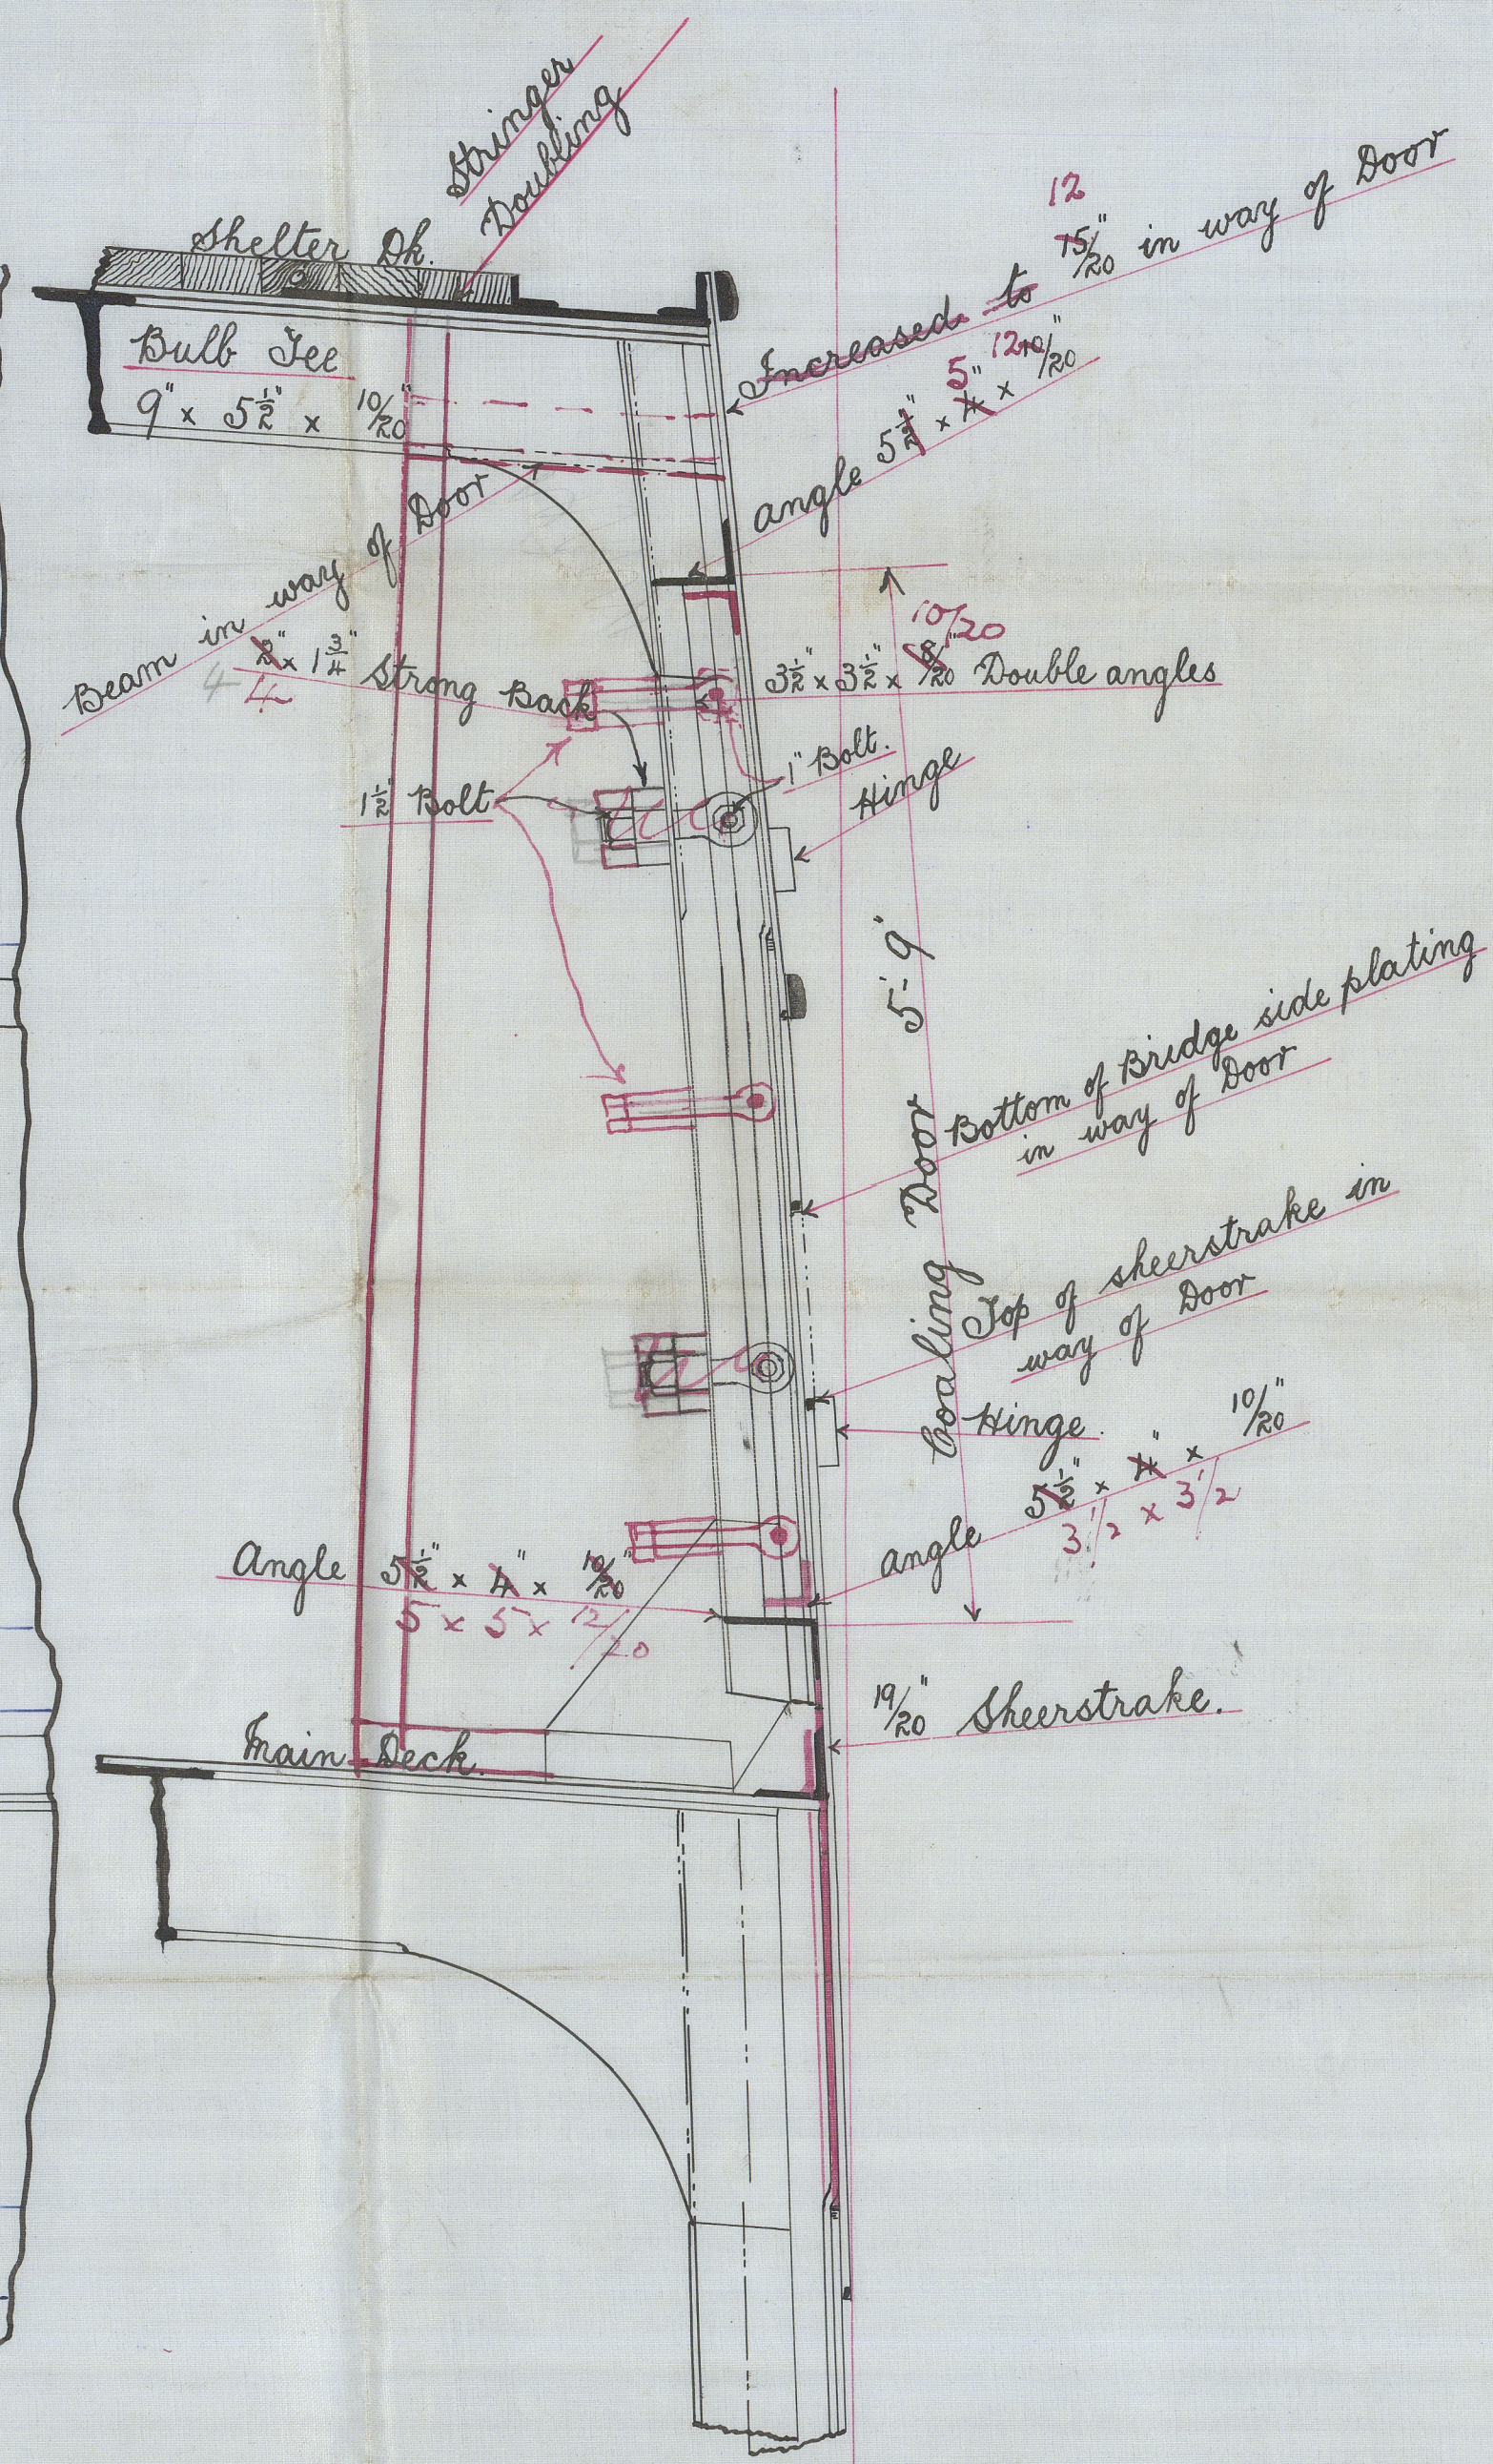

Transverse Section.

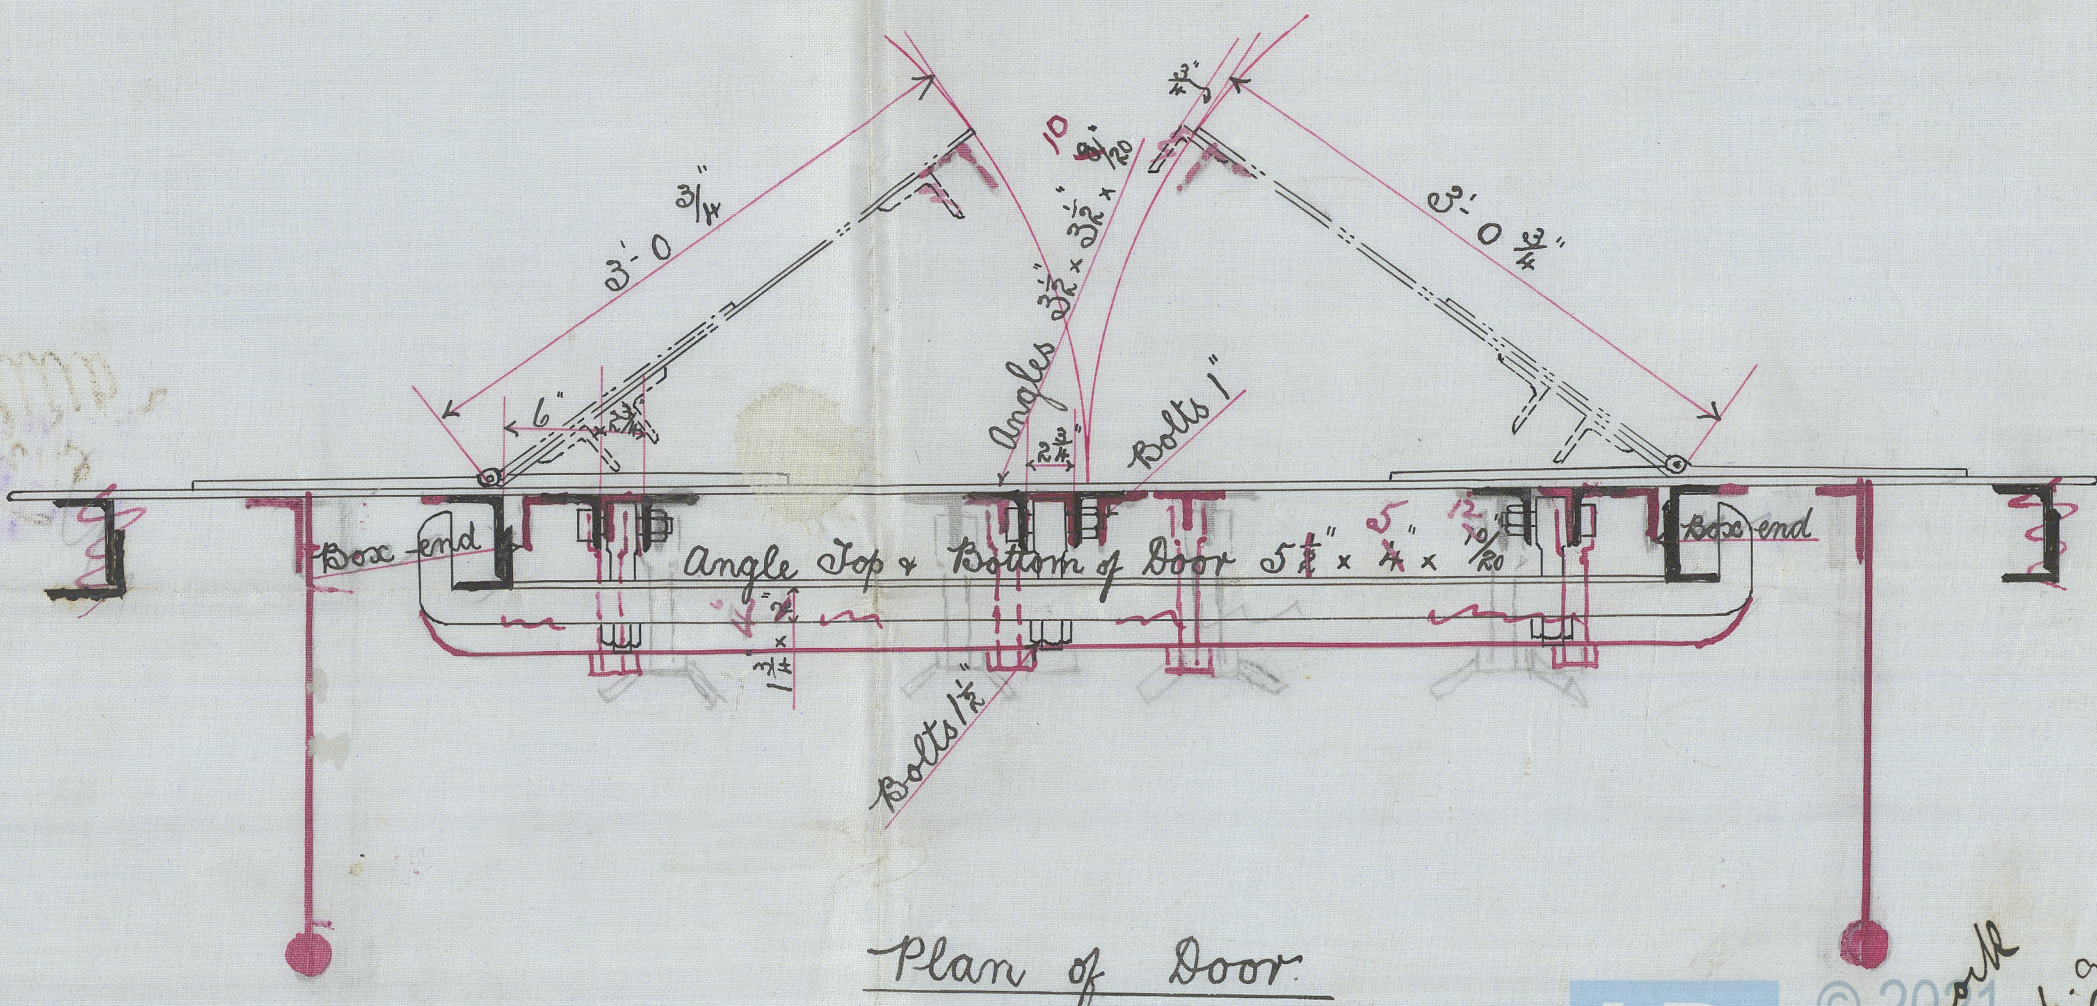

Plan of Door.

Coaling Doors

Russell & Co No 459, 460,

+ 461

No 459: S.S. "Amstelland"

Grk report No 12764

No 460: S.S. "Zaanland"

Grk report No 12833

No 461: S.S. "Rynland"

Grk report No 12871

GRK 352-0085

