
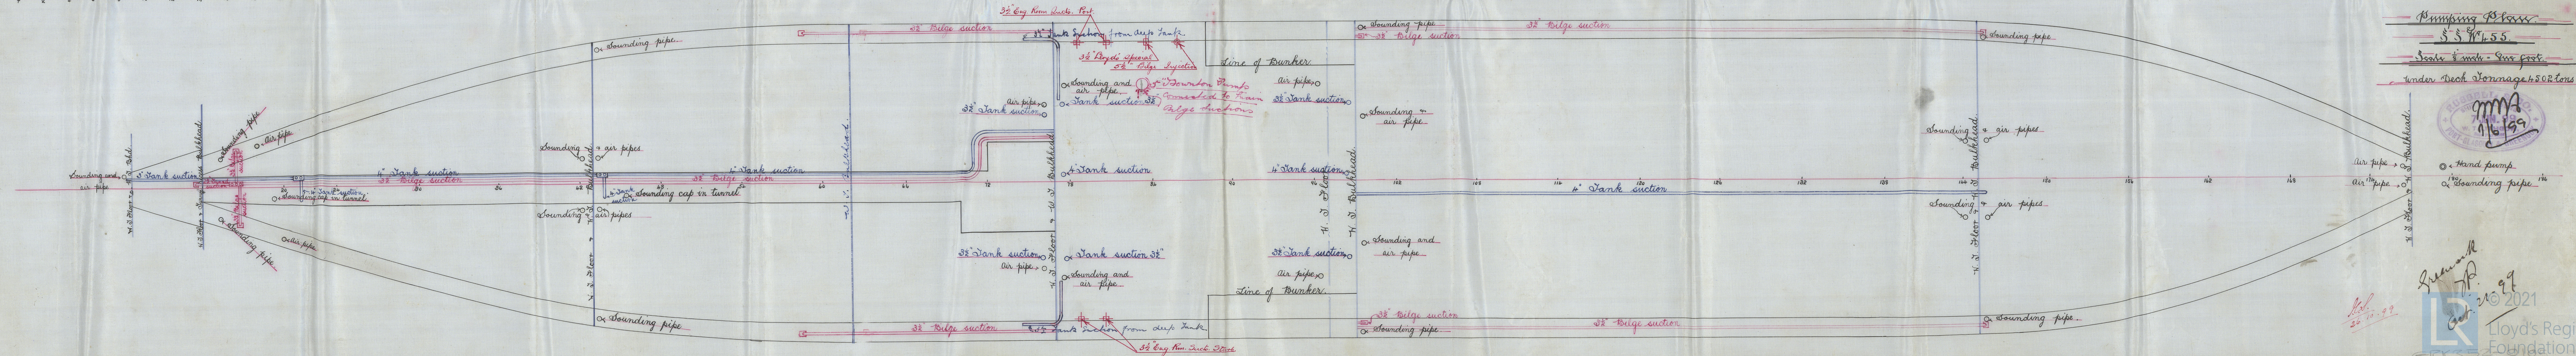


24: 10: 99

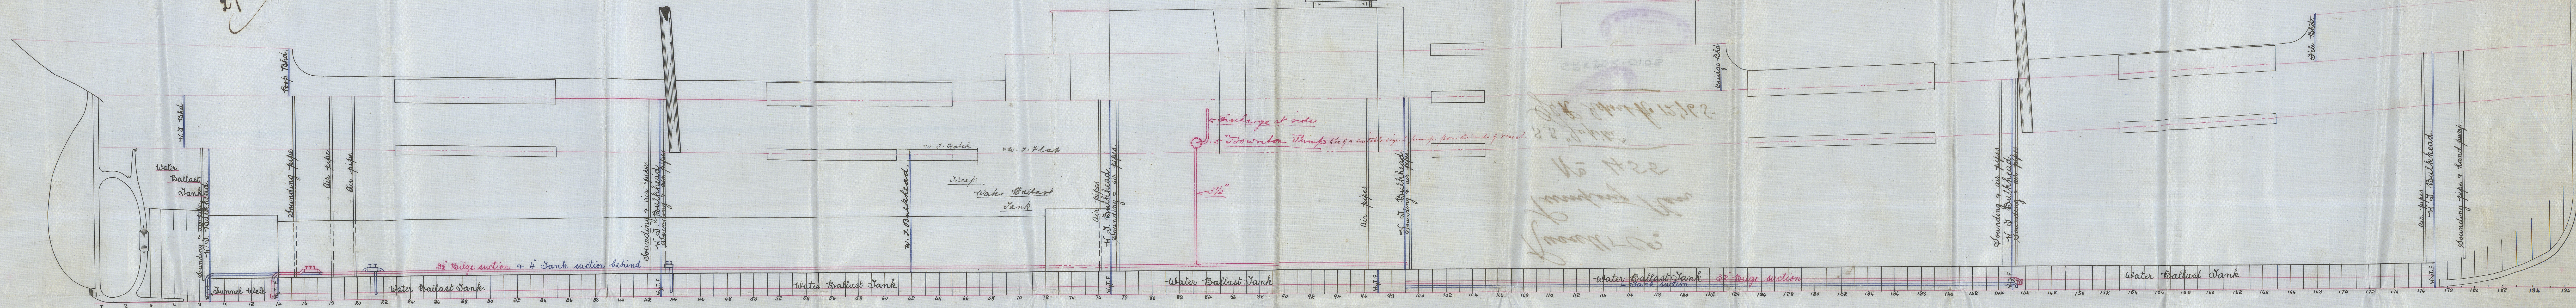

Scale  $\frac{1}{2}$  inch = one foot.  
under Deck Lonnage 4502 tons

7 JUN 69  
1/6/99

◎  $\leftarrow$  Hand pump  
 ○  $\overset{180}{\leftarrow}$  Sounding pipe

Greenwell  
H. 97  
Lloyd's  
Found.  
GRK 552-106



Russell & Co.  
Pumping Plan  
No 455


GRK352-0105



© 2021

Lloyd's Register  
Foundation