


10" Dia. M'haschen Patent Coupled Rudder
for Messrs Russell & Co's S.S. N^o 455

155

10" Dia

14-2

8-3" Bolts

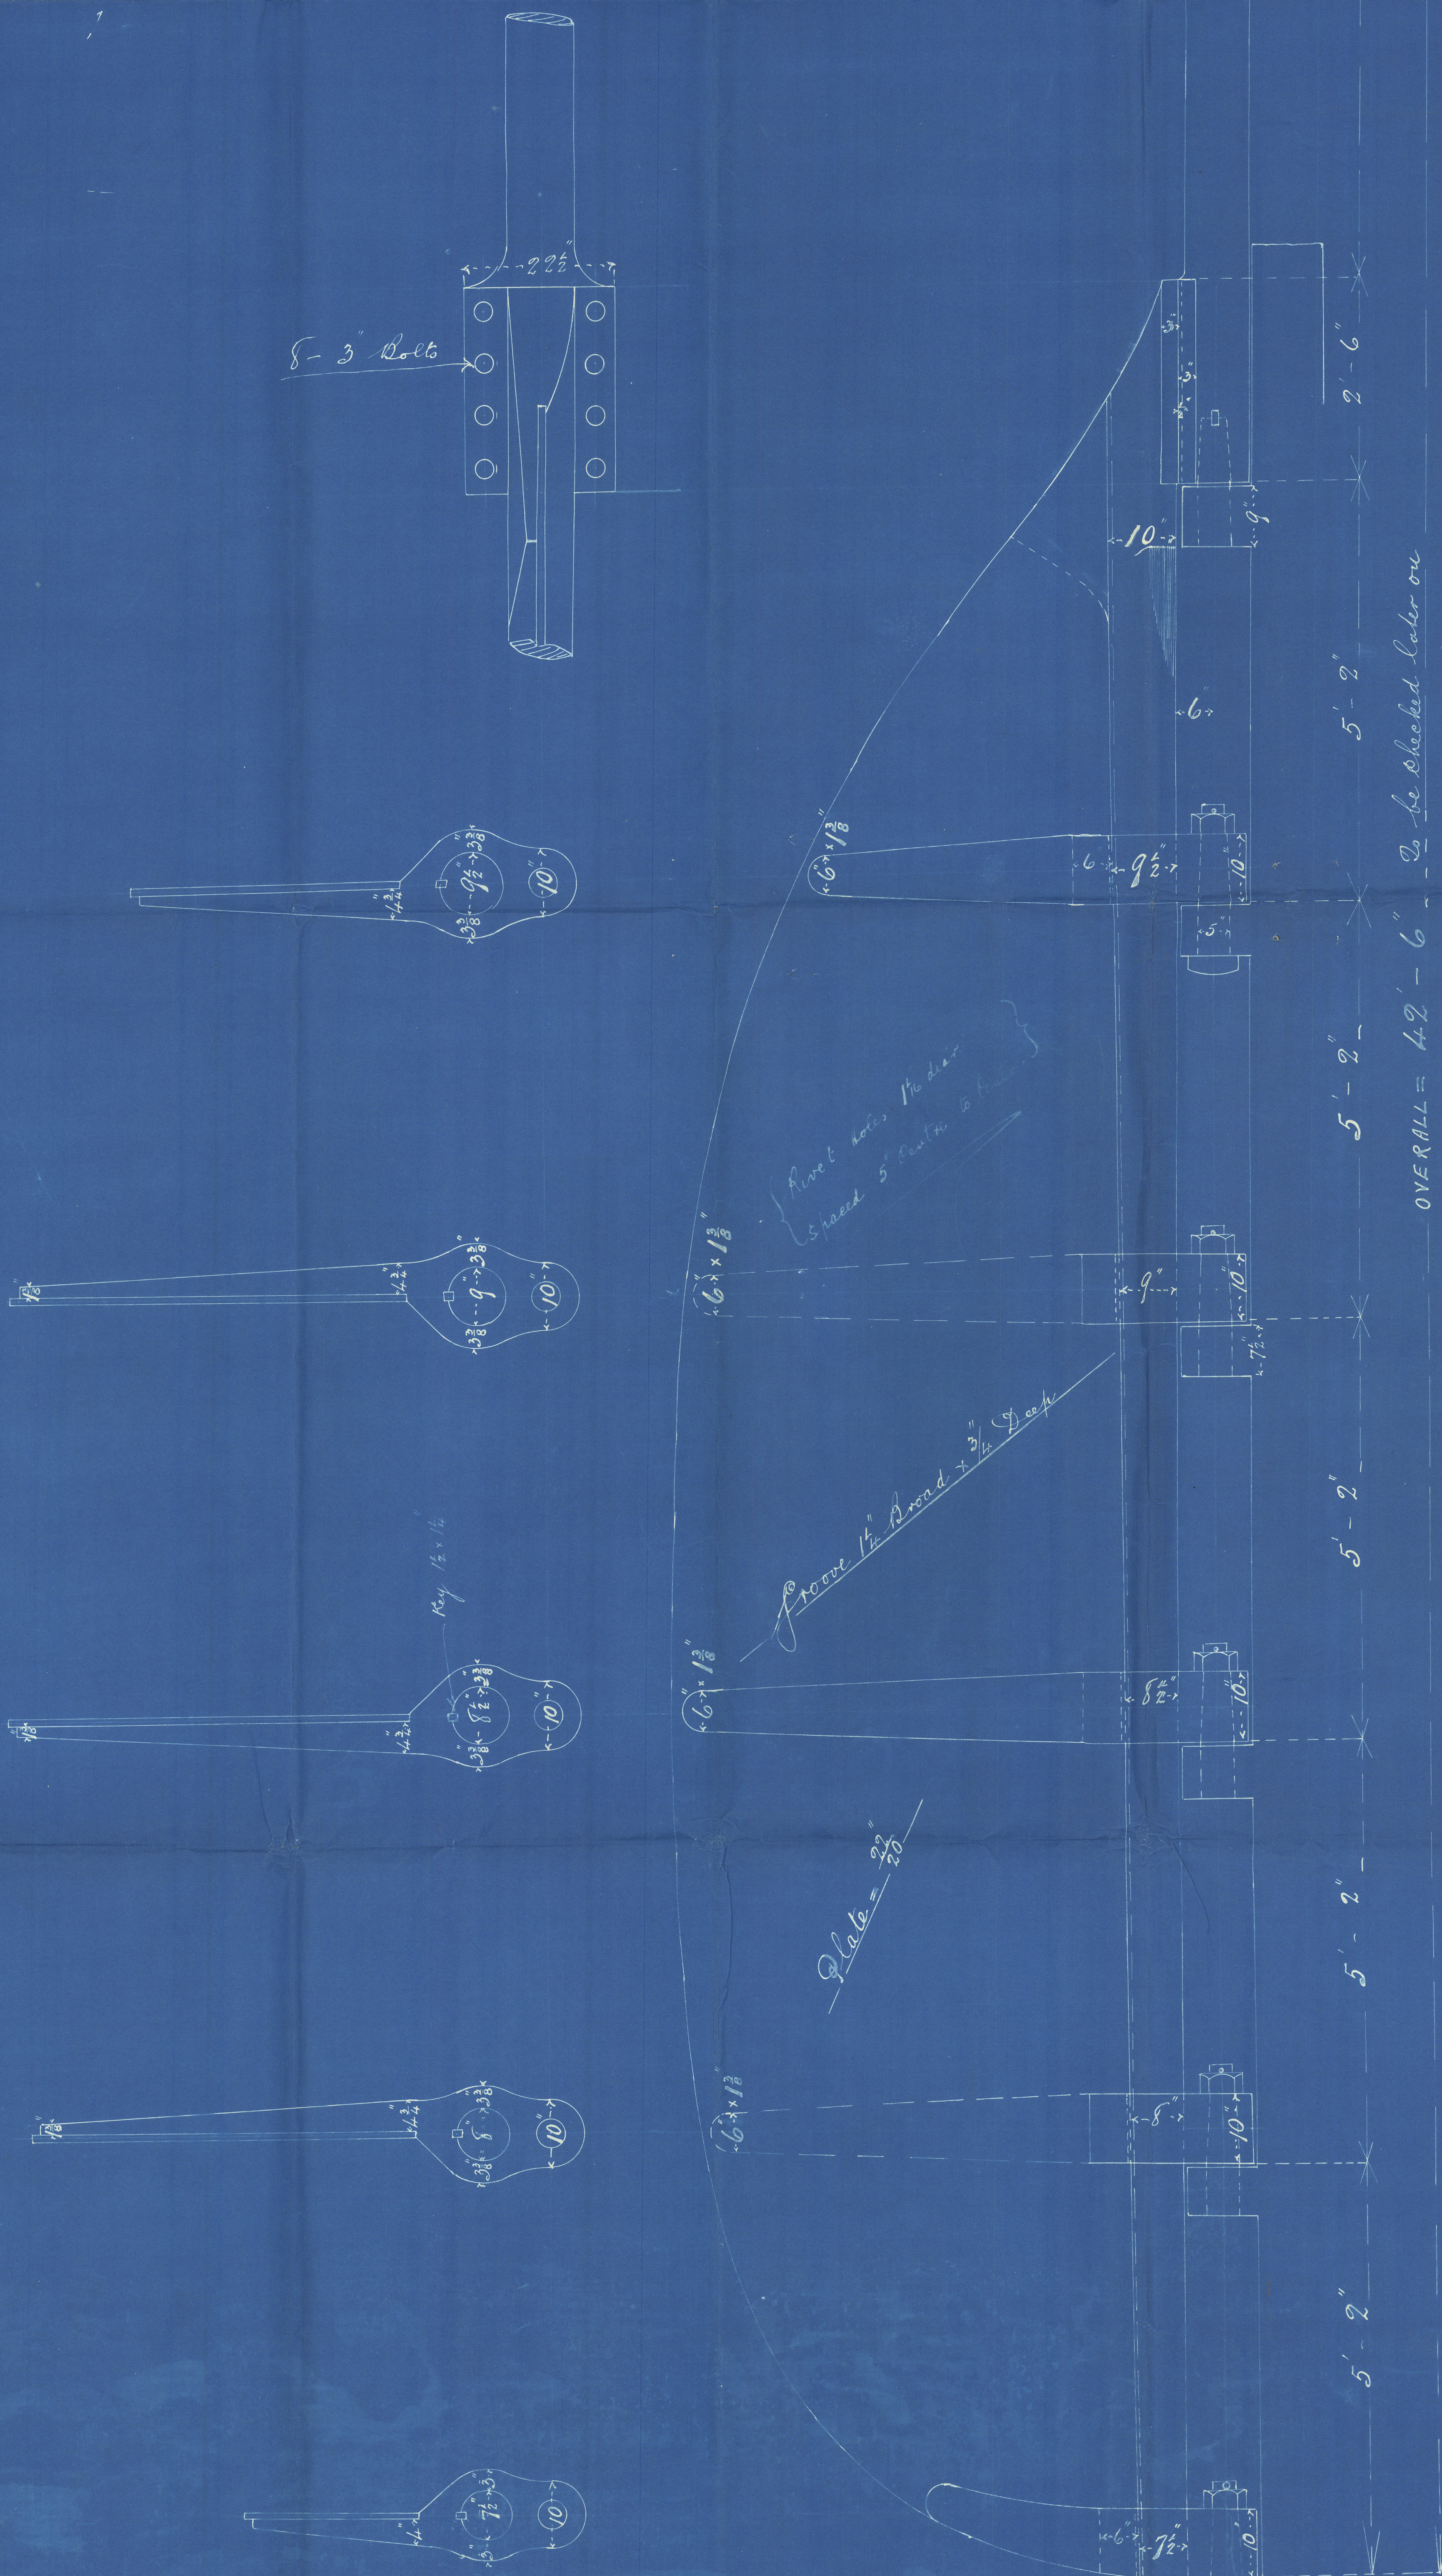

OVERALL = 42' - 6" To be checked later on



© 2021
Lloyd's Register
Foundation

GRK352-0107

455 Rudder plane

Plan of Rudder

Russell & Co No 455-

S.S. "Jupiter"
Grk Report No. 12765



GRK 352-0107



© 2021

Lloyd's Register
Foundation