


28.6.00
 SHIPPING
 LONDON

Amended

BOTTOM END PLATES AND MANHOLE DOORS
 N° 220.

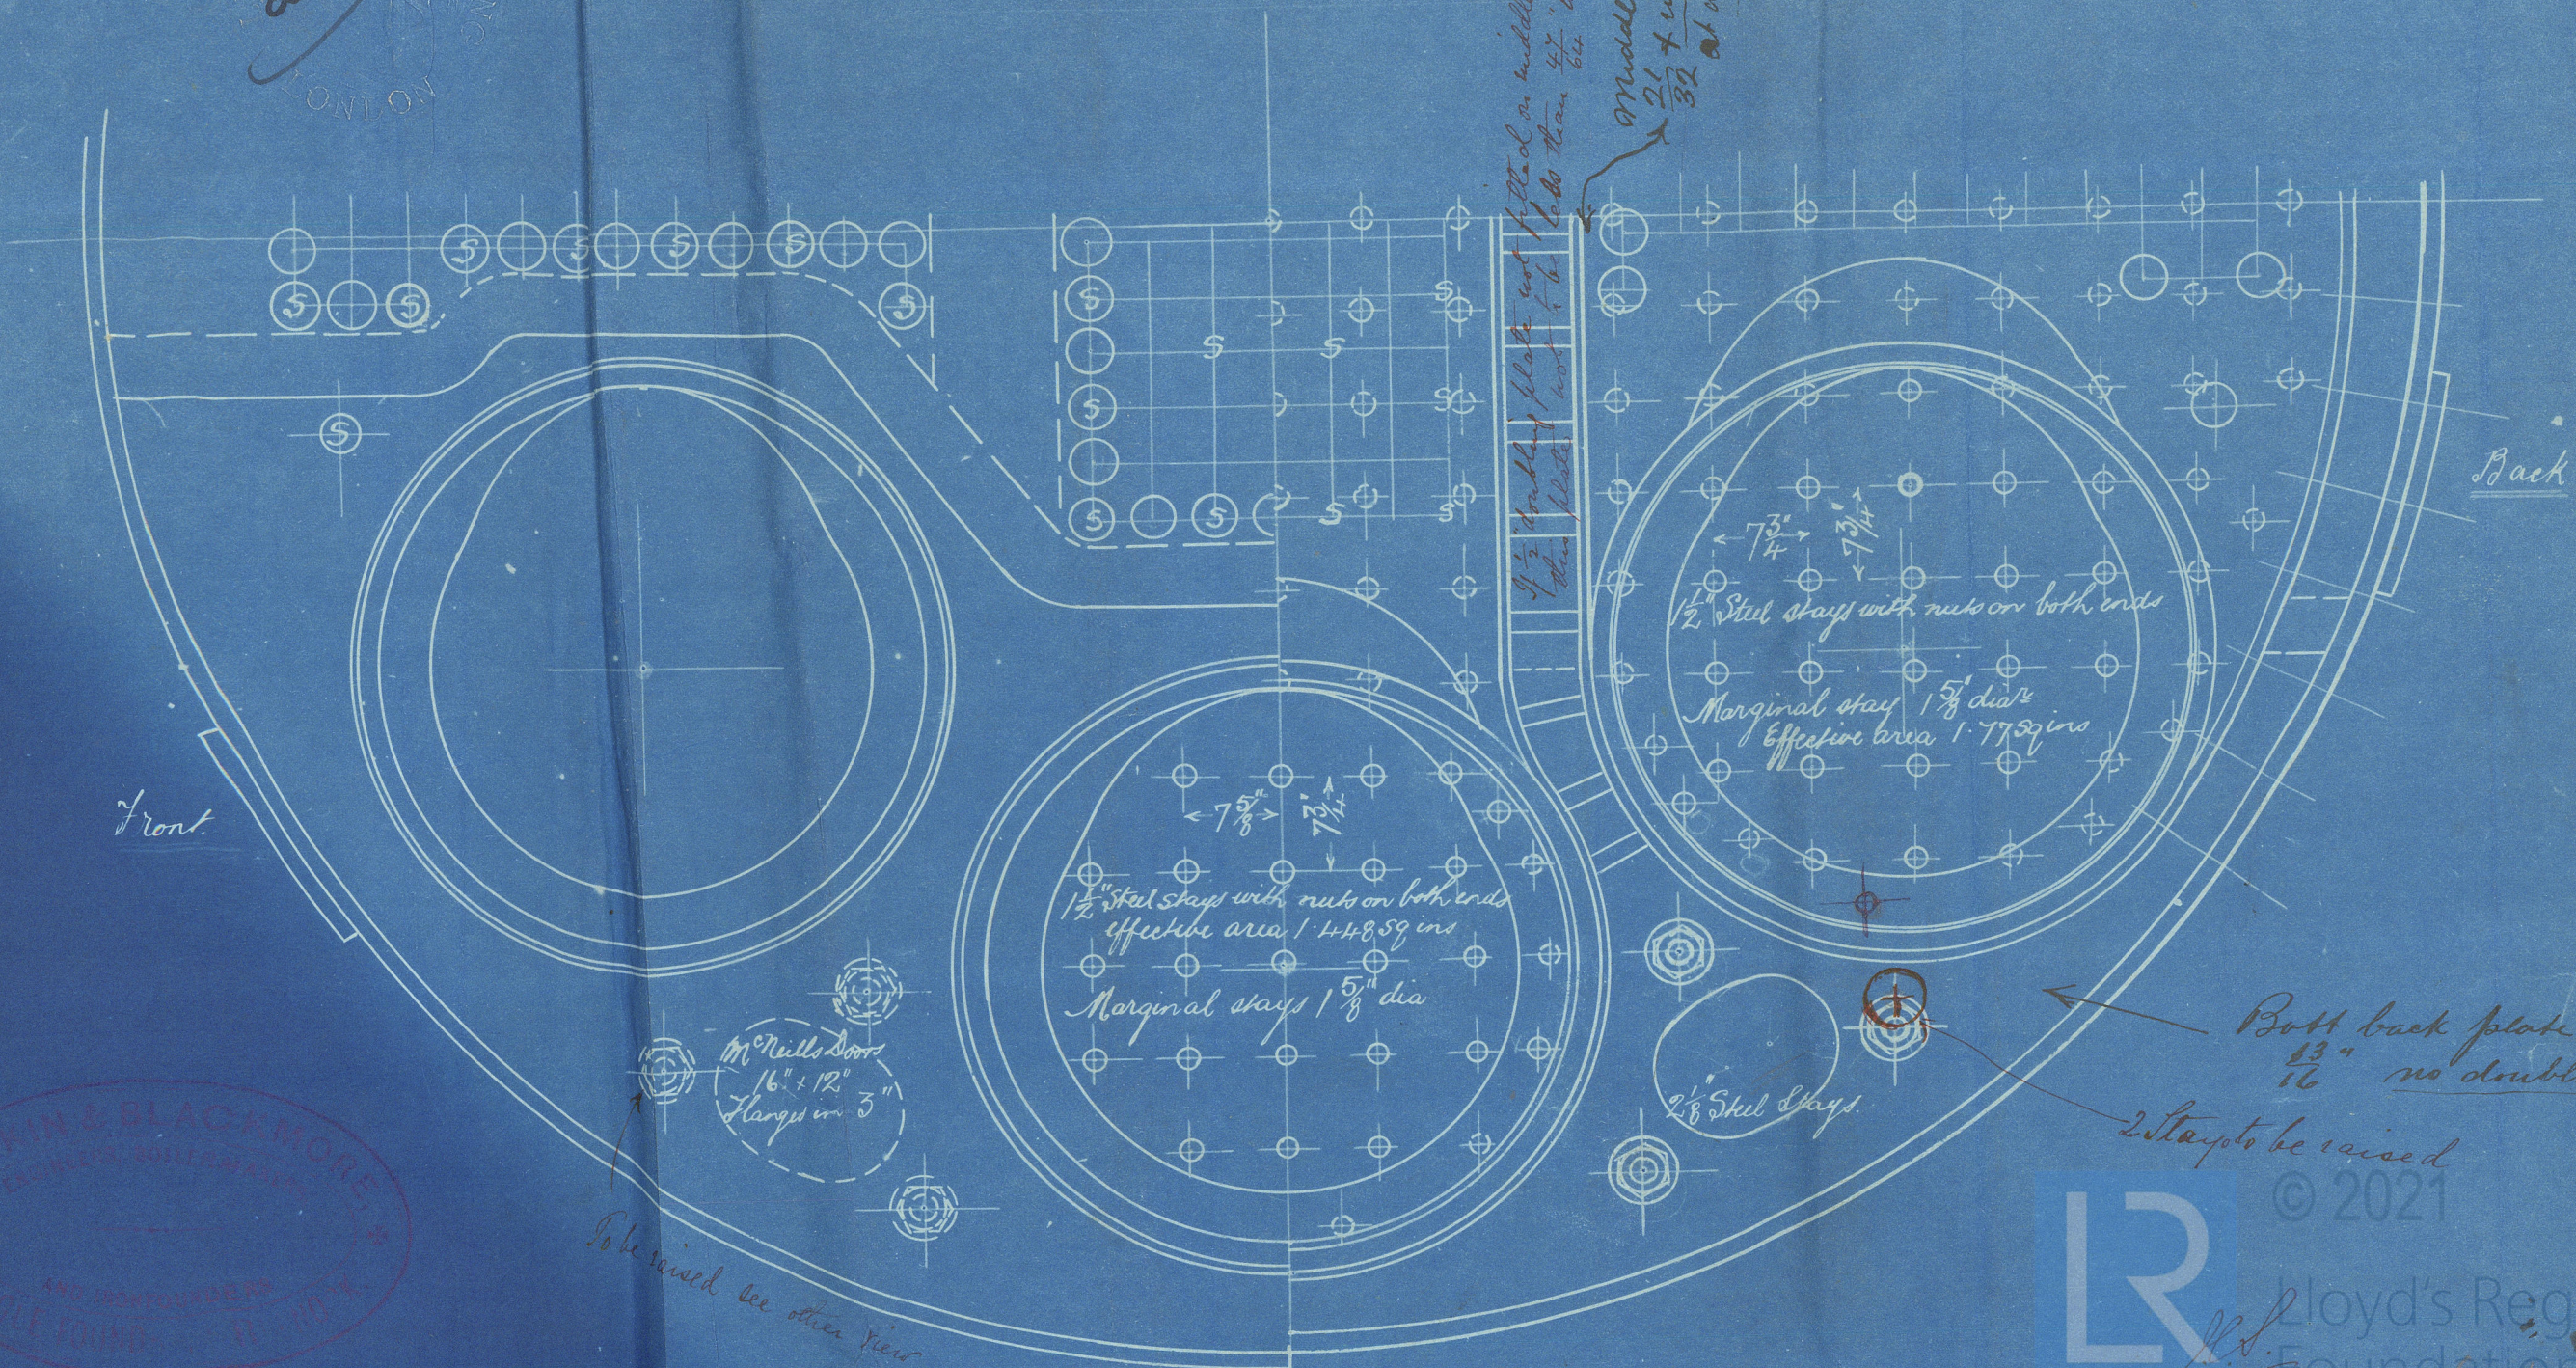

RANKIN & BLACKMORE
 ENGINEERS

© 2021
 Lloyd's Register
 Foundation

GRK352-0174

Nos 218272 220. Two off. for each vessel

Strength of shell plates & butt straps 29 to 32 tons


HANKIN & BLACKMORE,
ENGINEERS & FOUNDERS
SAULT STEAMBOAT
GREENOCK.

Tracing of Boilers for
Rankin & Blackmore's E.218+220

S.S. "Emilia"
GRK report No 12785



S.S. "Marianne"
GRK report No 12846

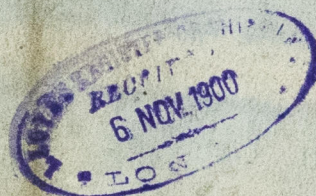

GRK352-0174



© 2021

Lloyd's Register
Foundation