

Received at Greenock Office, 14-11- 1897

Lloyd's Register of British and Foreign Shipping.

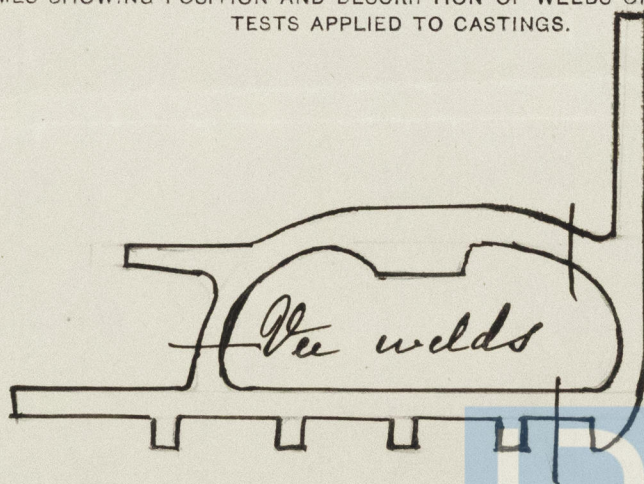
(Report on Vessel No. 12790 Port Greenock)No. 7033SHIP FORGINGS ~~OR CASTINGS~~S.S. Florida

I have to report that the undermentioned ~~Iron or Steel Forgings or Castings~~,
 manufactured by The Portland Forge Coy
 of Kilmarnock for the Vessel No. 457, being built
 by Mess Russell & Coy of Port Glasgow
 have been inspected by me as set forth below, and found to be, so far as can be seen,
Sound & efficient

Mark on Forgings.

 Lloyd's
 No. 7033
W. H.
William Hamilton
Glasgow

	STERN FRAME.	RUDDER FRAME.	STEM.
Material*	<u>Scrap iron</u>		
How made	<u>Forged</u>		
Dimensions	<u>11 x 6</u>		
Progress on Inspection	<u>Forging & smithing</u>		
Date when Inspected	<u>22/9/99 to 4/11/99</u>		

 SKETCHES OF FRAMES SHOWING POSITION AND DESCRIPTION OF WELDS OF FORGINGS, OR PARTICULARS OF
 TESTS APPLIED TO CASTINGS.


Fee (if any chargeable) £ : :

To be paid at