


BLR 19.10.28

TENSILE STRENGTH OF SHELL & BUTTS 28 TO 32 TONS

" " STAYS 27 " 32 "




ALL PLATES, BARS, GIRDERS AND RIVETS  
OF STEEL

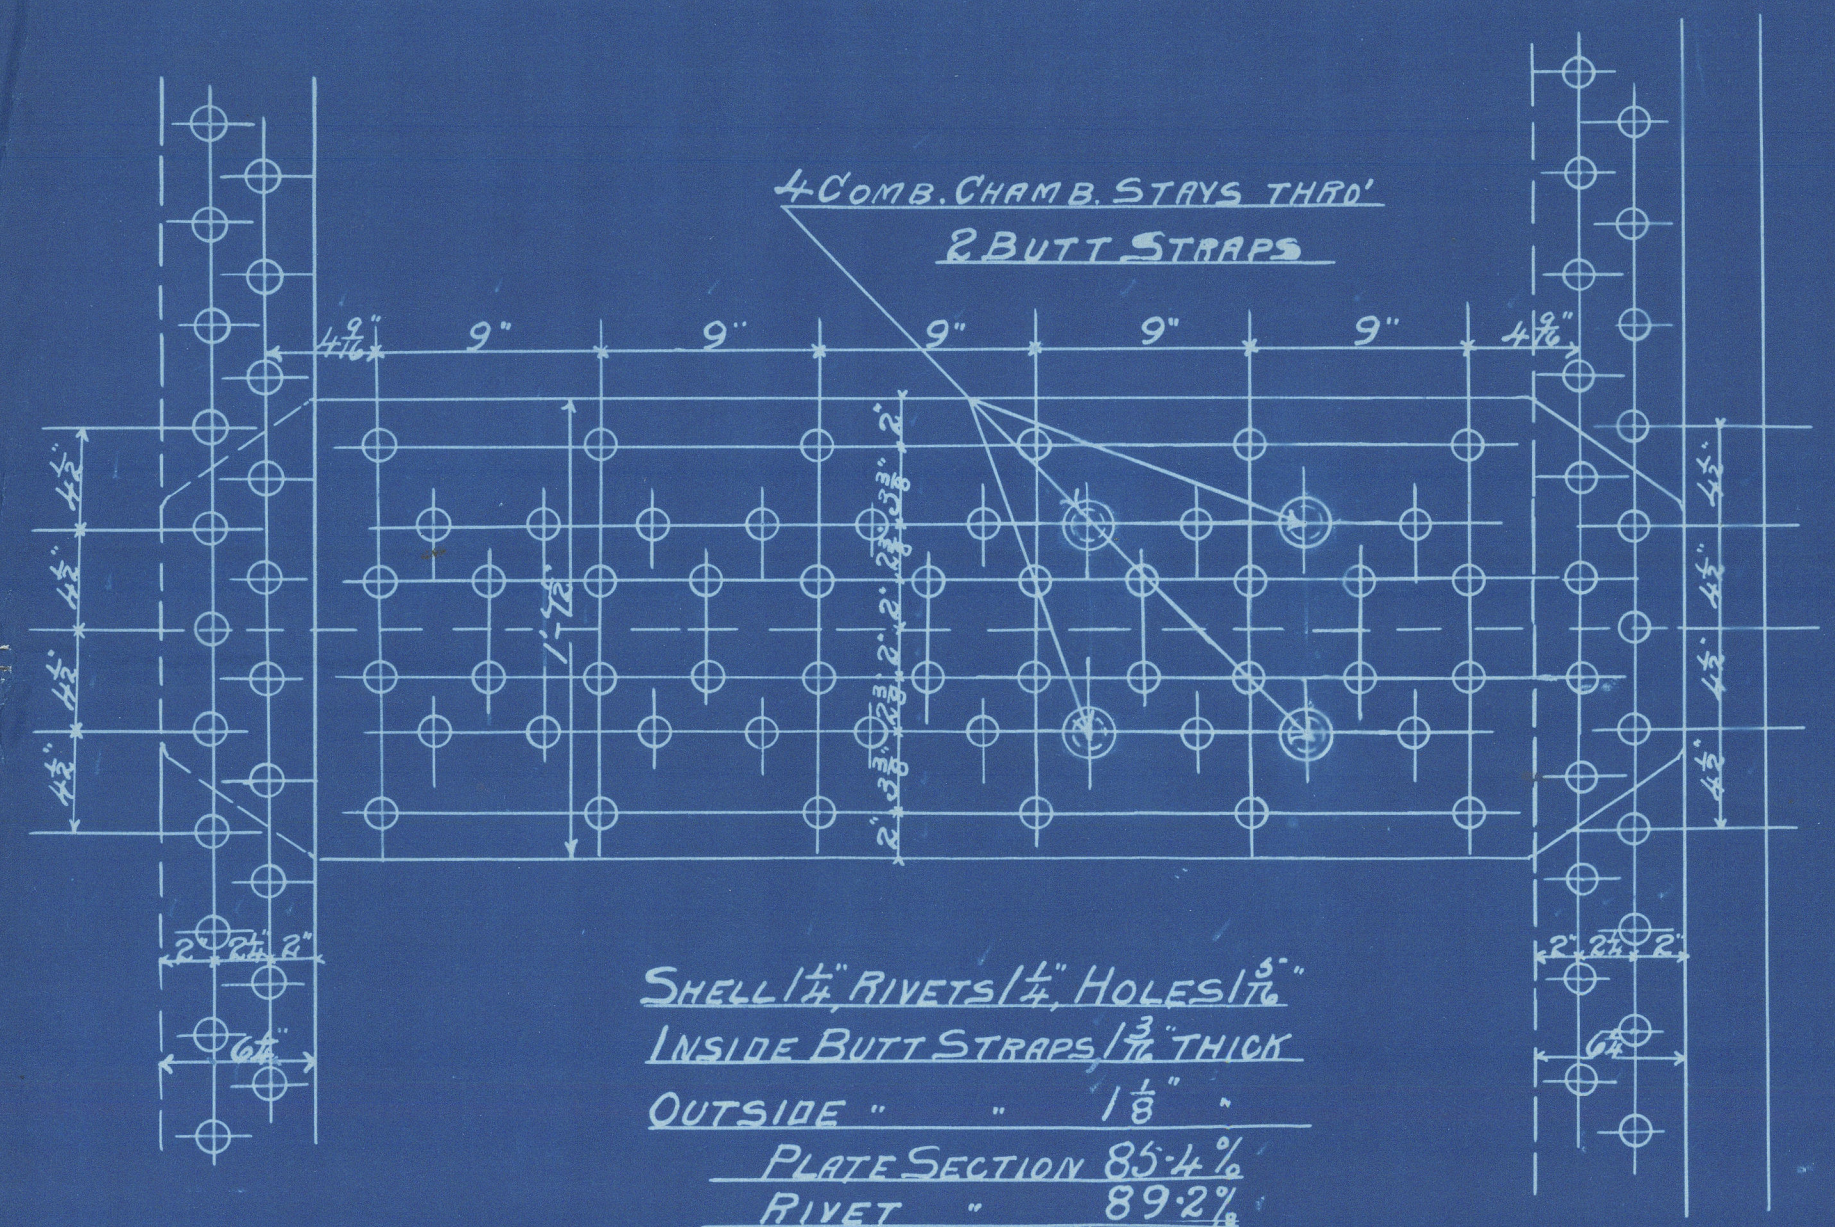

HEATING SURFACES	Sq. Ft.
H.S. IN TUBES	1490
" " FLUES	154
" " CHAMBERS	253
TOTAL	2800

TO Messrs LLOYDS ENGINEER SURVEYORS.

**MOORE PARK BOILER WORKS**  
**LINDSAY BURNET & CO**  
 17/10/28  
 Drawing No. 1040. Trading No. 2692  
 HELEN STREET, COVAN, GLASGOW  
 FOR J.G. KINCAID & Co. No 281.

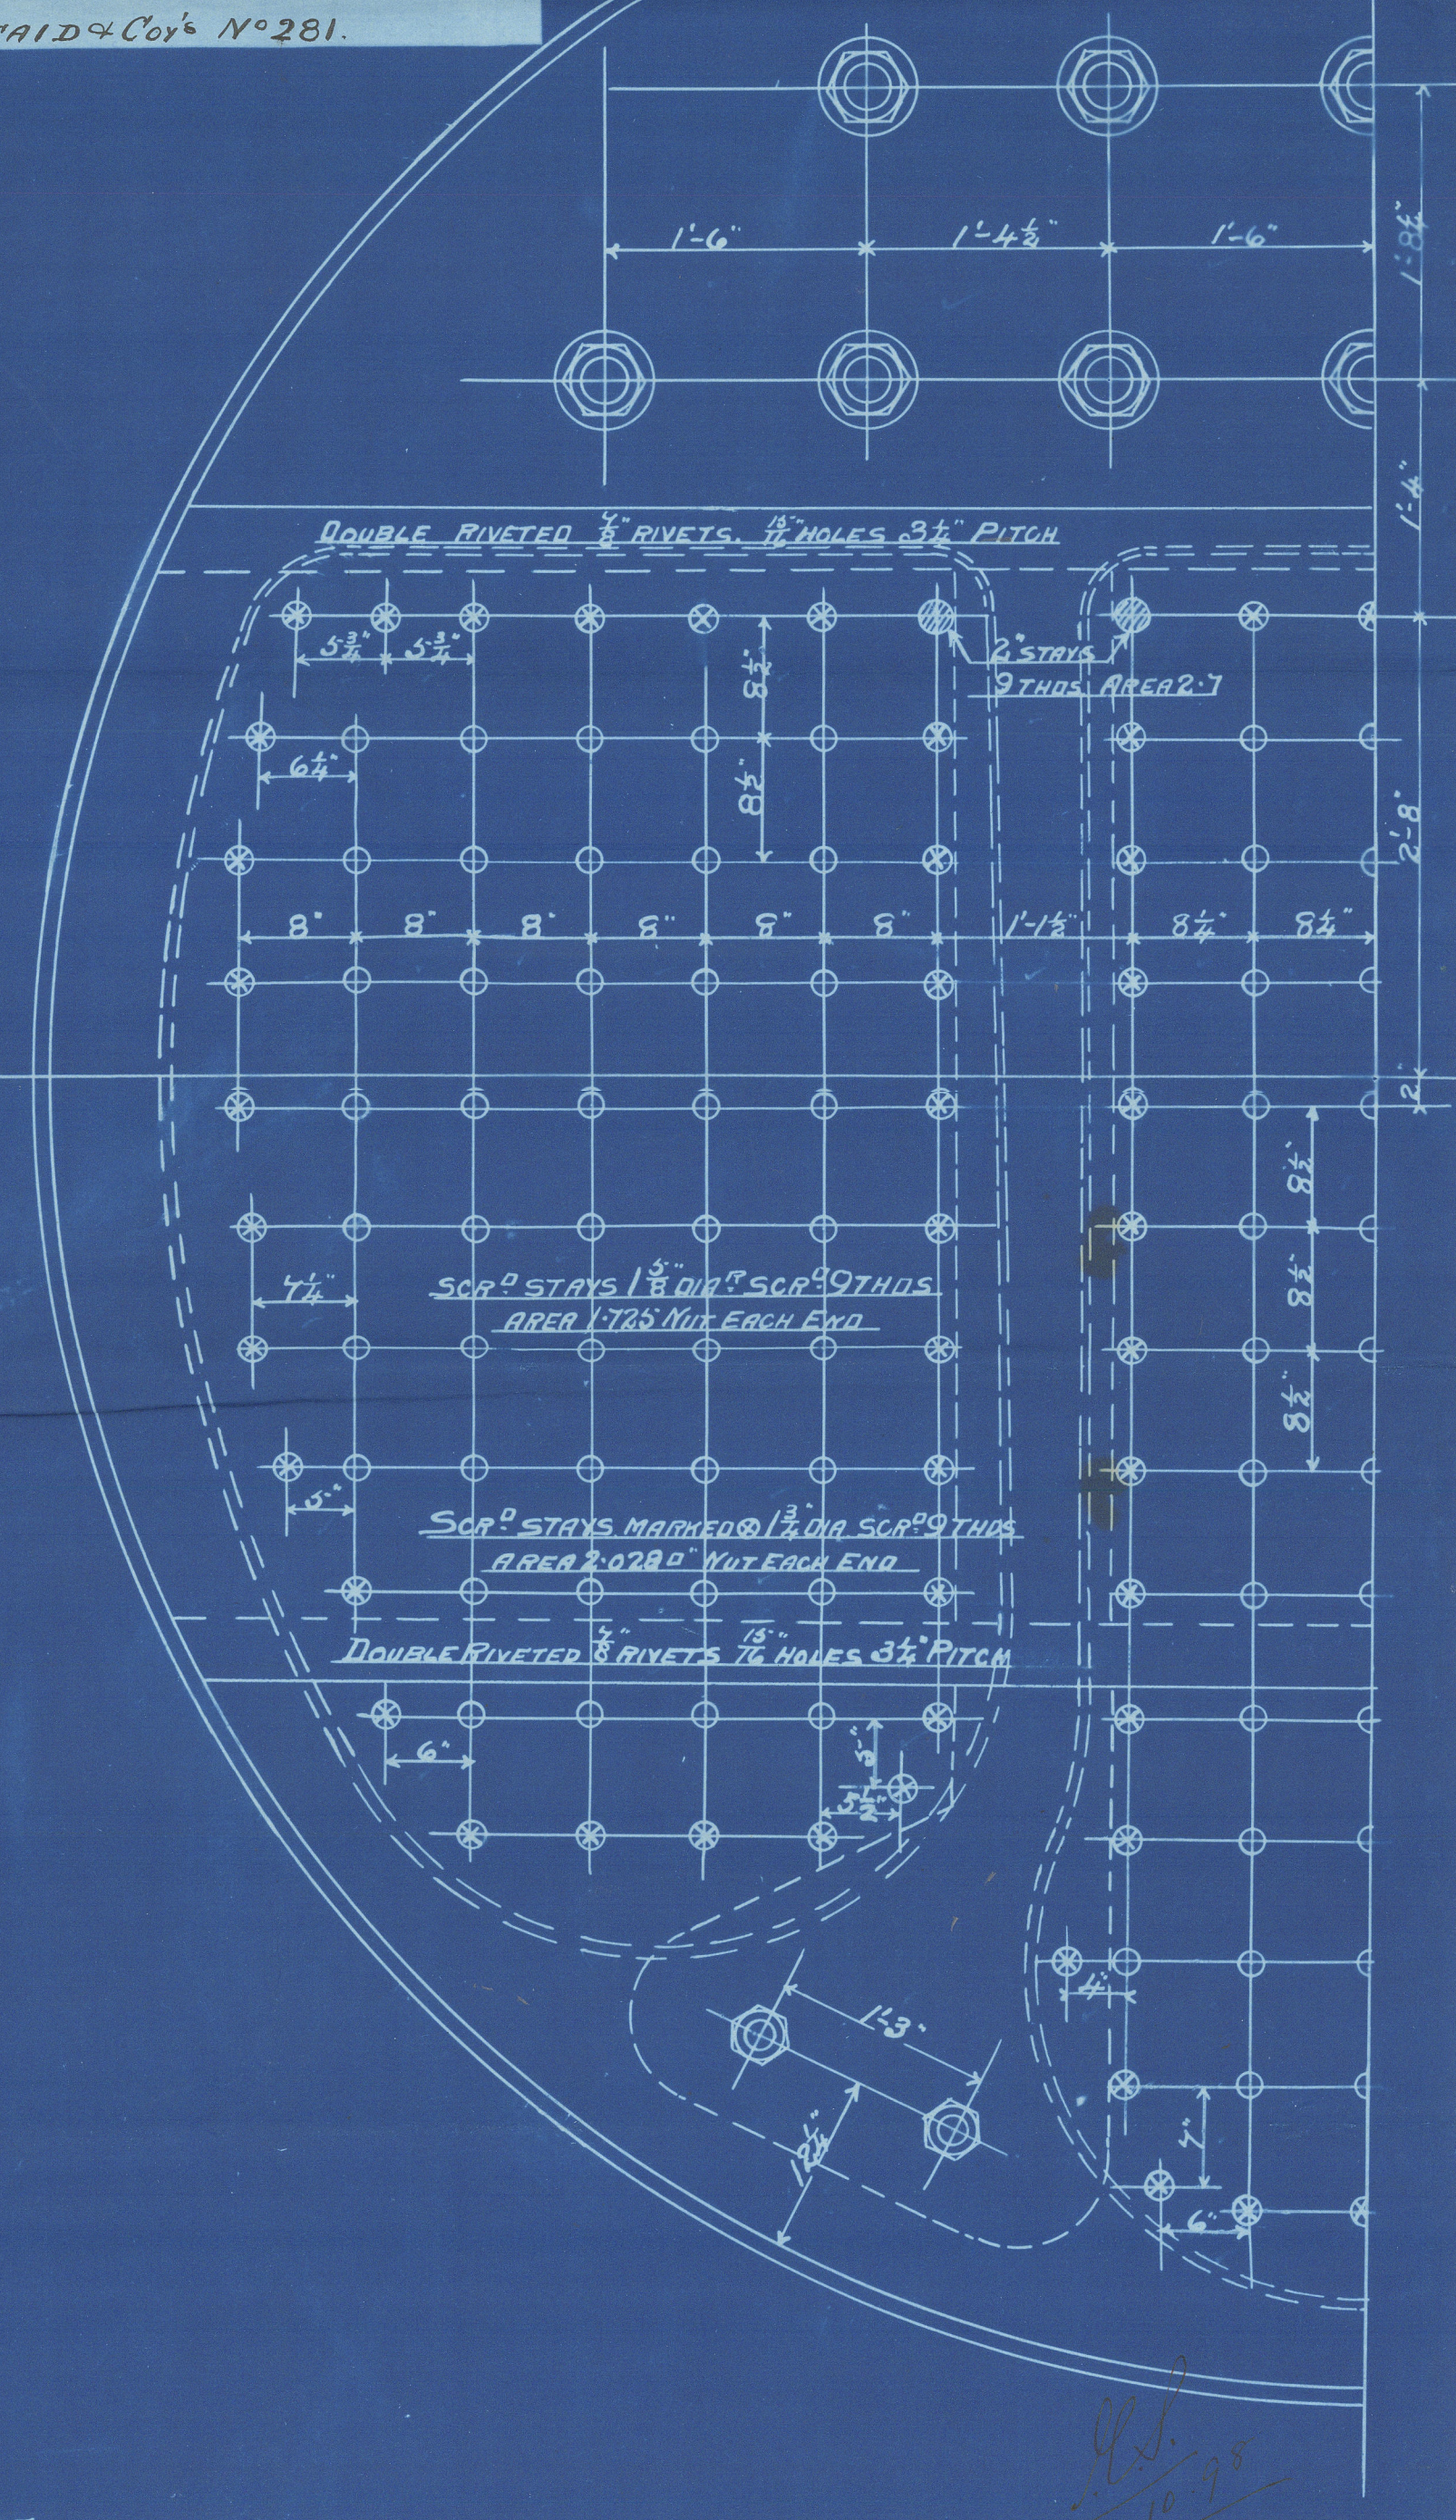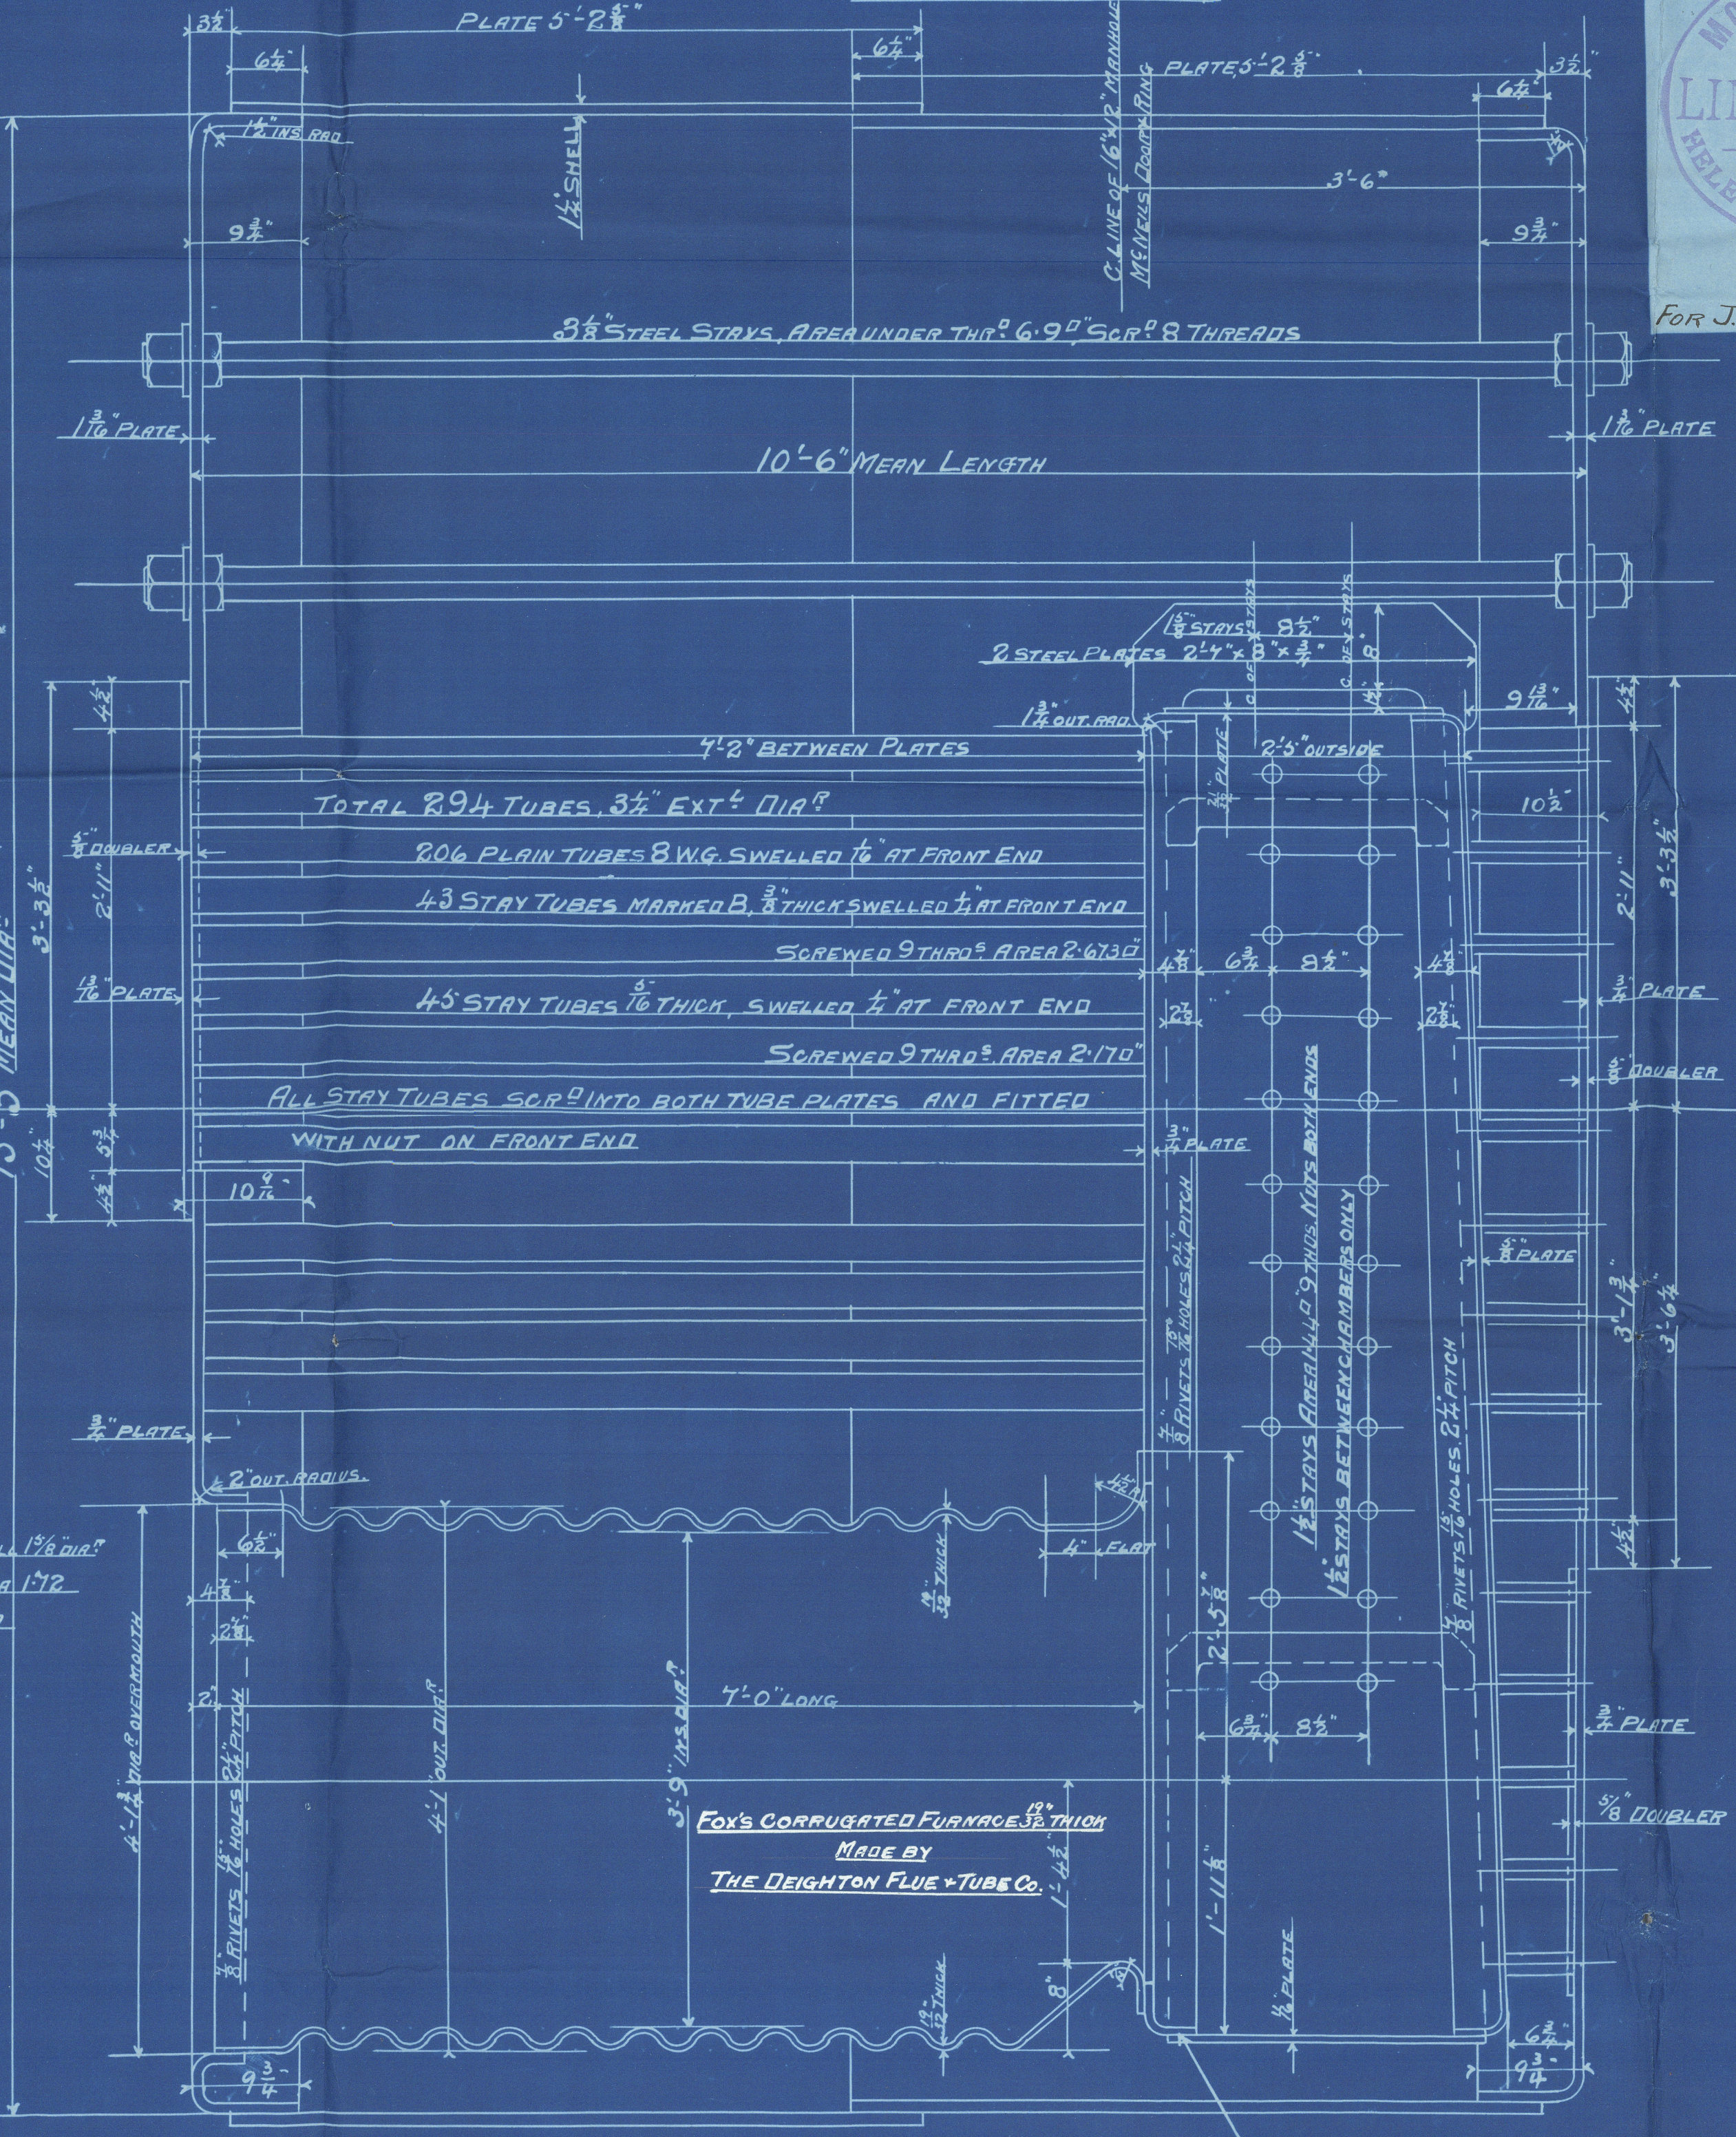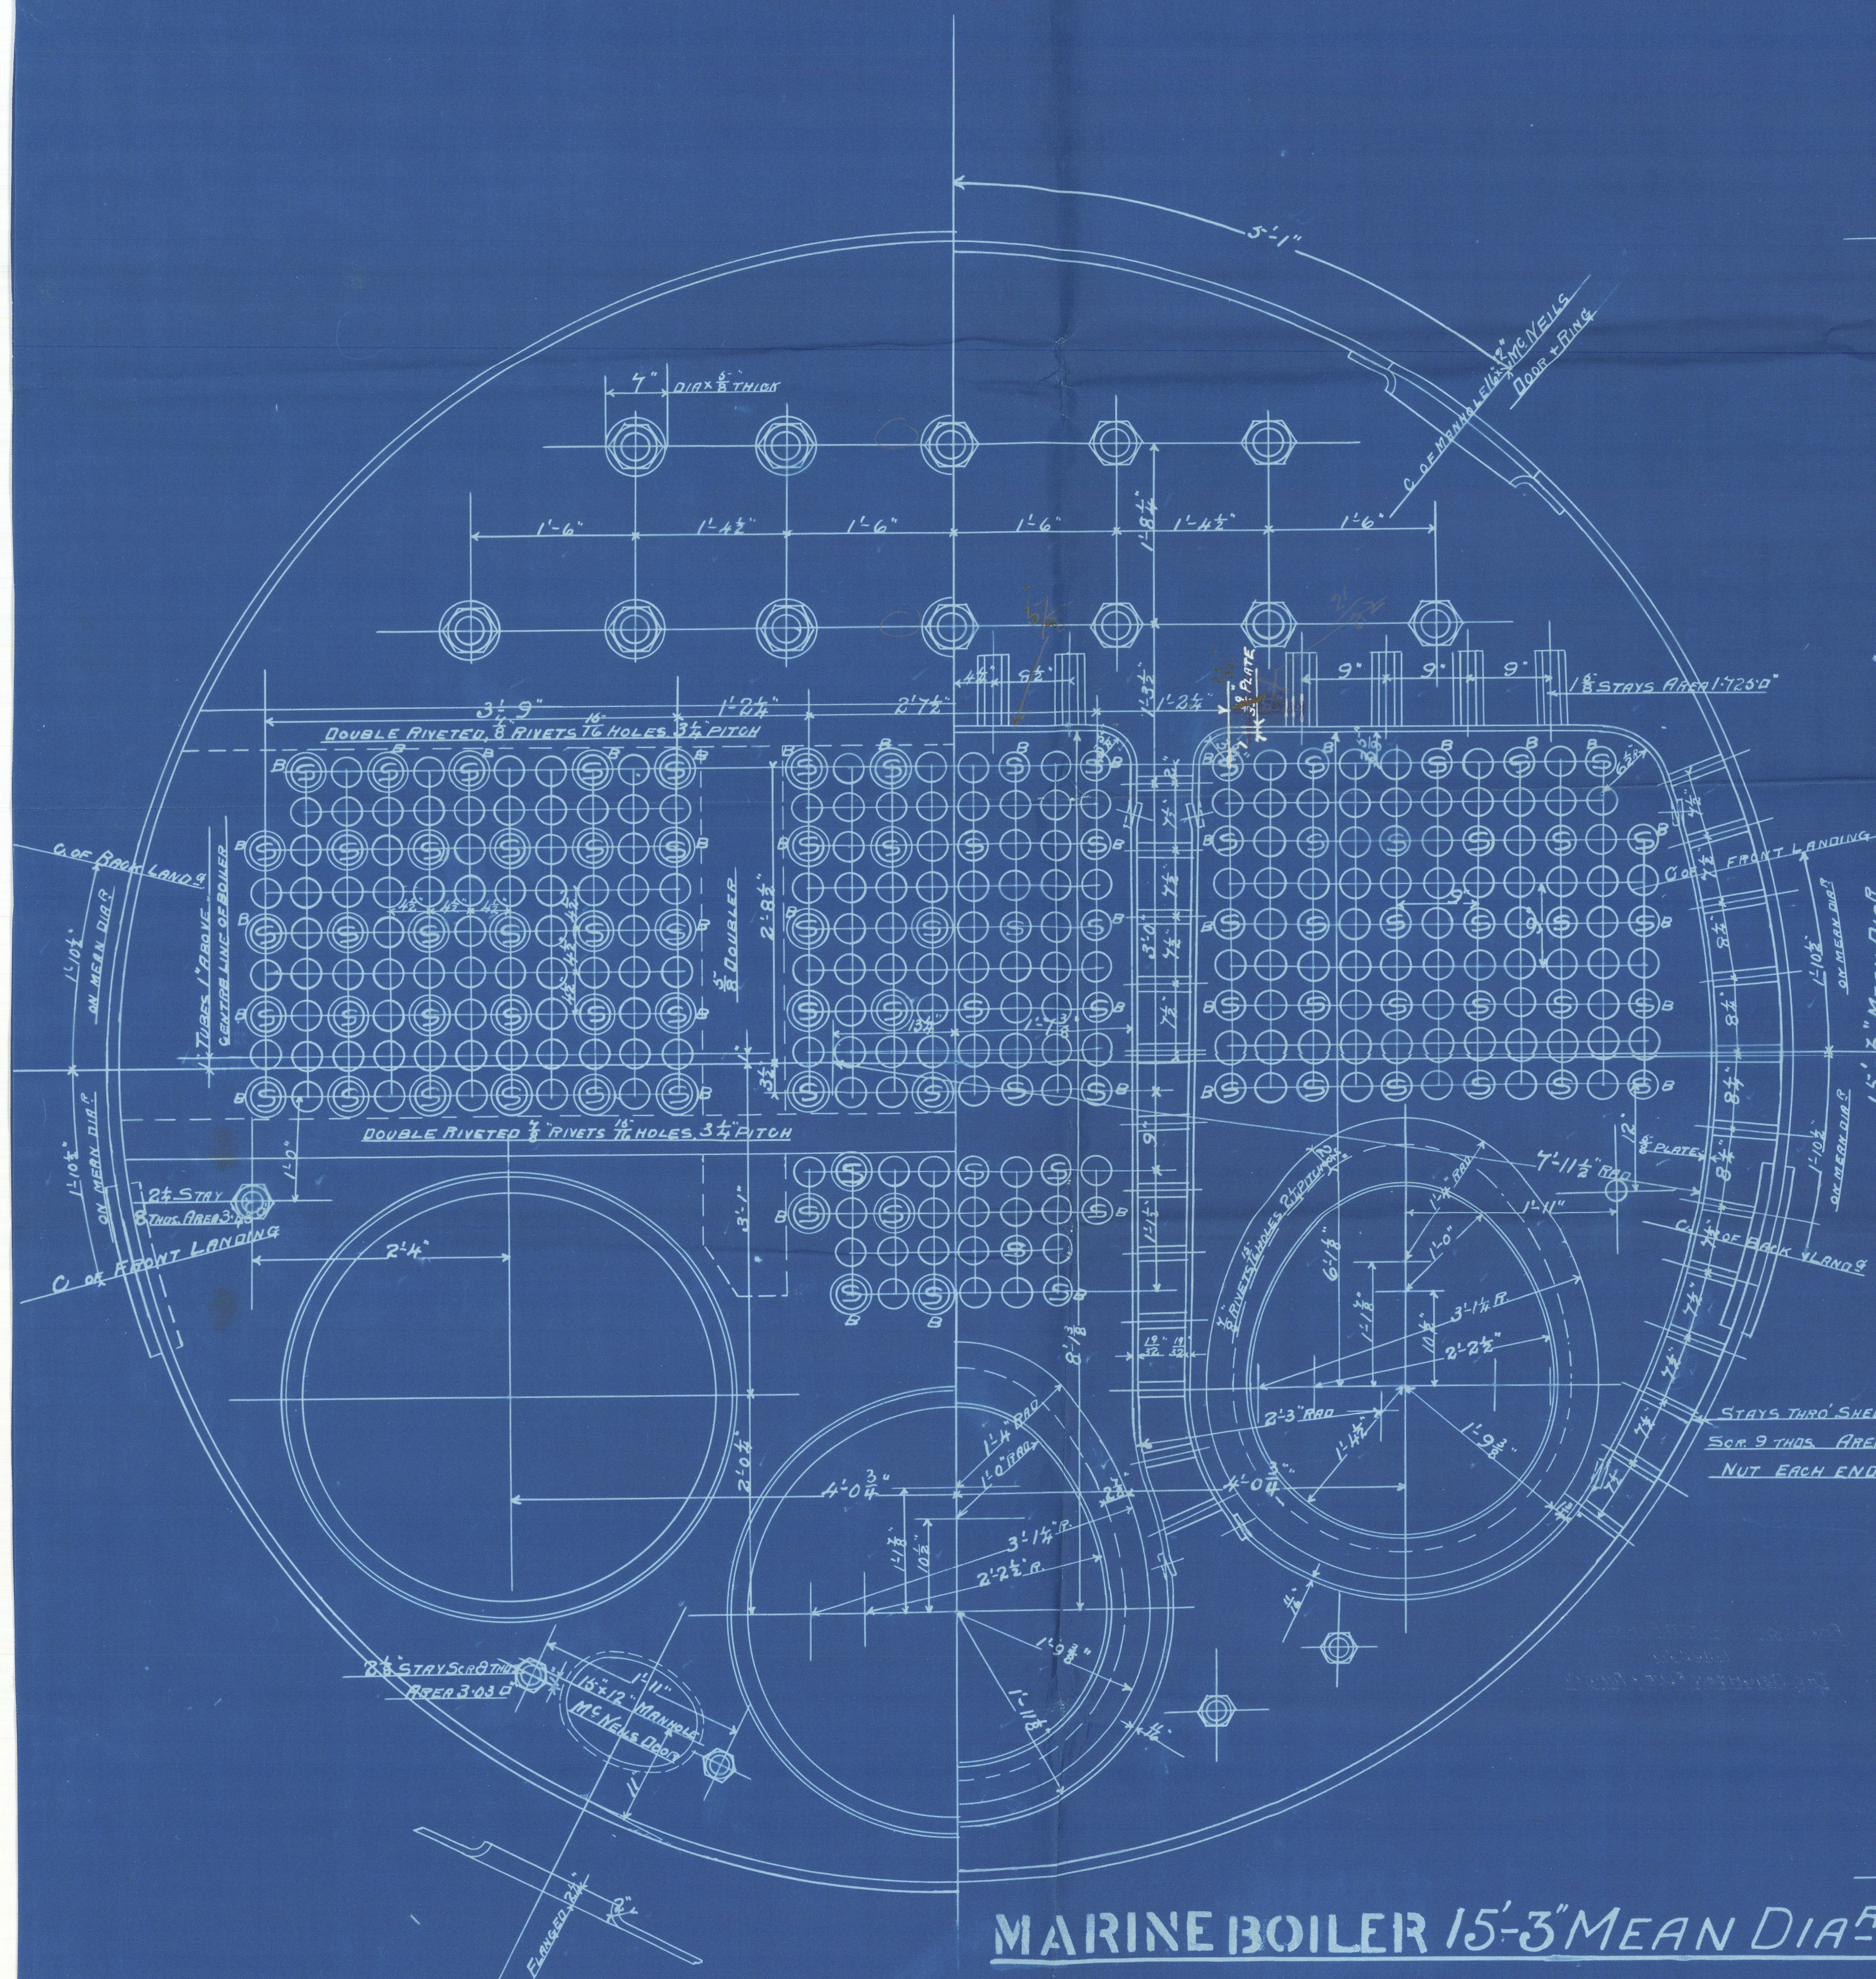

MARINE BOILER 15'-3" MEAN DIA<sup>2</sup> X 10'-6" MEAN LENGTH X 180 LBS W.P.

UNDER LLOYDS SURVEY

SCALE 1" = ONE FOOT

NOTE. ALL RIVETS IN COMB. CHAMBER  
COUNTERSUNK INSIDE & OUTSIDE

BLR. NO 767-S

GRK 352-026 Lloyd's Register Foundation



Lindsay Burnet & Co  
Boilers No 767 & 768  
for

J. G. Kincaid & Co's

Engine ~~SS.~~ No 288

S.S. "Florida"

Gls report No 18218.

GRA report No 12790

GRK352-0226



© 2021

Lloyd's Register  
Foundation