


18.4.99

LONGITUDINAL & DECK PLANS

S.S. N° 457

Scale 1" = 1 foot

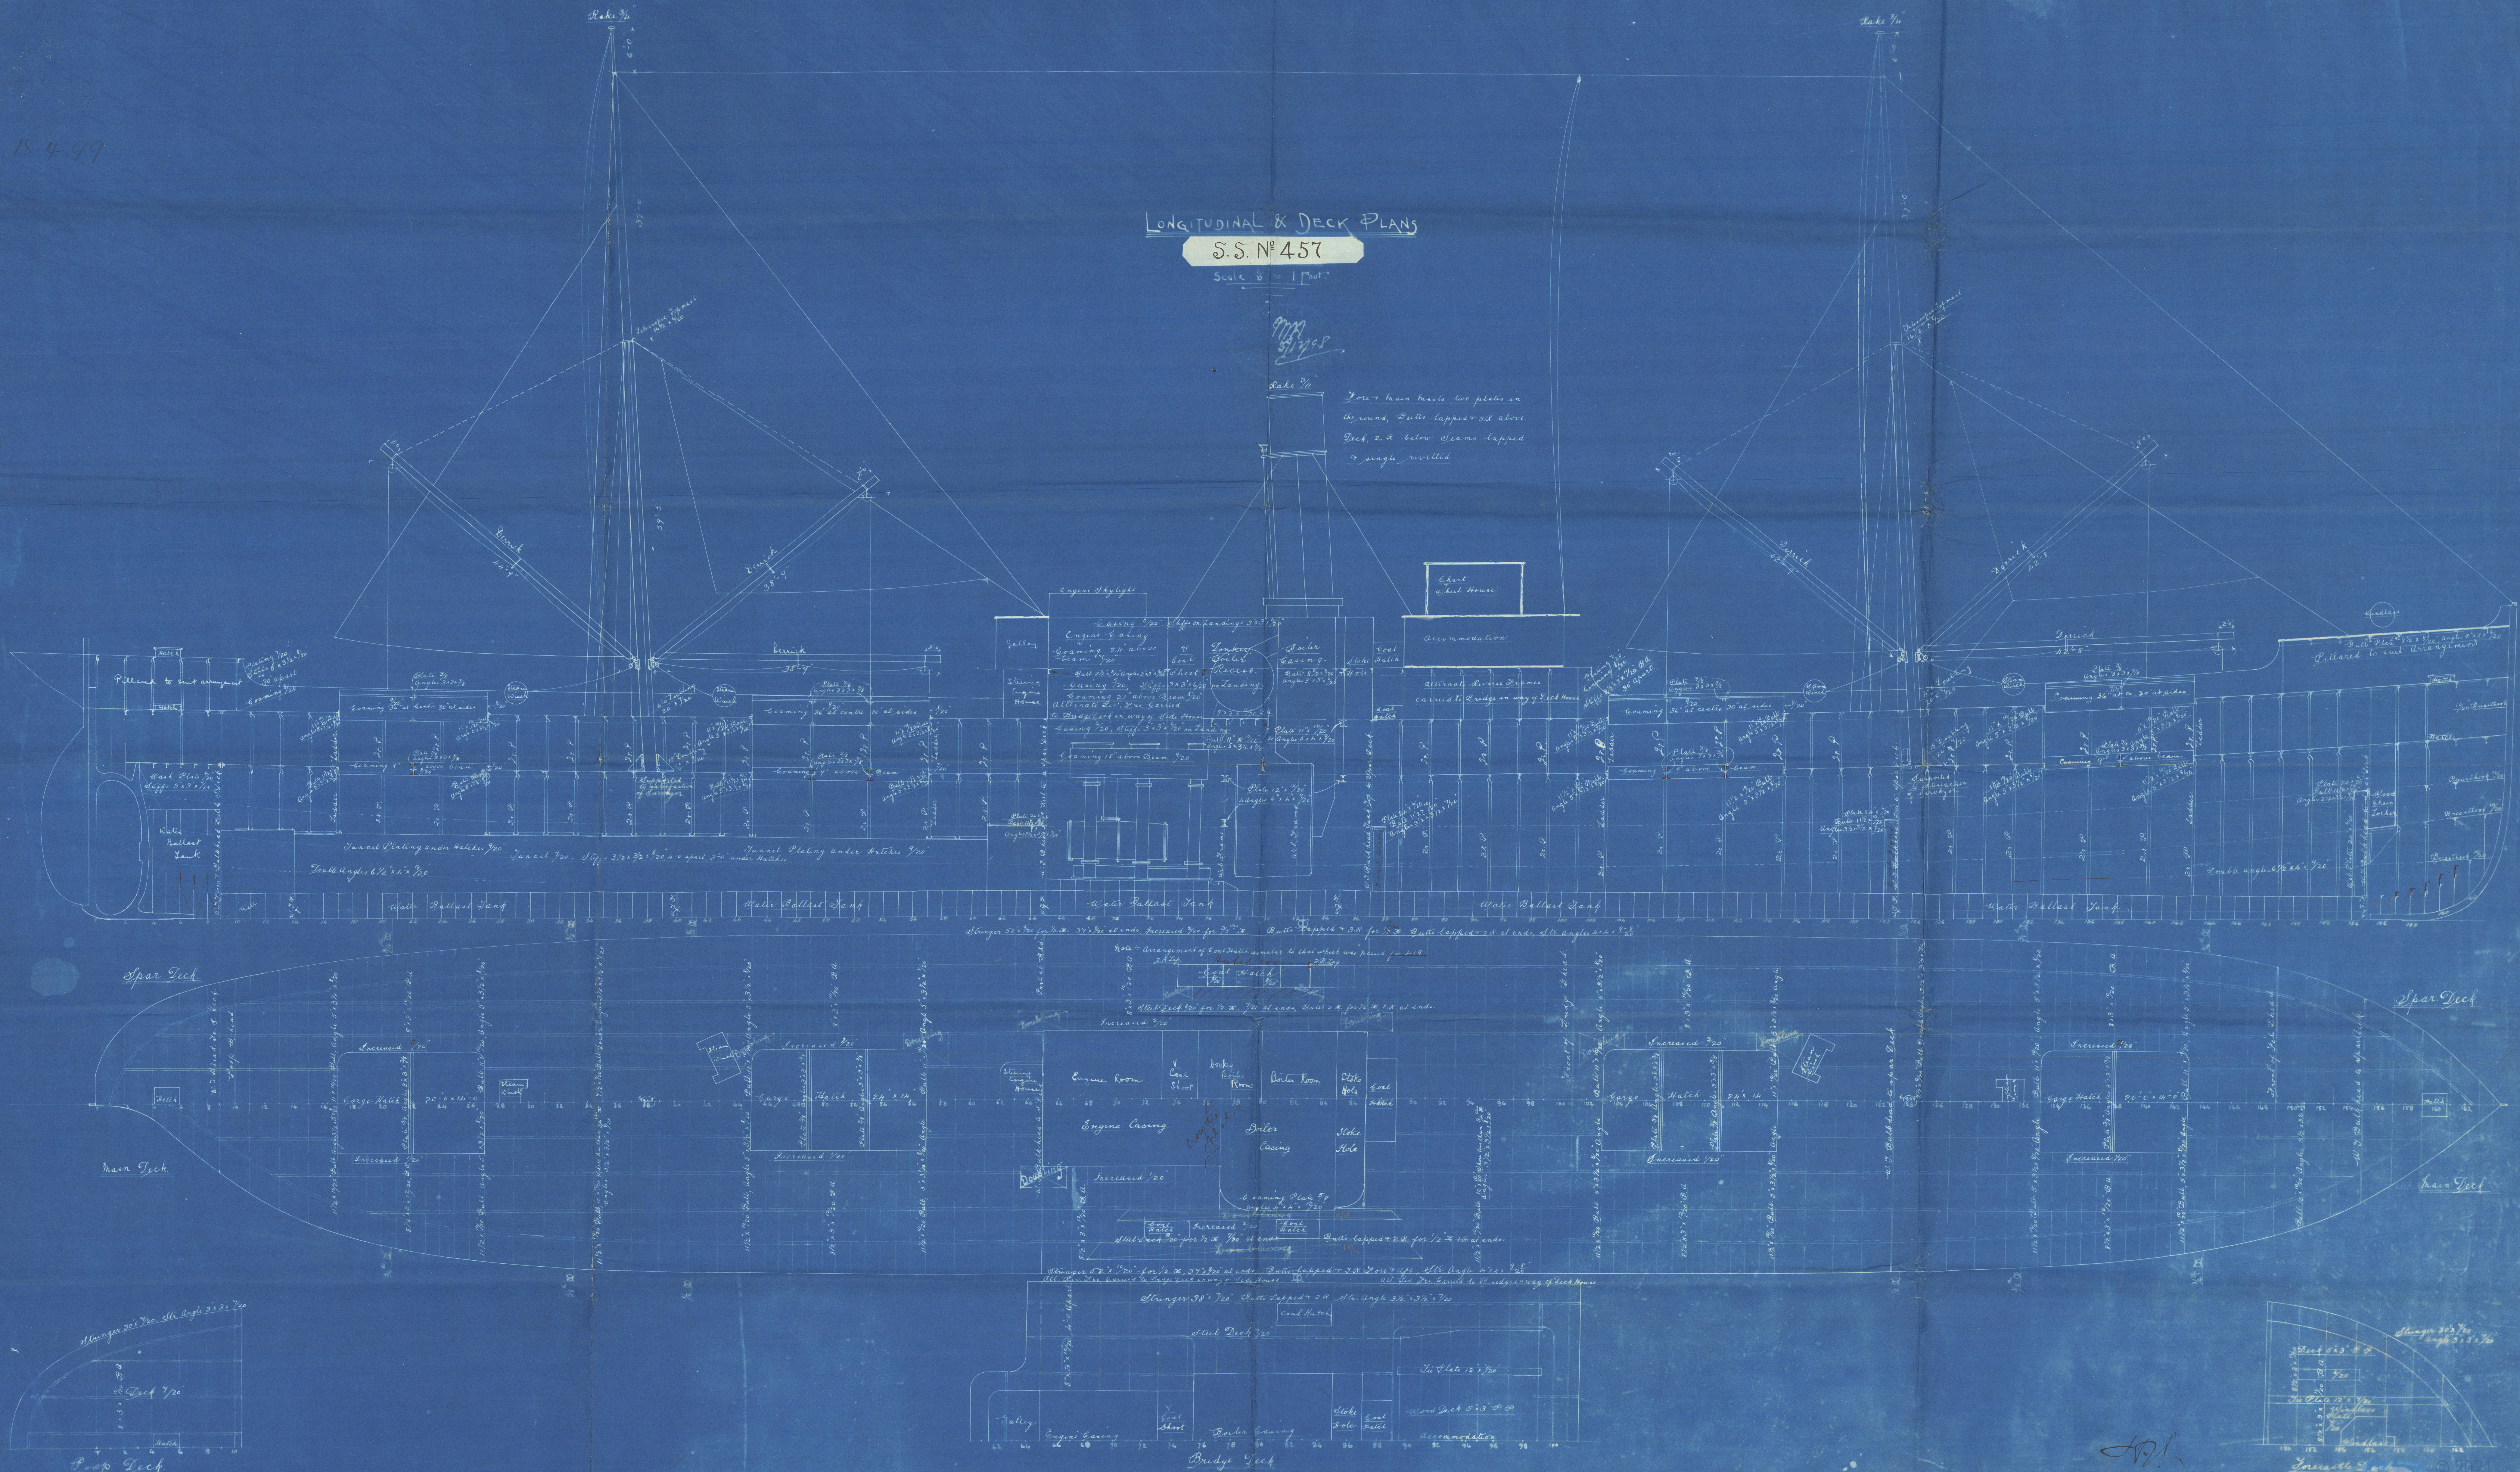

17/4/99

45
Profile & Deck Plan
Russell & Co's No 457



S.S. Florida
Grk Report No 12790



GRK352-0230



© 2021

Lloyd's Register
Foundation