

No. of Bilge pumps *Two* Diameter of ditto *4½* Stroke *24"* Can one be overhauled while the other is at work *yes*

Marianne Grenville 12846

It is submitted that the Grenville surveyors  
be requested to state where the Donkey boiler  
is fixed.

*B.D.*

*6.11.00.*



© 2019

Lloyd's Register  
Foundation  
GRK 353-0066


Thickness *1 1/32"* Range of tensile strength *29 to 32* Are they welded or flanged *no*

Diameter of rivet holes in long. seams *1 5/16"* Pitch of rivets *9" 4 1/2"*

Per centages of strength of longitudinal joint  
rivets *91*  
plate *85.4*

Working pressure of shell by rules *181 lbs*

Size of manhole in

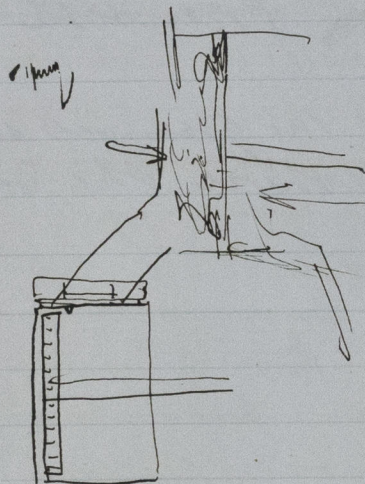

© 2019

Lloyd's Register  
Foundation

204