

15-9-99


LONGITUDINAL AND DECK PLANS

S.S. N° 462

Scale 1/8" = One Foot

mm
1/9/99

Fore & Main masts & plates in the round. Bulbs lapped & 3 R above Deck, 2 R below Deck, beams lapped & single rivelled.

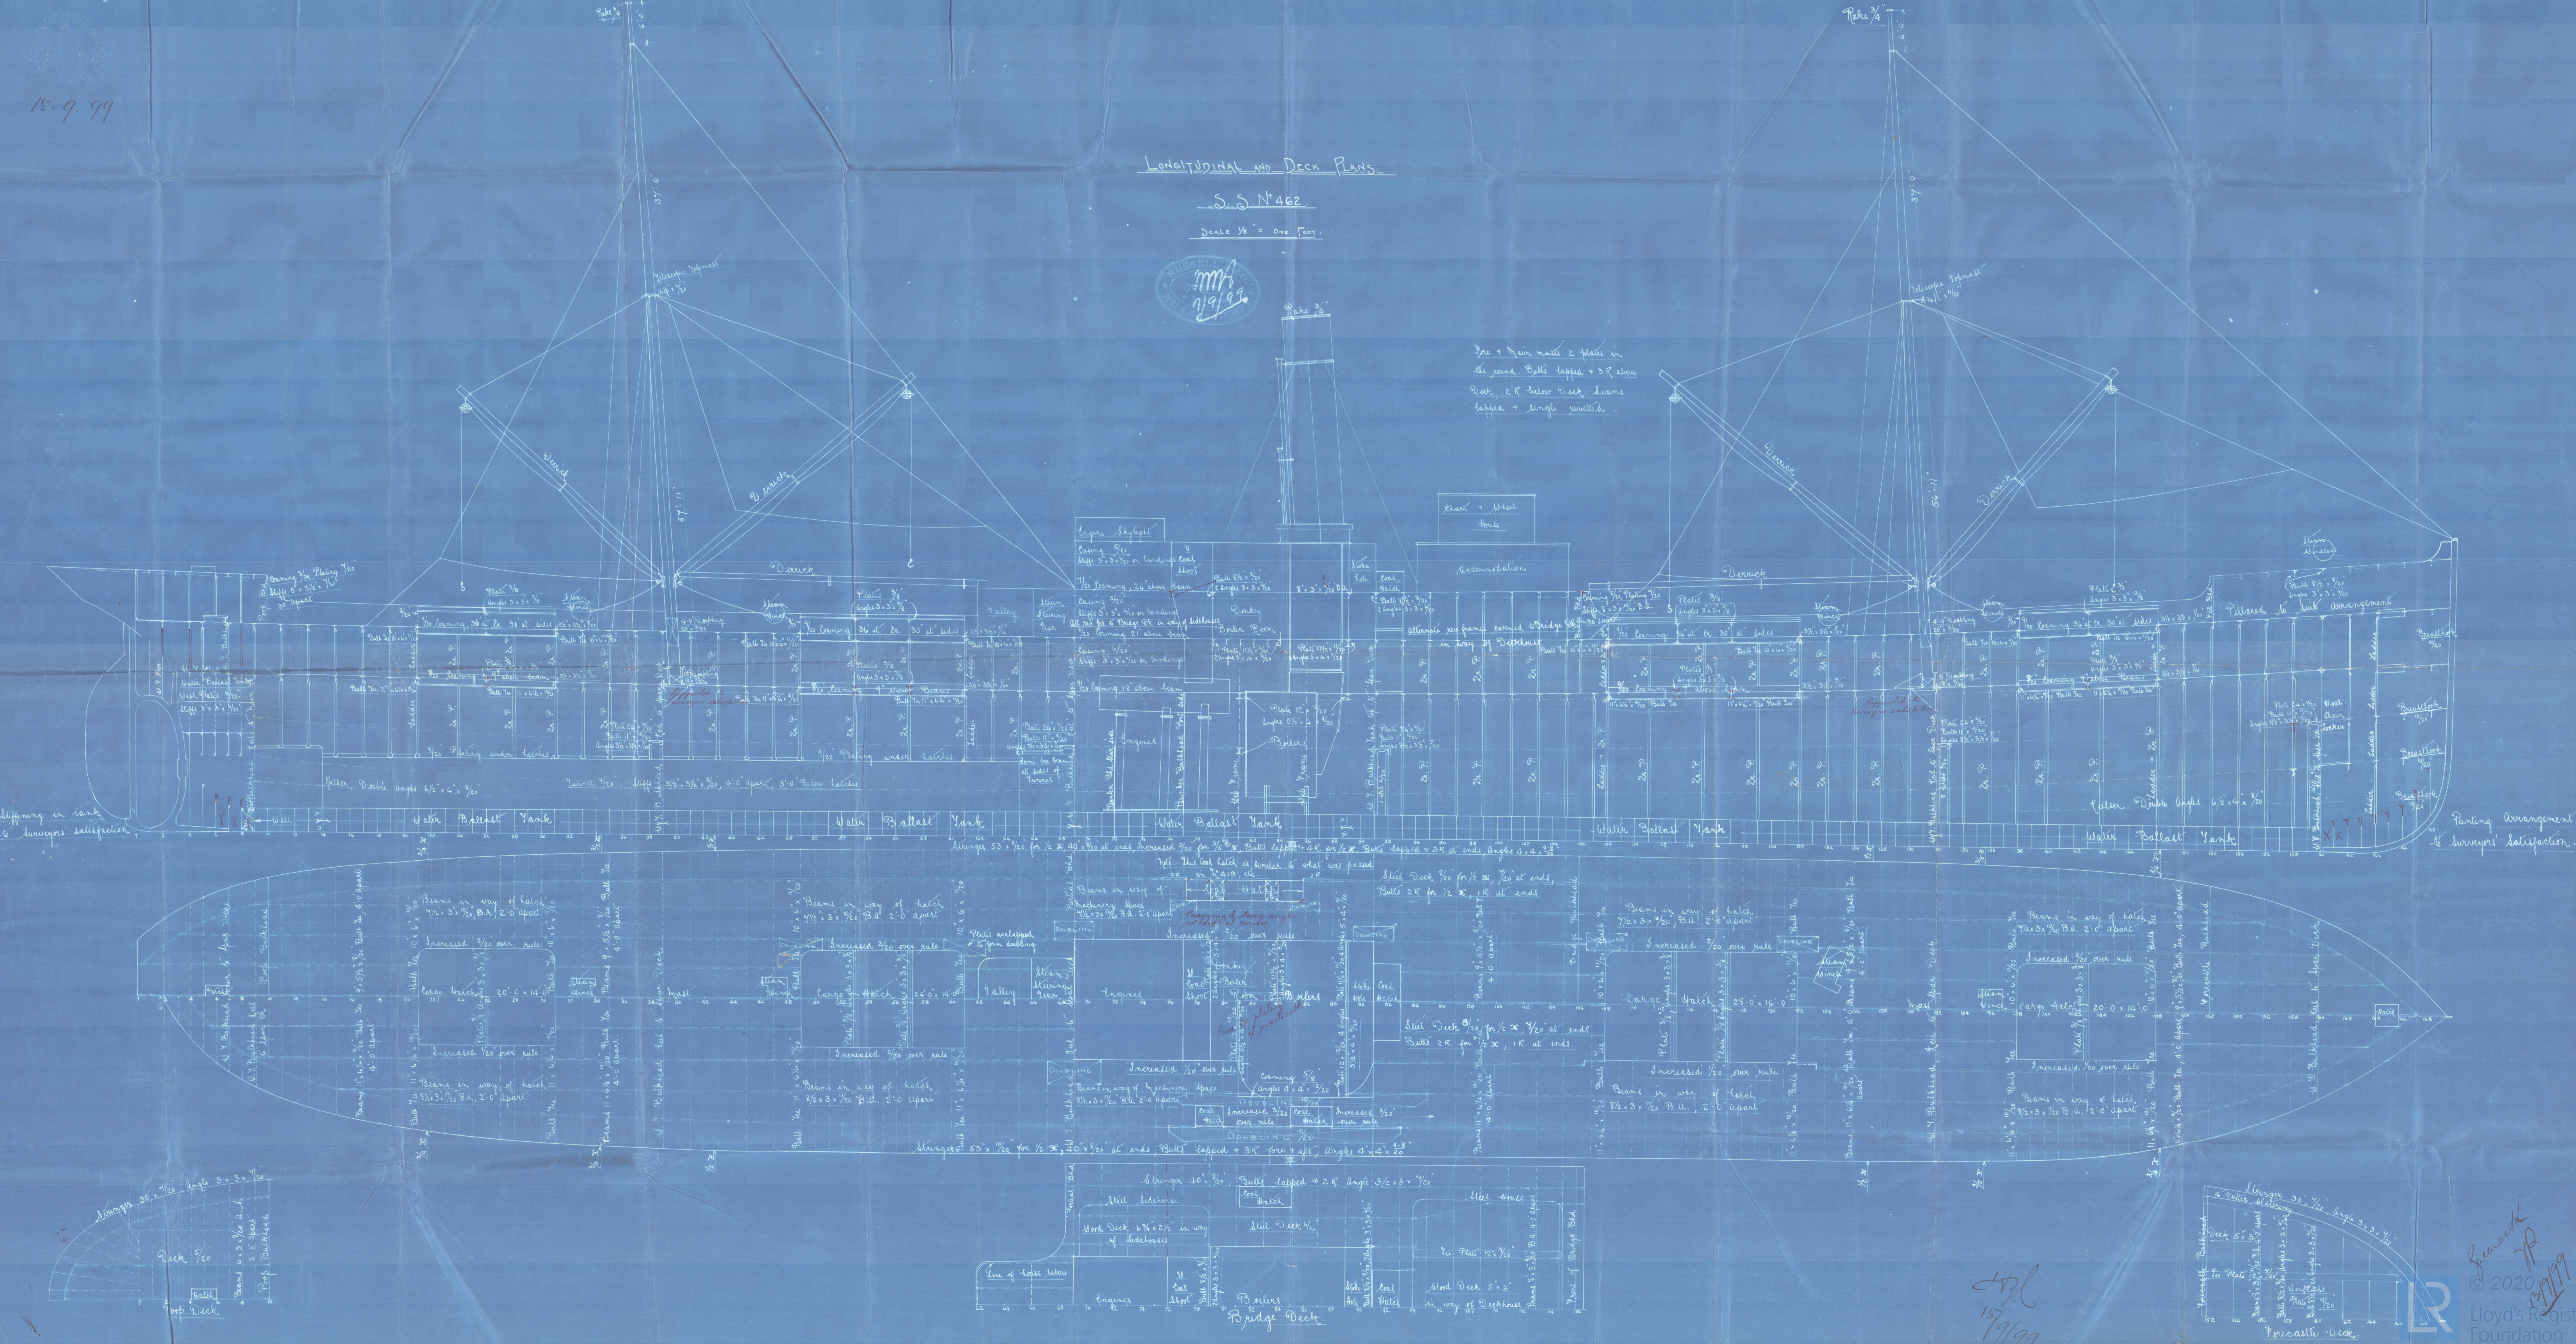

Longitudinal Section
Russell & Co. No. 462




GRK353-0083

[Handwritten signature]



© 2020

Lloyd's Register
Foundation