


4-208

Gen. Report No. 12854

GRK353-0102





2019
e
yd's F
ndat




13.12.99

— N^{os} 208 & 9. —
— SKETCH OF MANHOLES IN TANK FLOORS —
— SCALE 1/2" = 1 FOOT. —

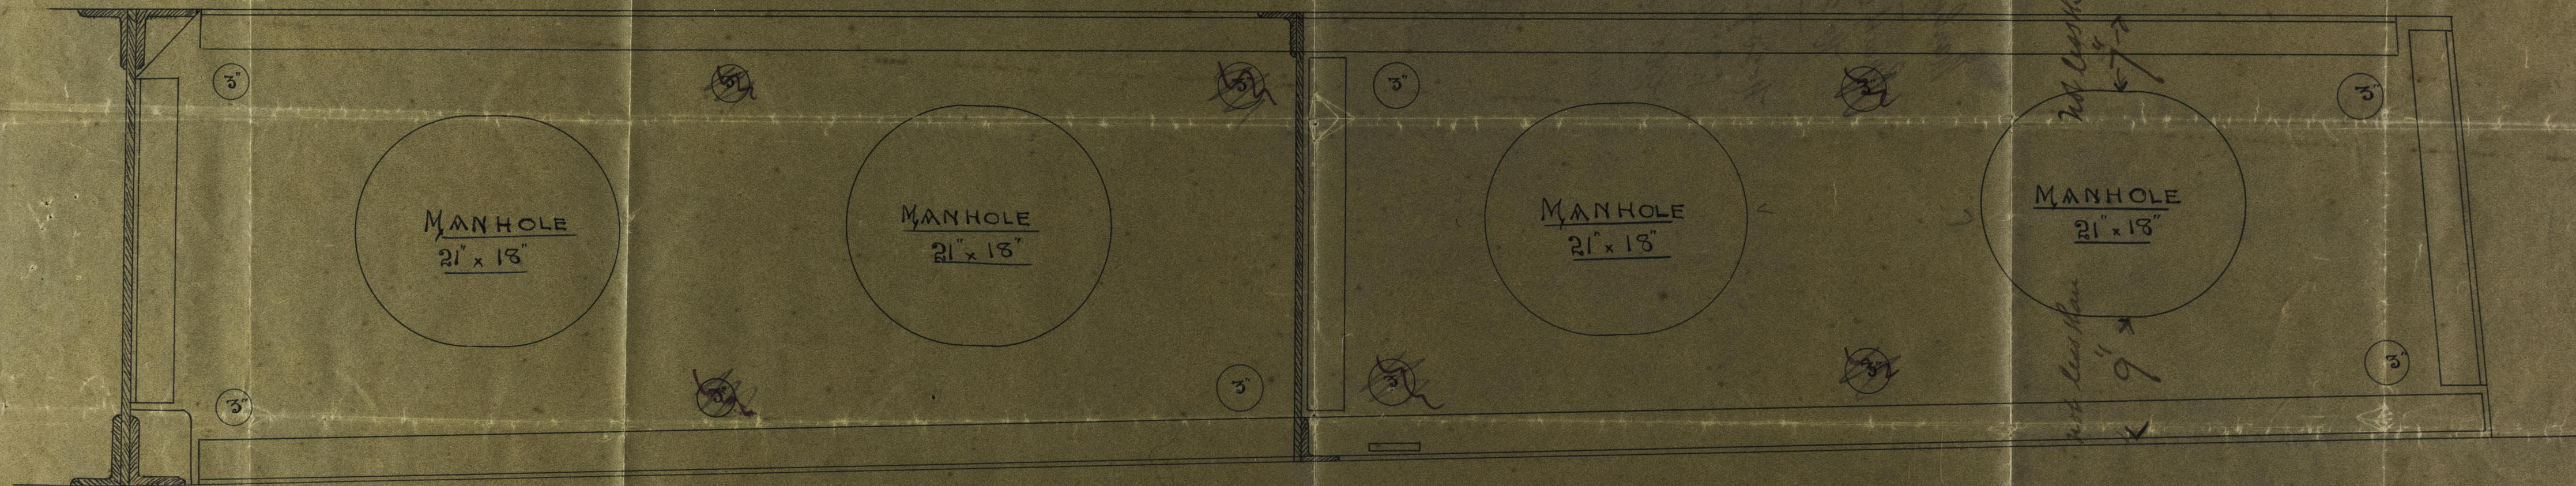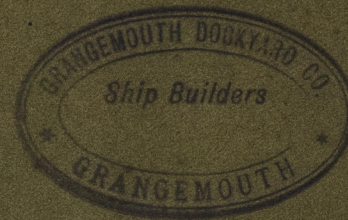

© 2019

Lloyd's Register
Foundation

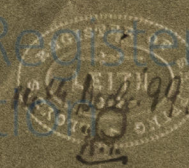

GRK353-0102