

- Midship Section. -


-S. S. D<sup>o</sup> 149- 2150 app. B/10/99

Scale  $\frac{1}{2}$  Inch = 1 Foot.

Dimensions.—

Length B. P. ----- 330.0  
Breadth extreme ----- 45.6

Depth mid. to Spar Deck - 26' 6".  
Class 100 A1-Lloyds Spar Deck with freeboard.

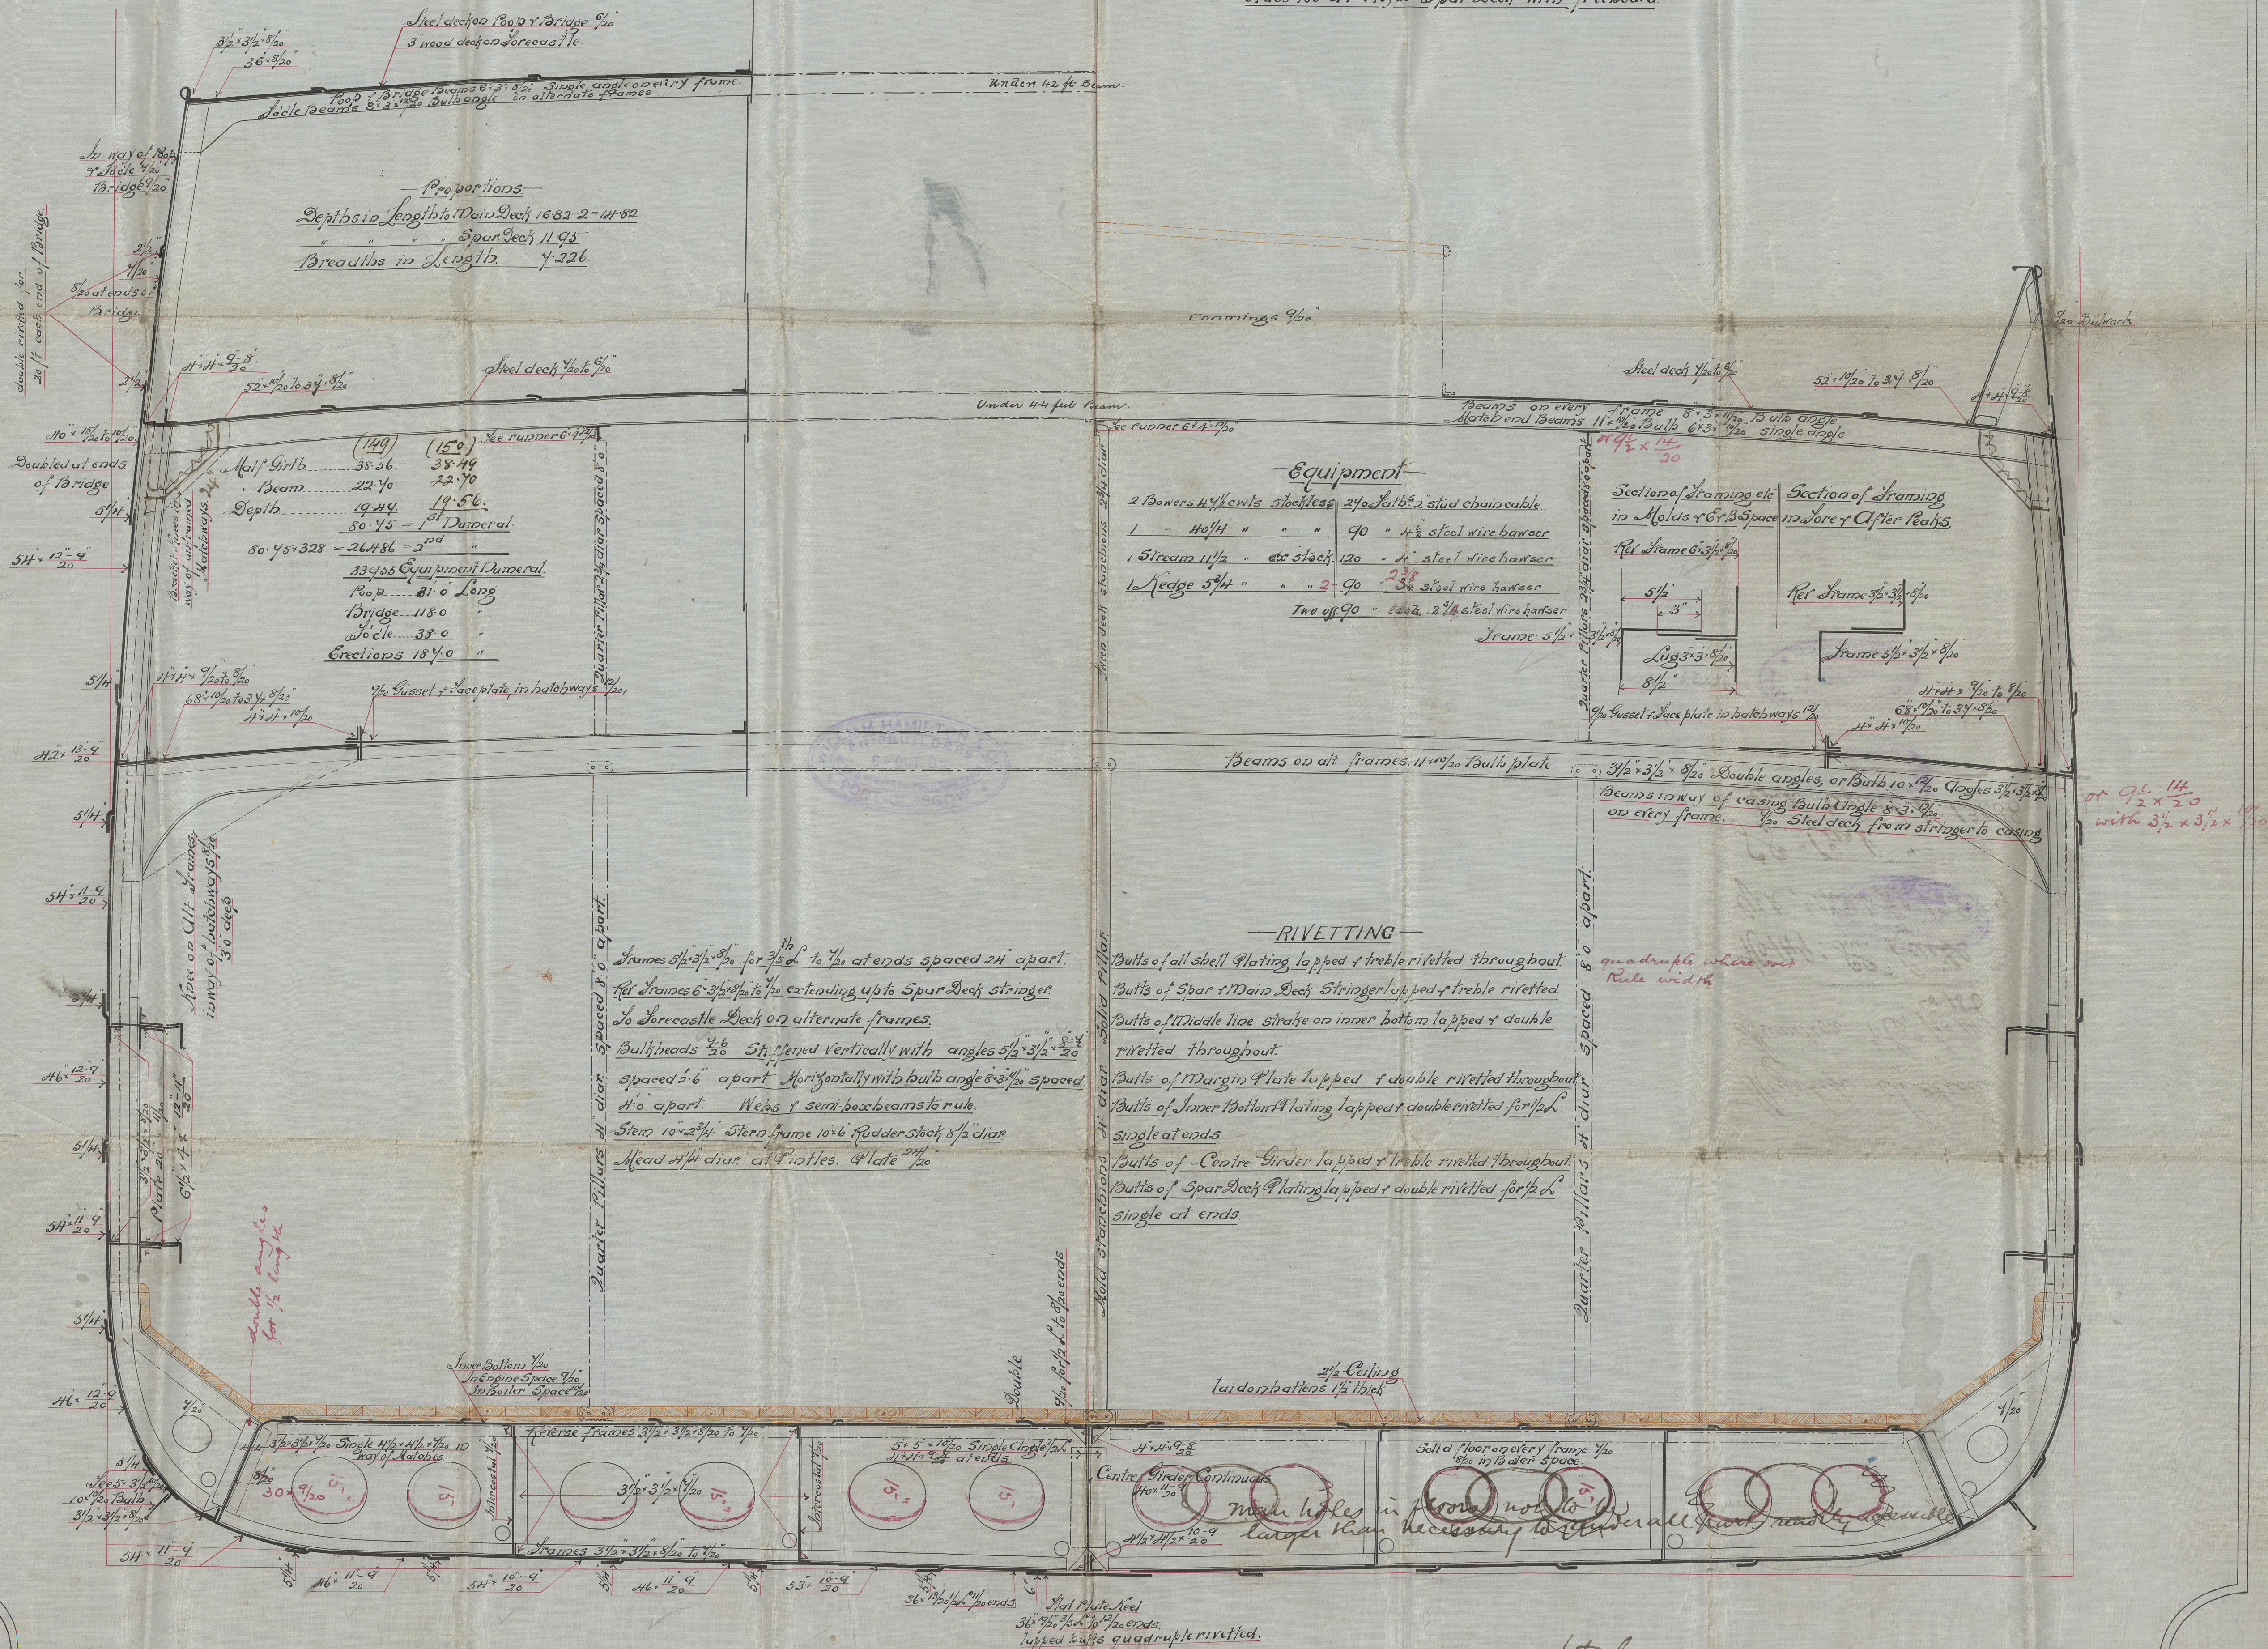

J.F.L.  
11/10/99  
13/10/99



Midship Section  
Hamilton H<sup>o</sup> 149  
8150

No 149: S.S. "Luise"  
GRK report No 12889.

S.S. "Carl"  
GRK report No 13038

GRK353-0125



© 2020

Lloyd's Register  
Foundation

