


- Pumping Arrangement. -

- S.S. *Nº 148*. Duplicate for *Nº 149 & 150*.

- Scale $\frac{1}{8}$ Inch = One ft. -

- William Hamilton & Co.,
- Shipbuilders,
- Port - Glasgow.

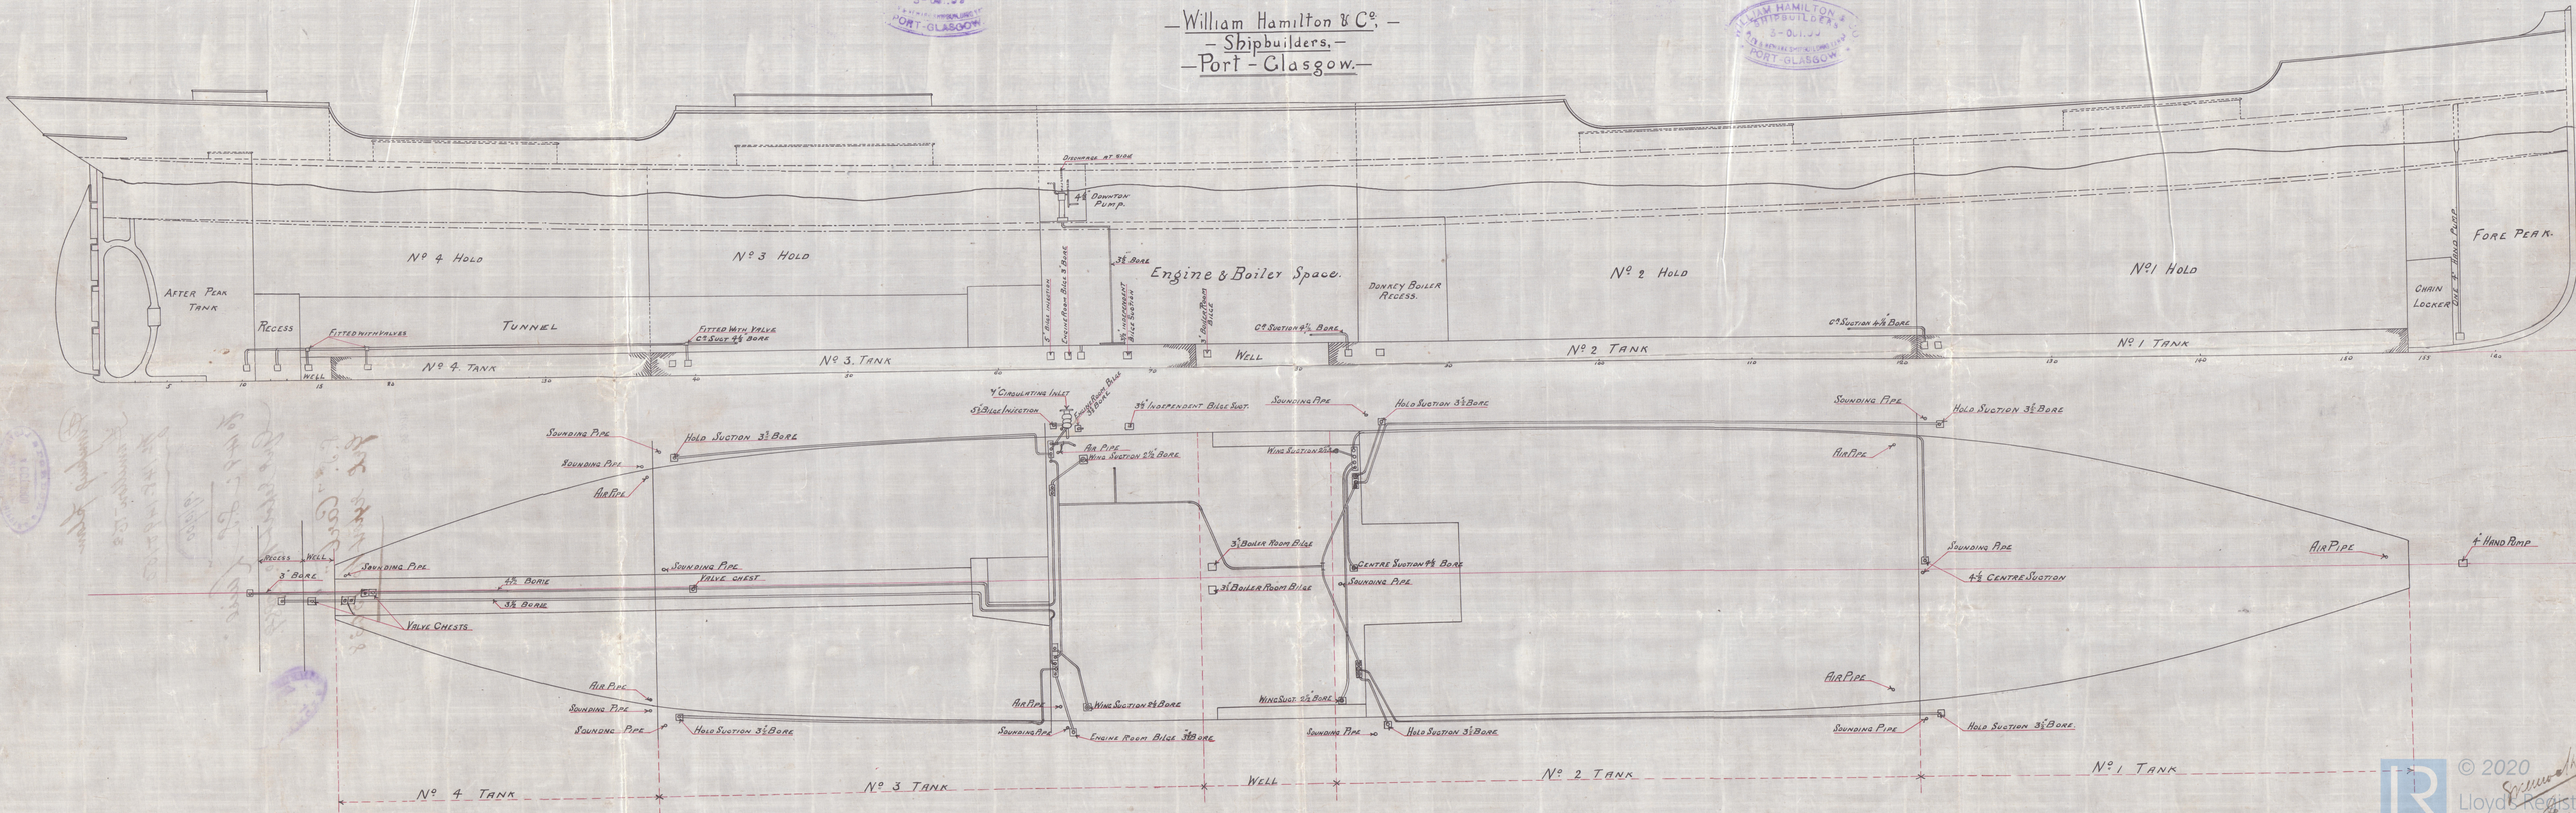



Pumping plan

Finnellon 162

No 148-149 & 150

Received 19/10/00

No 149: S.S. "Lucie"

Grp report No. 12889

S.S. "Carl"

Grp report No 13038

GRK 353-0130



© 2020

Lloyd's Register
Foundation