

Received at Greenock office, 6-1- 1900

Lloyd's Register of British and Foreign Shipping.

(Report on Vessel No. 12859 Port Greenock)No. 7324 SHIP FORGINGS OR CASTINGS.S.S. 'Ruise'

I have to report that the undermentioned ~~Iron or Steel Forgings or Castings~~,
 manufactured by The Portland Forge Coy
 of Kilmarnock for the Vessel No. 149, being built
 by Wm Wm Hamilton & Co of Port Glasgow
 have been inspected by me as set forth below, and found to be, so far as can be seen,

Mark on Forgings.


Lloyd's

No. 7324

William Hamilton
Glasgow

	STERN FRAME.	RUDDER FRAME.	STEM.
Material* ...	<u>Scrap iron</u>		
How made ...	<u>Forged</u>		
Dimensions ...	<u>10 ft 6</u>		
Progress on Inspection	<u>Forging & smithing</u>		
Date when Inspected	<u>23/10/99 to 29/12/99</u>		

SKETCHES OF FRAMES SHOWING POSITION AND DESCRIPTION OF WELDS OF FORGINGS, OR PARTICULARS OF
 TESTS APPLIED TO CASTINGS.

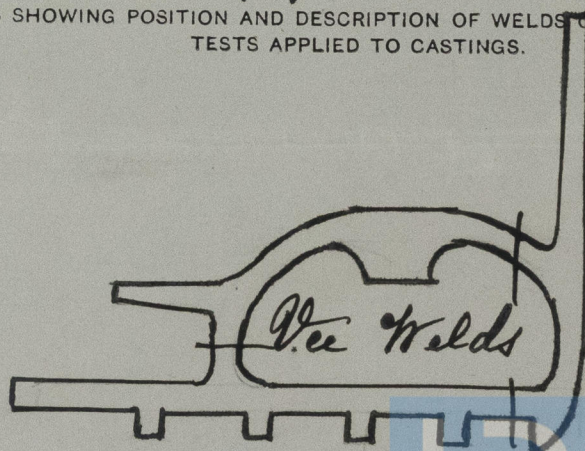

Fee (if any chargeable) £ : :

To be paid at