
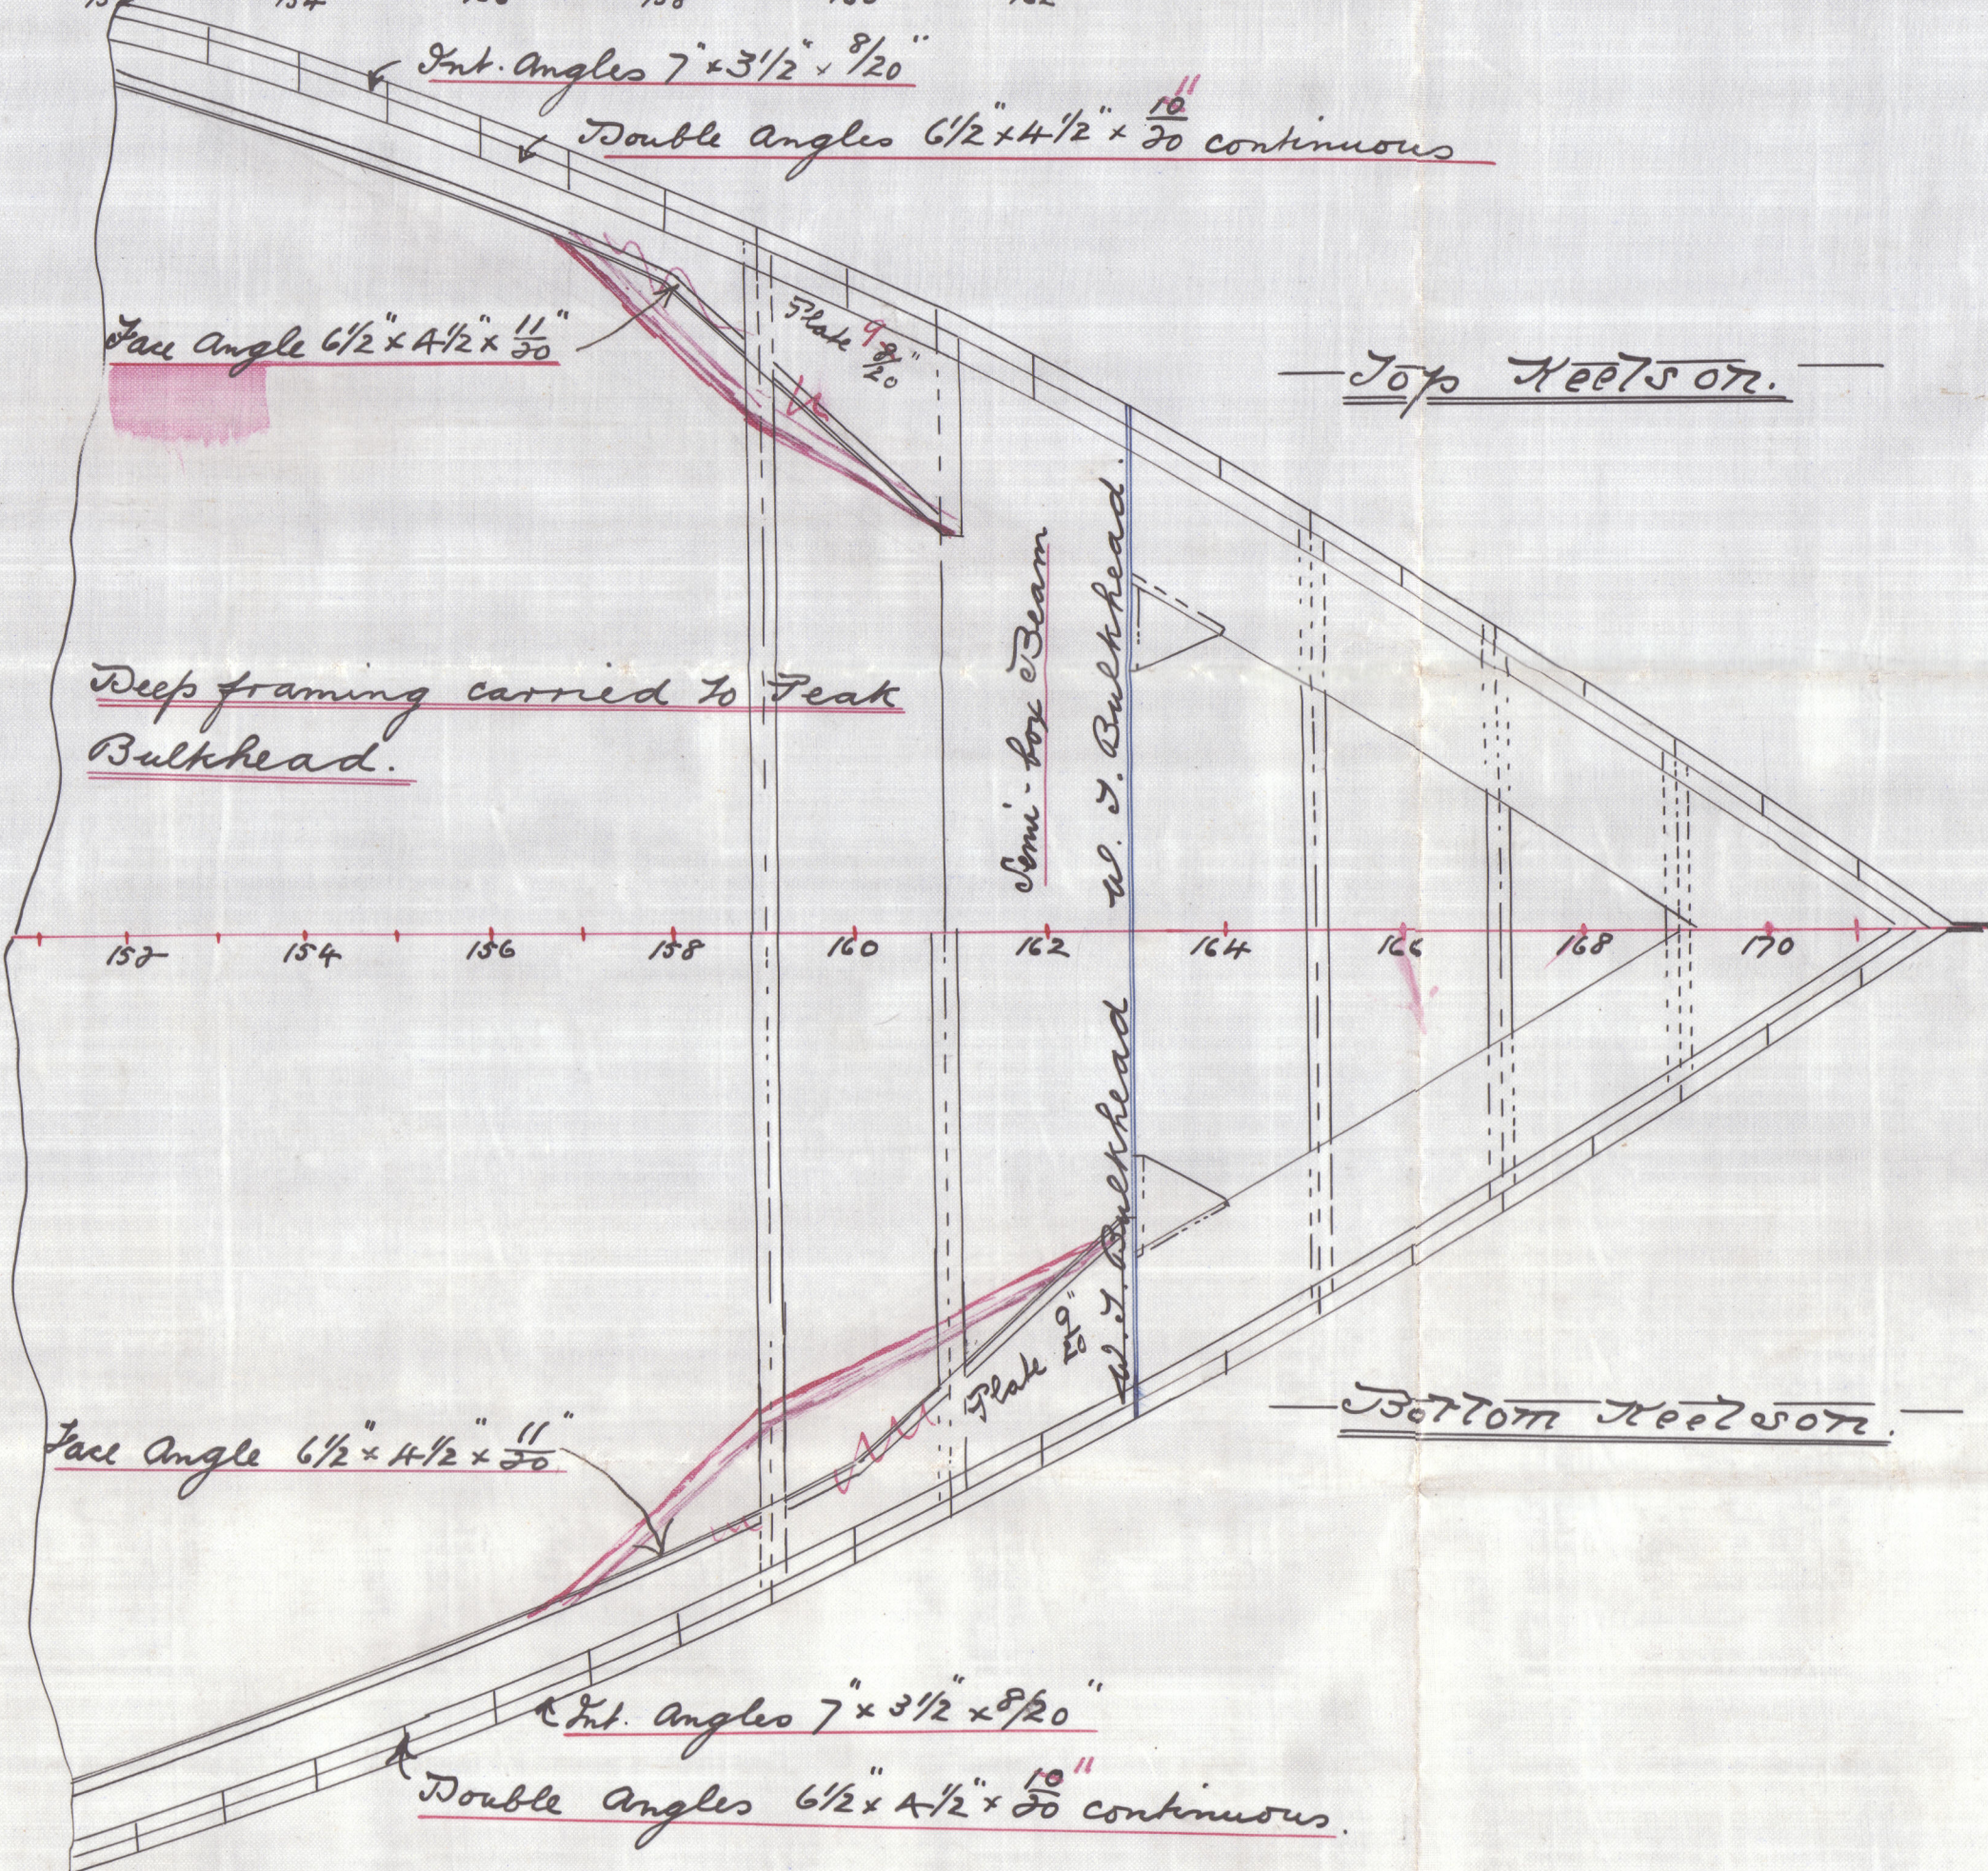
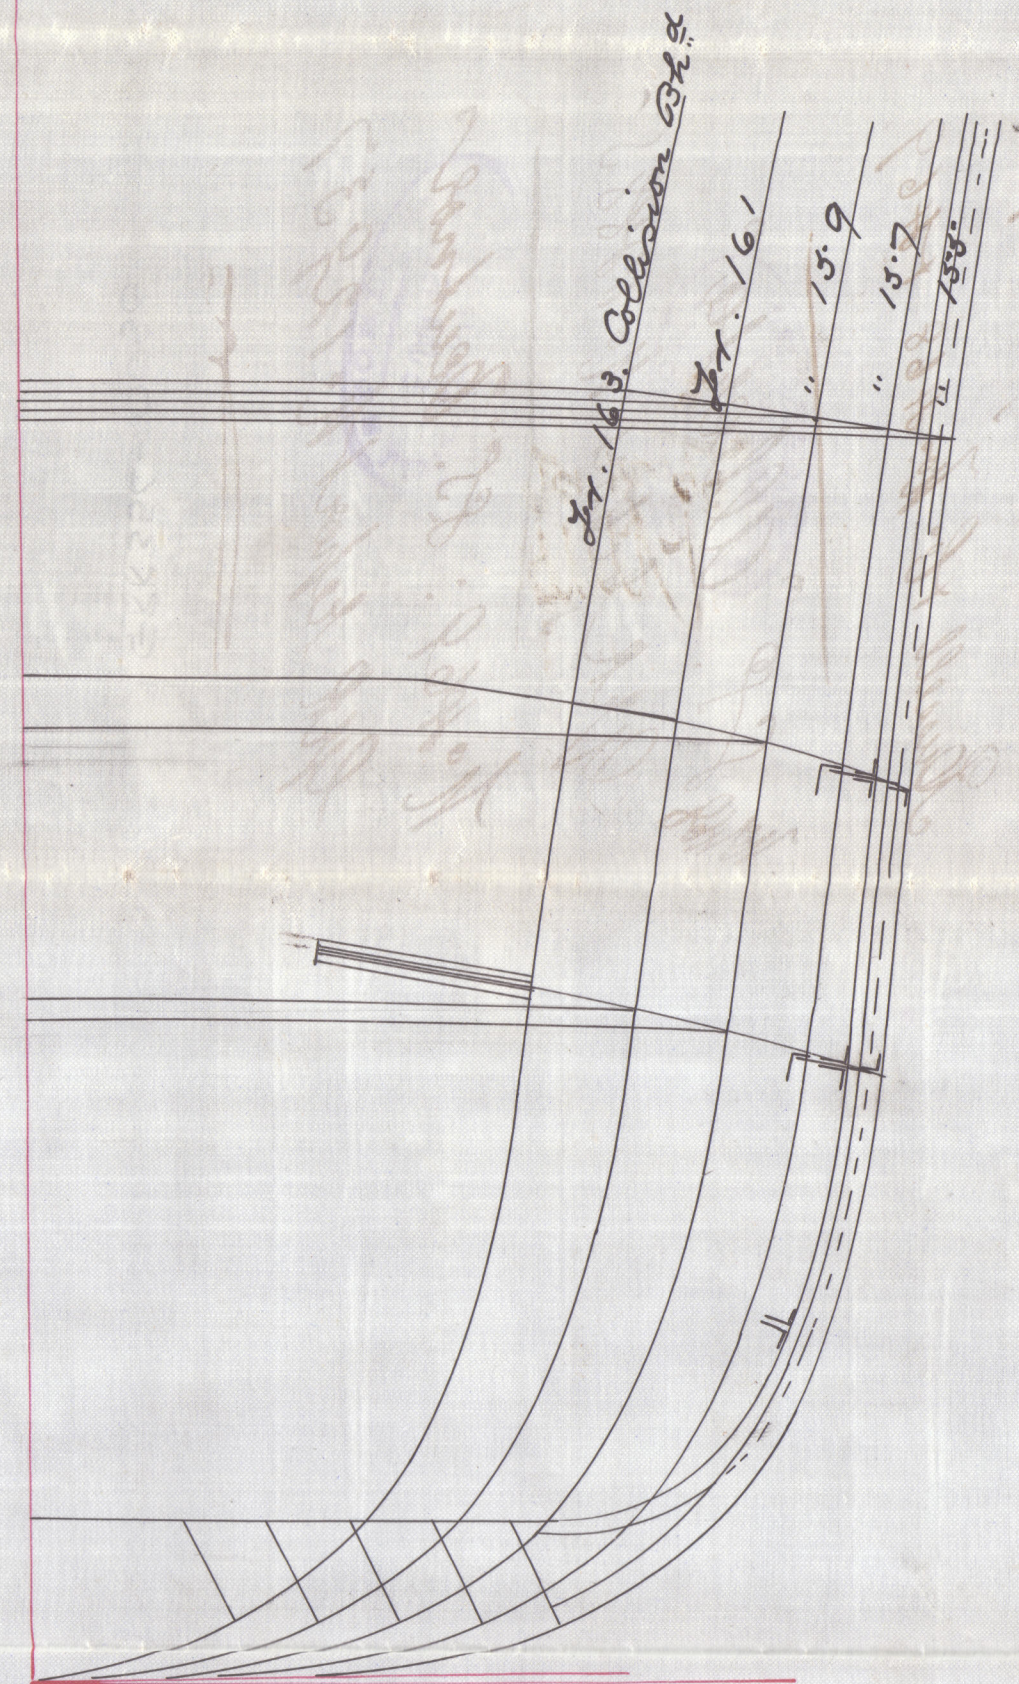


5-1-00

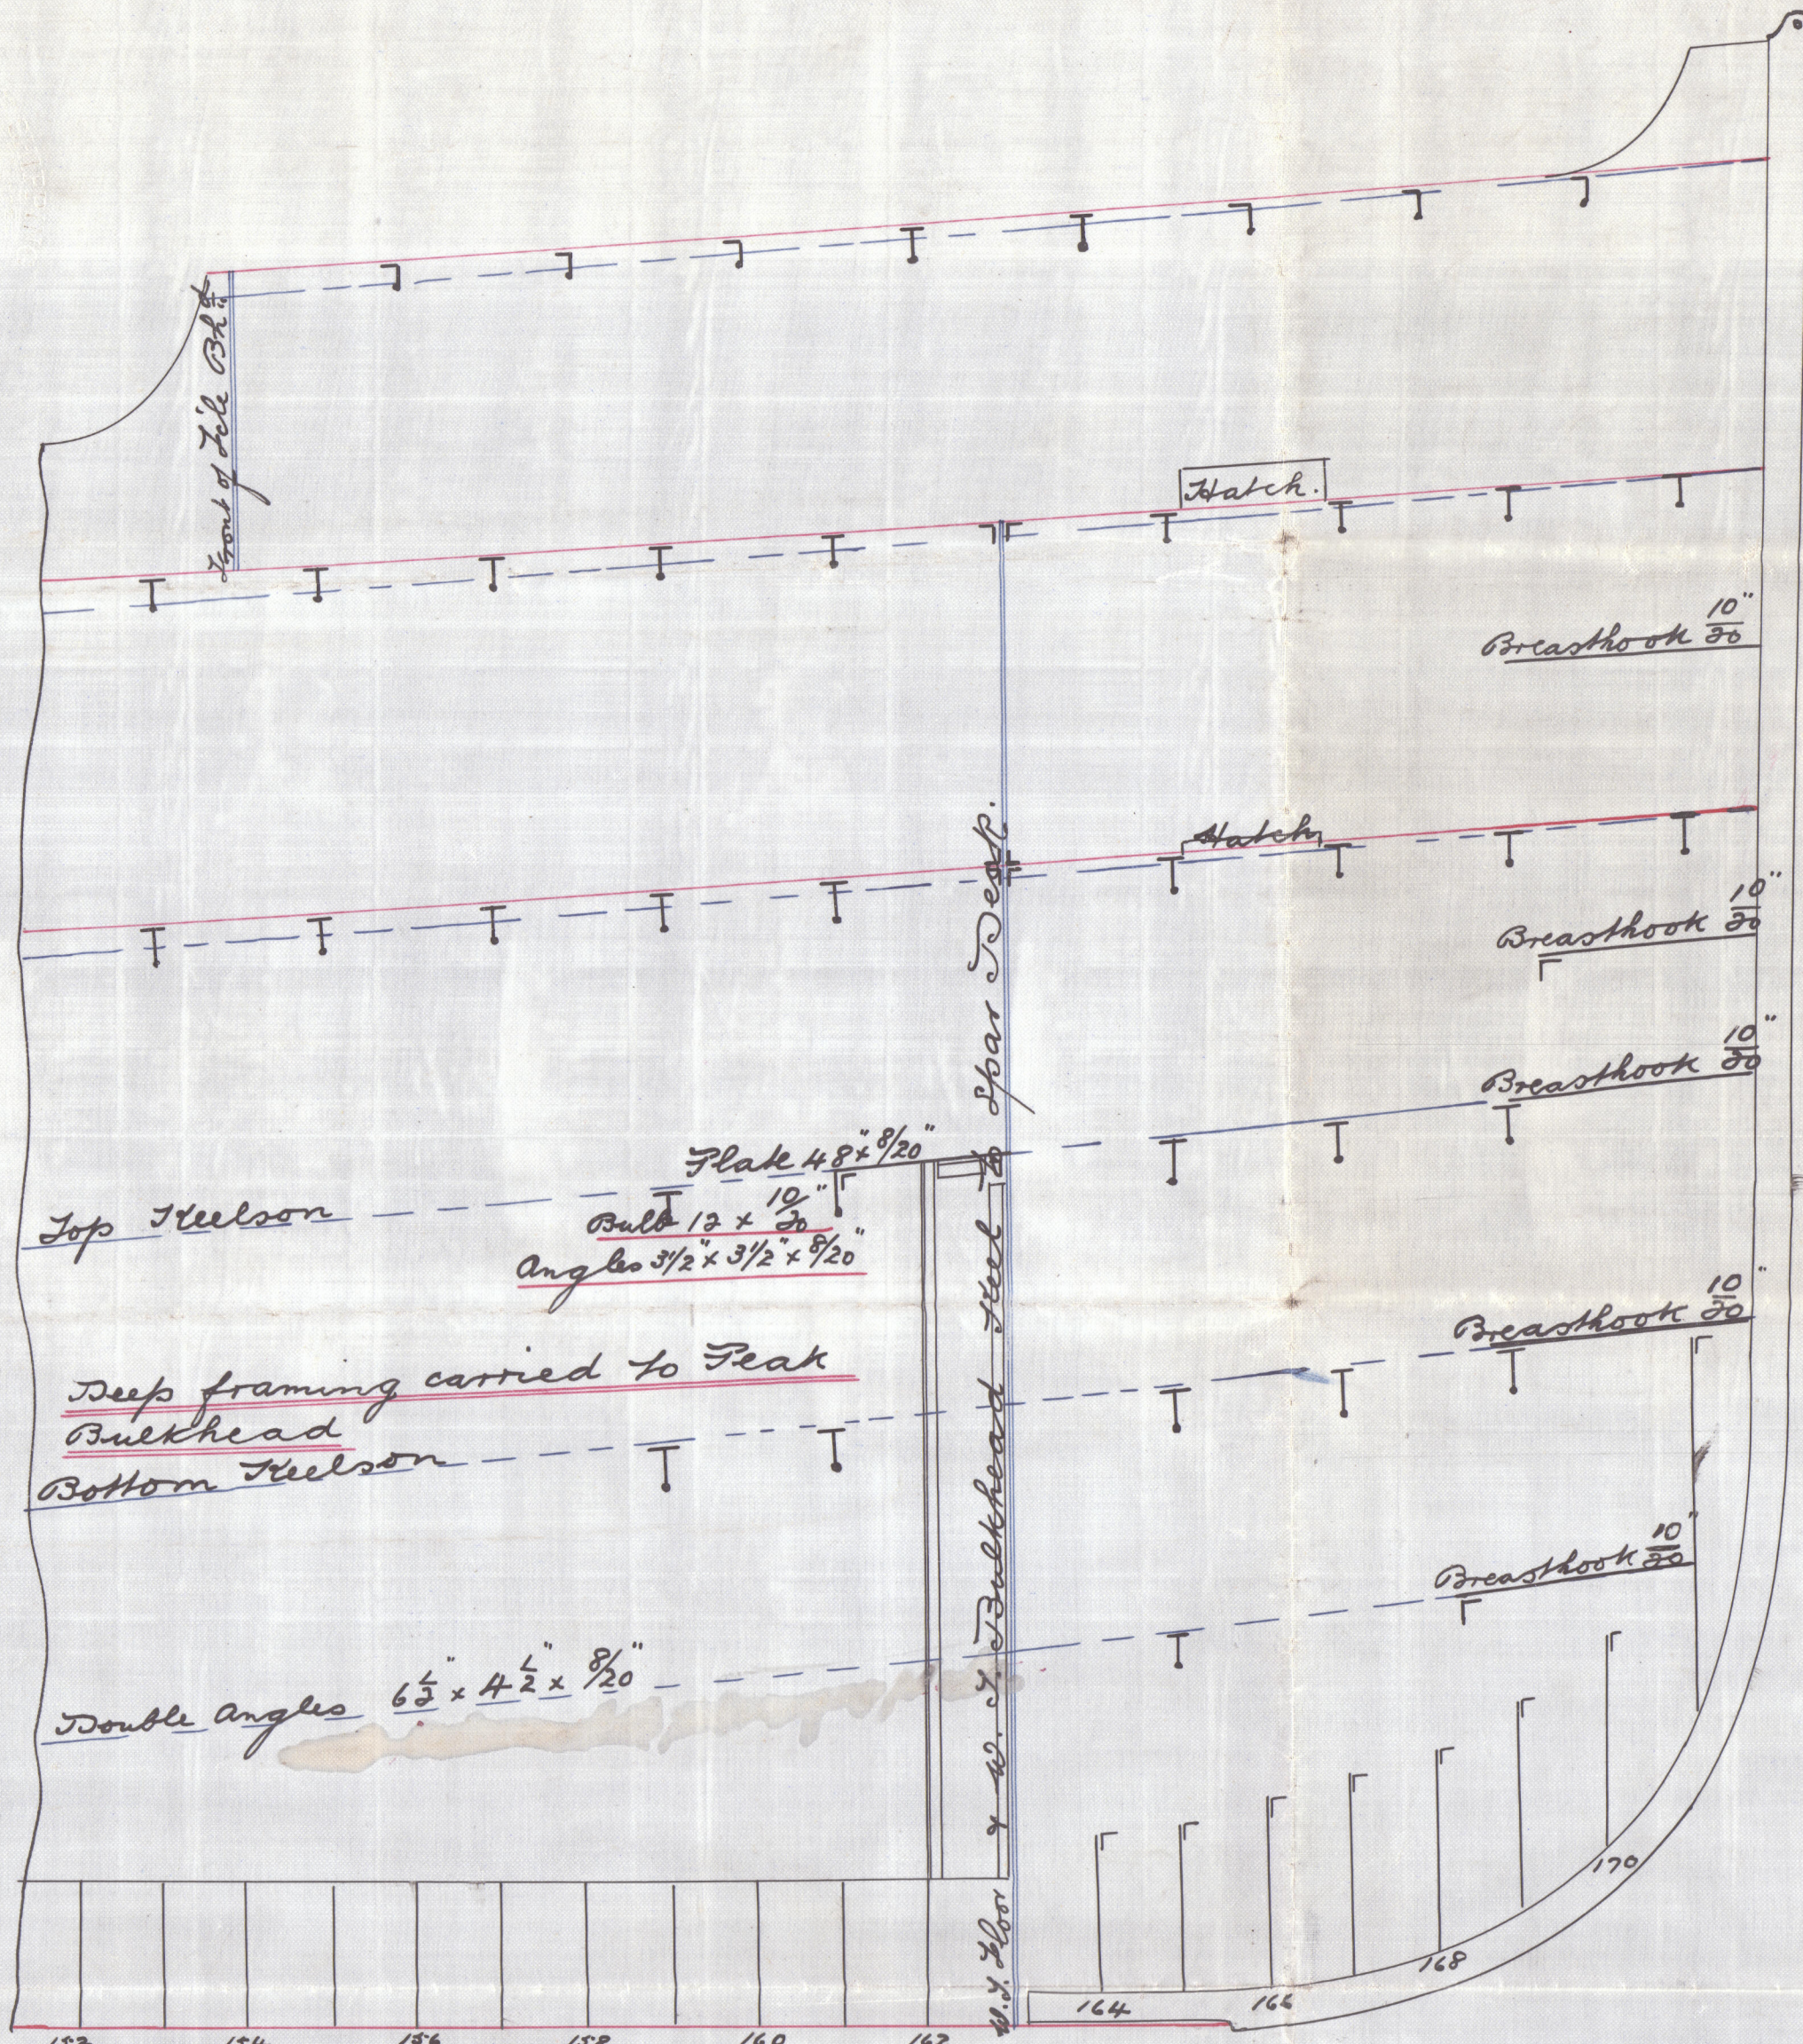

Amended

— Panting Arrangement —

— U. S. S. # 468-9 —

— Scale 1/4 inch = one foot. —



4/1/00



Amended Fauting Arrangements

Russell H. No. #68 + #69.

7/18/88 S.P. Alberta

GRK Report No. 12885

No. #69: S.S. Deutner

GRK Report No. 12937

GRK354-0050



© 2020

Lloyd's Register  
Foundation