

Received at Greenock office, 23-2- 1900

# Lloyd's Register of British and Foreign Shipping.

(Report on Vessel No. 12885 Port Greenock)

No. 7340 SHIP FORGINGS OR CASTINGS. S.S. "Alberta"

The words FORGINGS or CASTINGS, IRON or STEEL, should be struck out if not required.

I have to report that the undermentioned Iron or Steel Forgings or Castings, manufactured by The Portland Forge Coy of Kilmarnock for the Vessel No. 1468, being built by Messrs Russell & Coy of Port Glasgow have been inspected by me as set forth below, and found to be, so far as can be seen, Sound & efficient


Mark on Forgings.

Lloyd's  
No. 7340  
W.H.


William Hamilton  
Glasgow

	STERN FRAME.	RUDDER FRAME.	STEM.
Material* ...	<u>Scrap iron</u>		
How made ...	<u>Forged</u>		
Dimensions ...	<u>11 x 6 1/2</u>		
Progress on Inspection	<u>Forging &amp; smithing</u>		
Date when Inspected	<u>27/12/99 to 16/2/00</u>		

SKETCHES OF FRAMES SHOWING POSITION AND DESCRIPTION OF WELDS OF FORGINGS, OR PARTICULARS OF TESTS APPLIED TO CASTINGS.

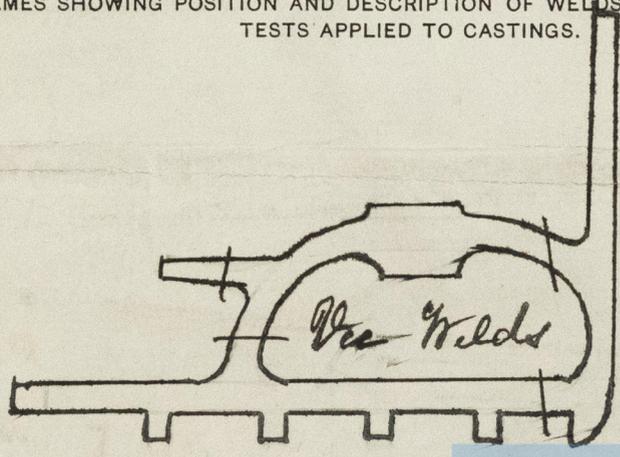

Fee (if any chargeable) £ : :  
To be paid at \_\_\_\_\_

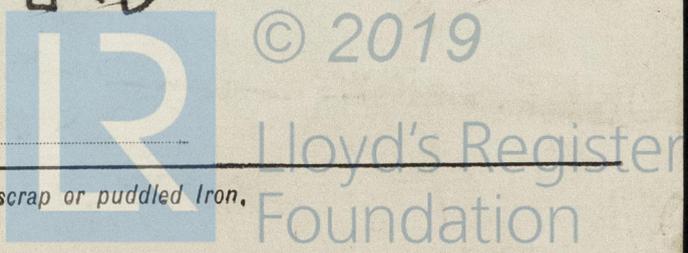

\* If of Iron, state whether scrap or puddled Iron.

Shew Post  
Russell's 468

1810

*[Faint handwritten text, possibly bleed-through from the reverse side]*

*[Faint handwritten text]*

*[Faint handwritten text]*



© 2019

Lloyd's Register  
Foundation

1001