



Proposed Compensation  
for Cutting Centre  
Keelson  
S.S. Princess Louise

Get report No 13287

GRK354-0111




© 2019

Lloyd's Register  
Foundation




*Proposed Compensation  
for cutting centre  
keelson  
S.S. Princess Louise  
See sketch No 13287*


OWING TO POSITION OF  
BOILER IT IS IMPOSSIBLE  
TO FIT A DEEPER ANGLE DOUBLE ANGLES  $4 \times 4 \times \frac{13}{20}$ "

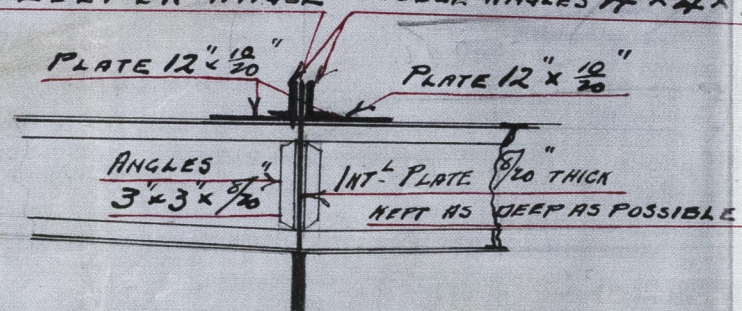

SECTION  
SCALE  $\frac{1}{2}$ " = 1 FOOT.

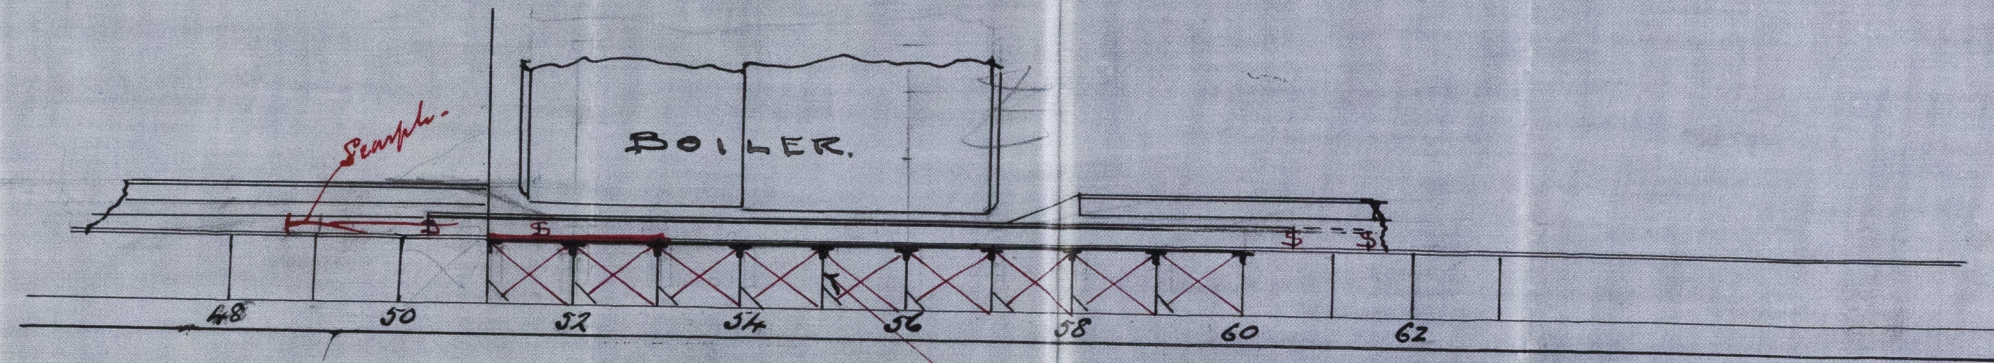

ELEVATION

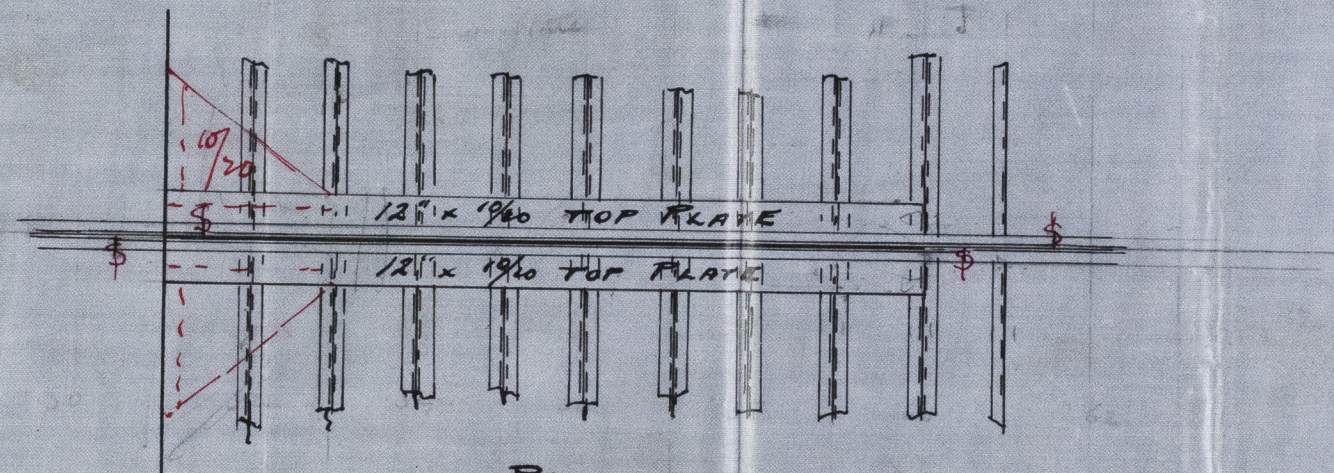

PLAN

PROPOSED COMPENSATION FOR CUTTING  
CENTRE KEELSON S.S. PRINCESS LOUISE

SCALE  $\frac{1}{4}$ " = 1 FOOT




Tracing No. 65



© 2019

Lloyd's Register  
Foundation

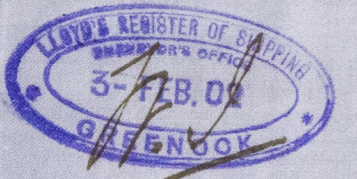

GRK354-C11