


SCALE  $\frac{1}{2}$  INCHES = 1 FOOT

Muir & Houston  
Donkey Boilers


N<sup>o</sup> 539  
Boiler W.P.

Amended Plan

cf Mopsa

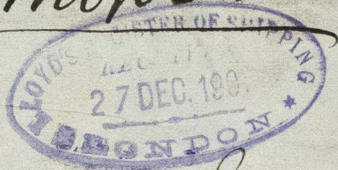

Glasgow 1st Dec 1900  
GRK 13337

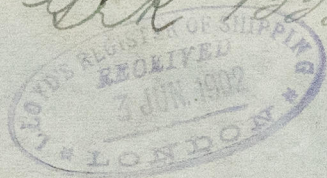

GRK354-0124



© 2020

Lloyd's Register  
Foundation