


BREAK BULKHEAD

S.S. N°187.

SCALE $\frac{1}{4}$ INCH = 1 FOOT.

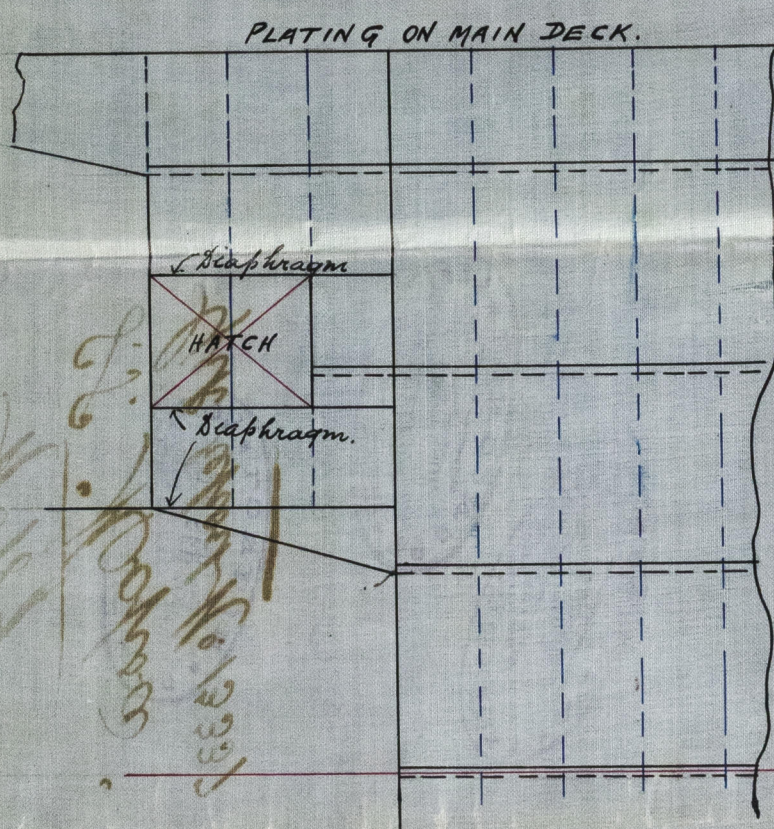



PLATING ON MAIN DECK.

J. A. L.
26/9/07

Grusch
05/9/01



06
Lloyd's Register
Foundation

GRK 354-C125

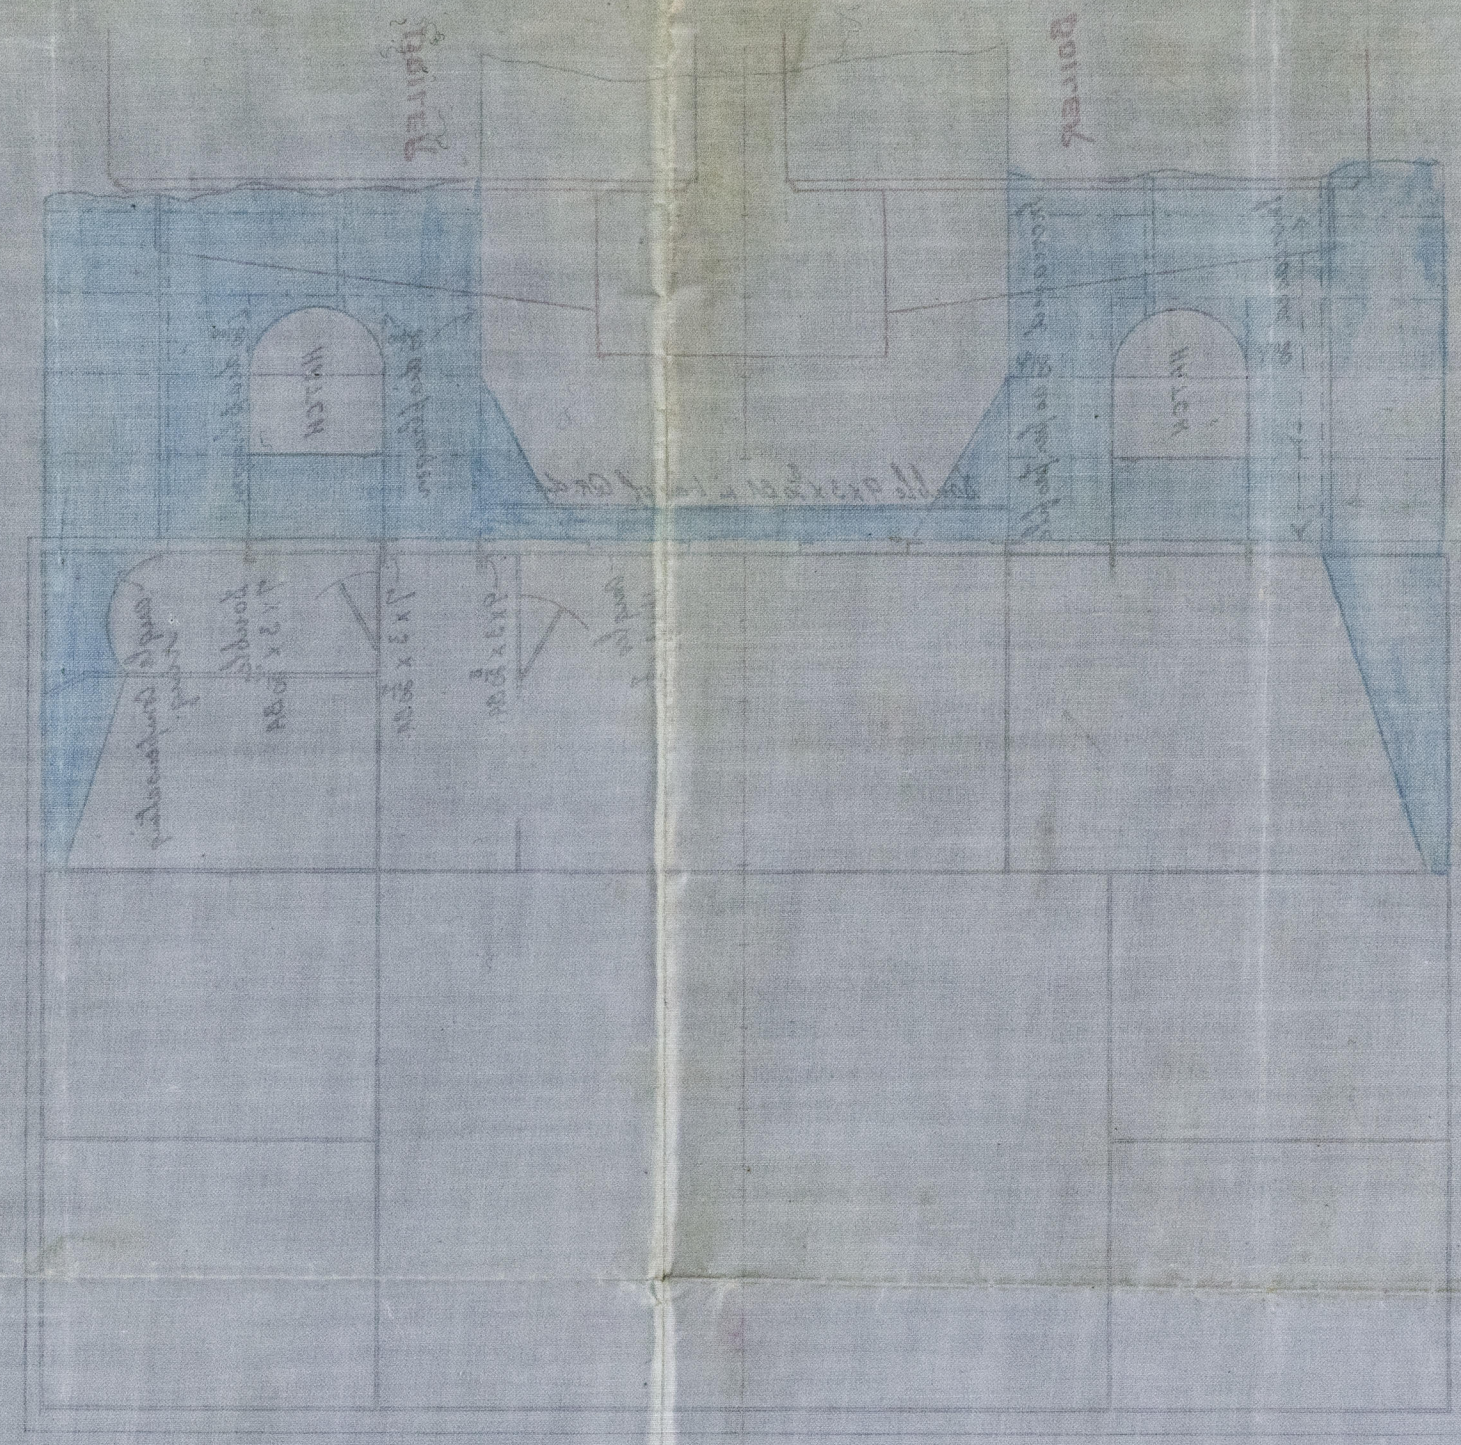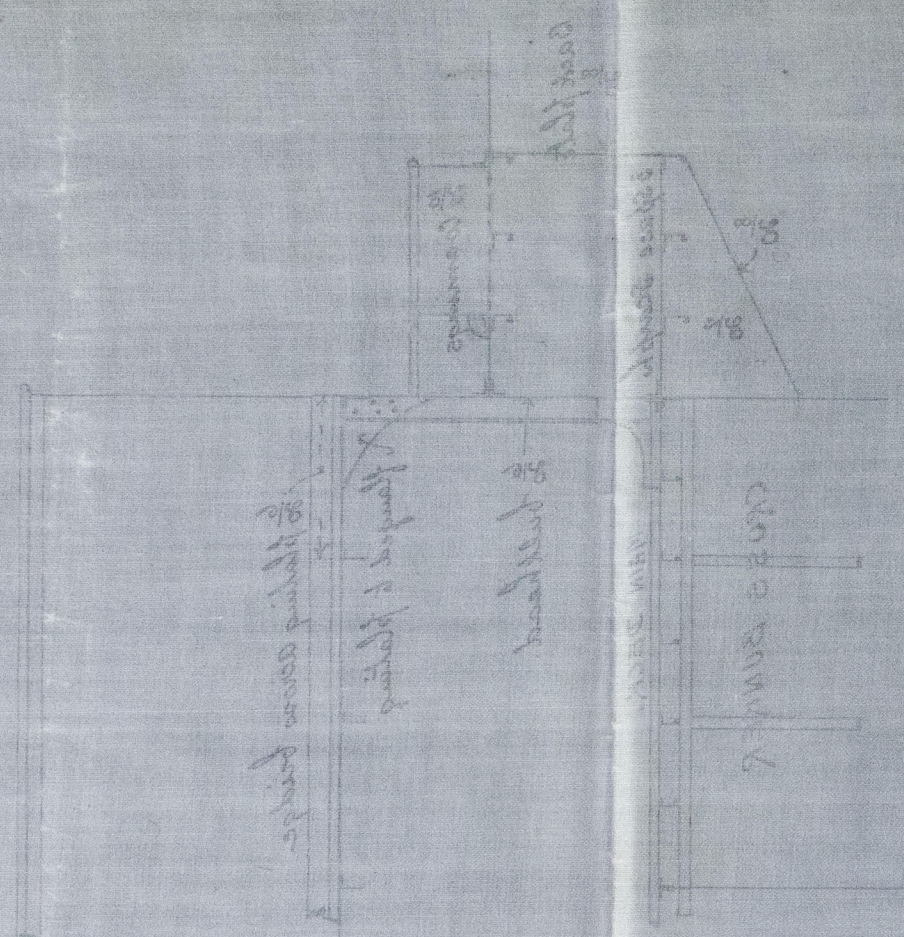

Break Bulkhead
Stiffening
Murdoch & Murray
No 187
S.P. Moors
C/Lt. Report No 13337

GRK354-0125

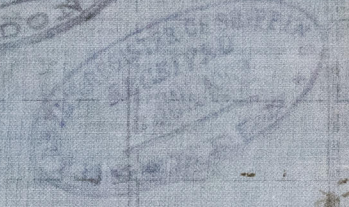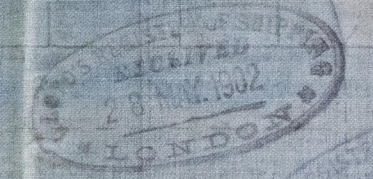

22. N. 187
BREAK BULKHEAD
STIFFENING ON