


20.11.01

PUMPING ARRANGEMENT
S.S. N° 187
 TONNAGE UNDER DECK APT. 675.

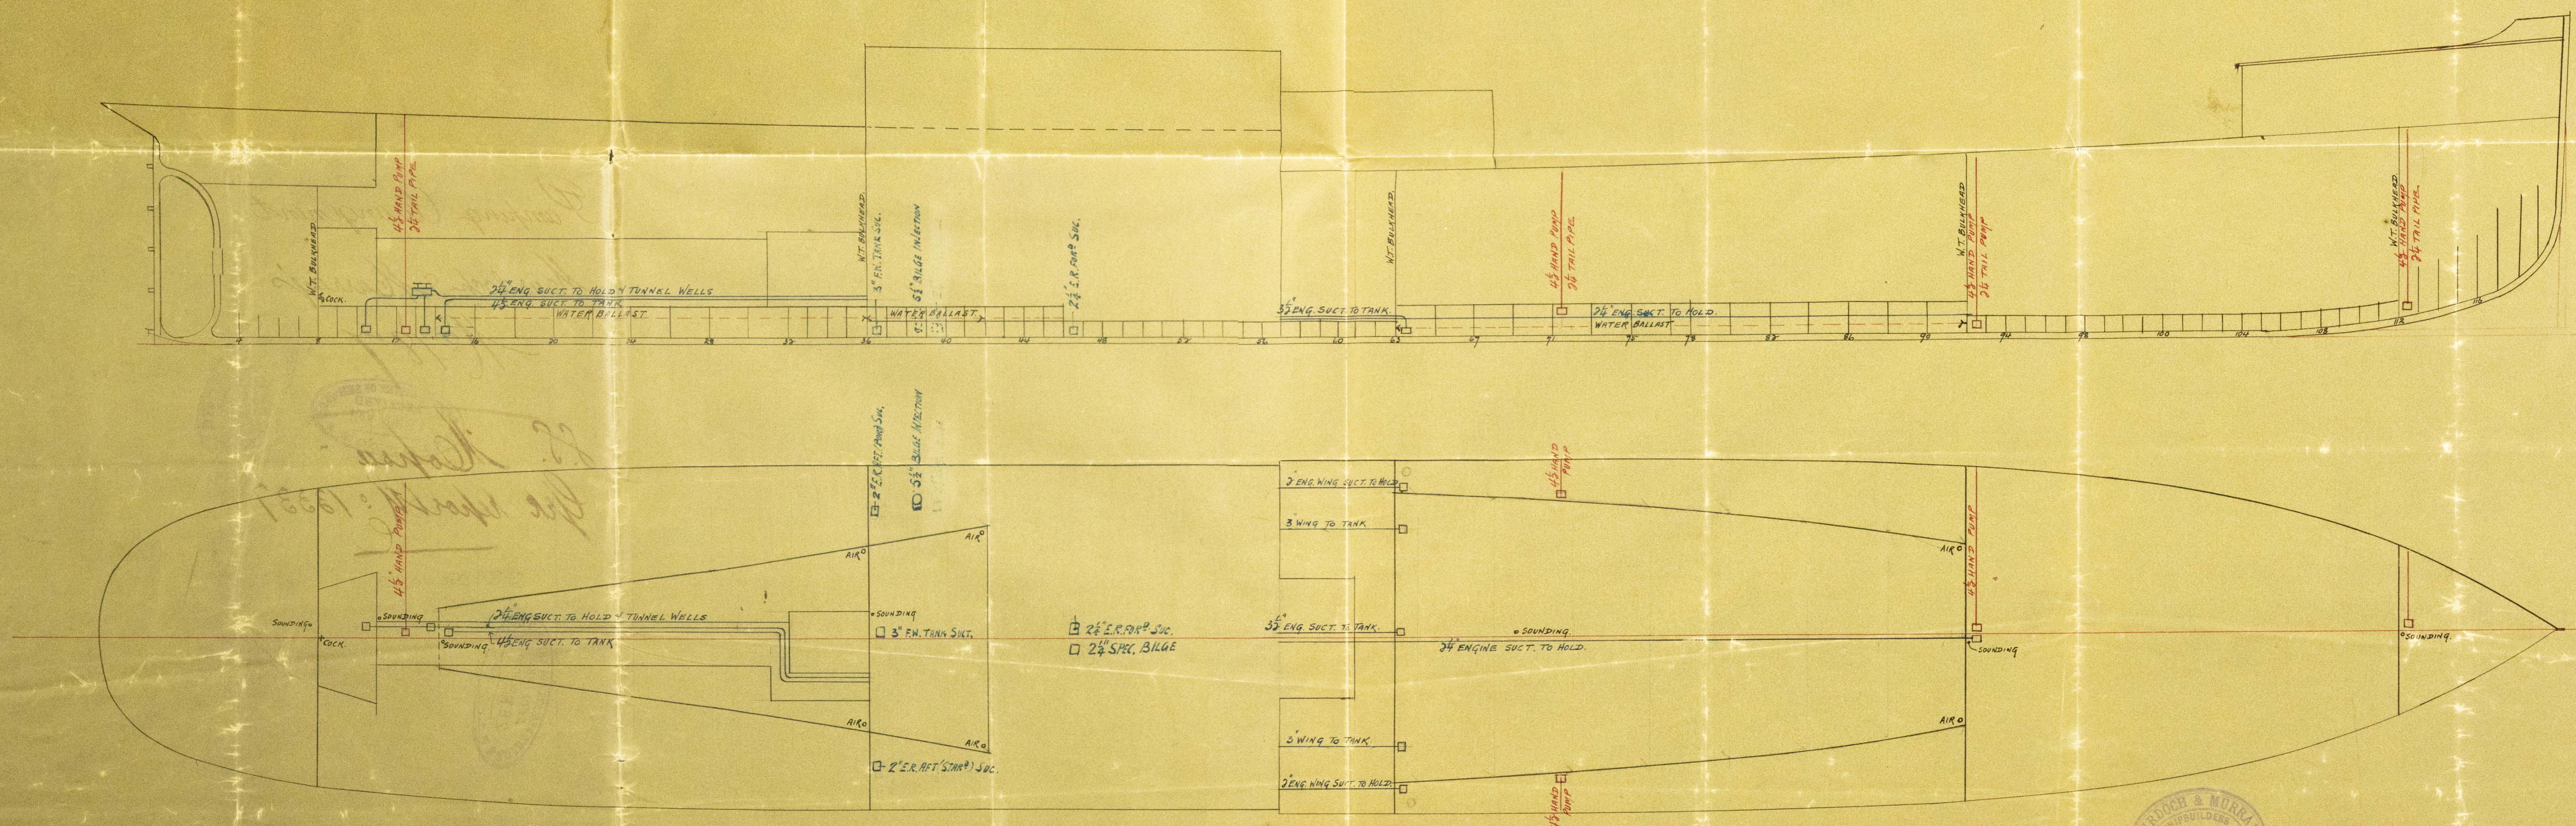

WEDDOCH & MURRAY
 SHIPBUILDERS
 DRAWING OFFICE
 6th Nov. 1901
 FORT-GLASGOW

20.11.01
 2080
 Lloyd's Register
 Foundation
 GRK 354-0129

Pumping Arrangement.

Murdoch & Murray's

No 187

S.S. Mopsa

Grk report No 13337

GRK 354-0129



© 2020

Lloyd's Register
Foundation