
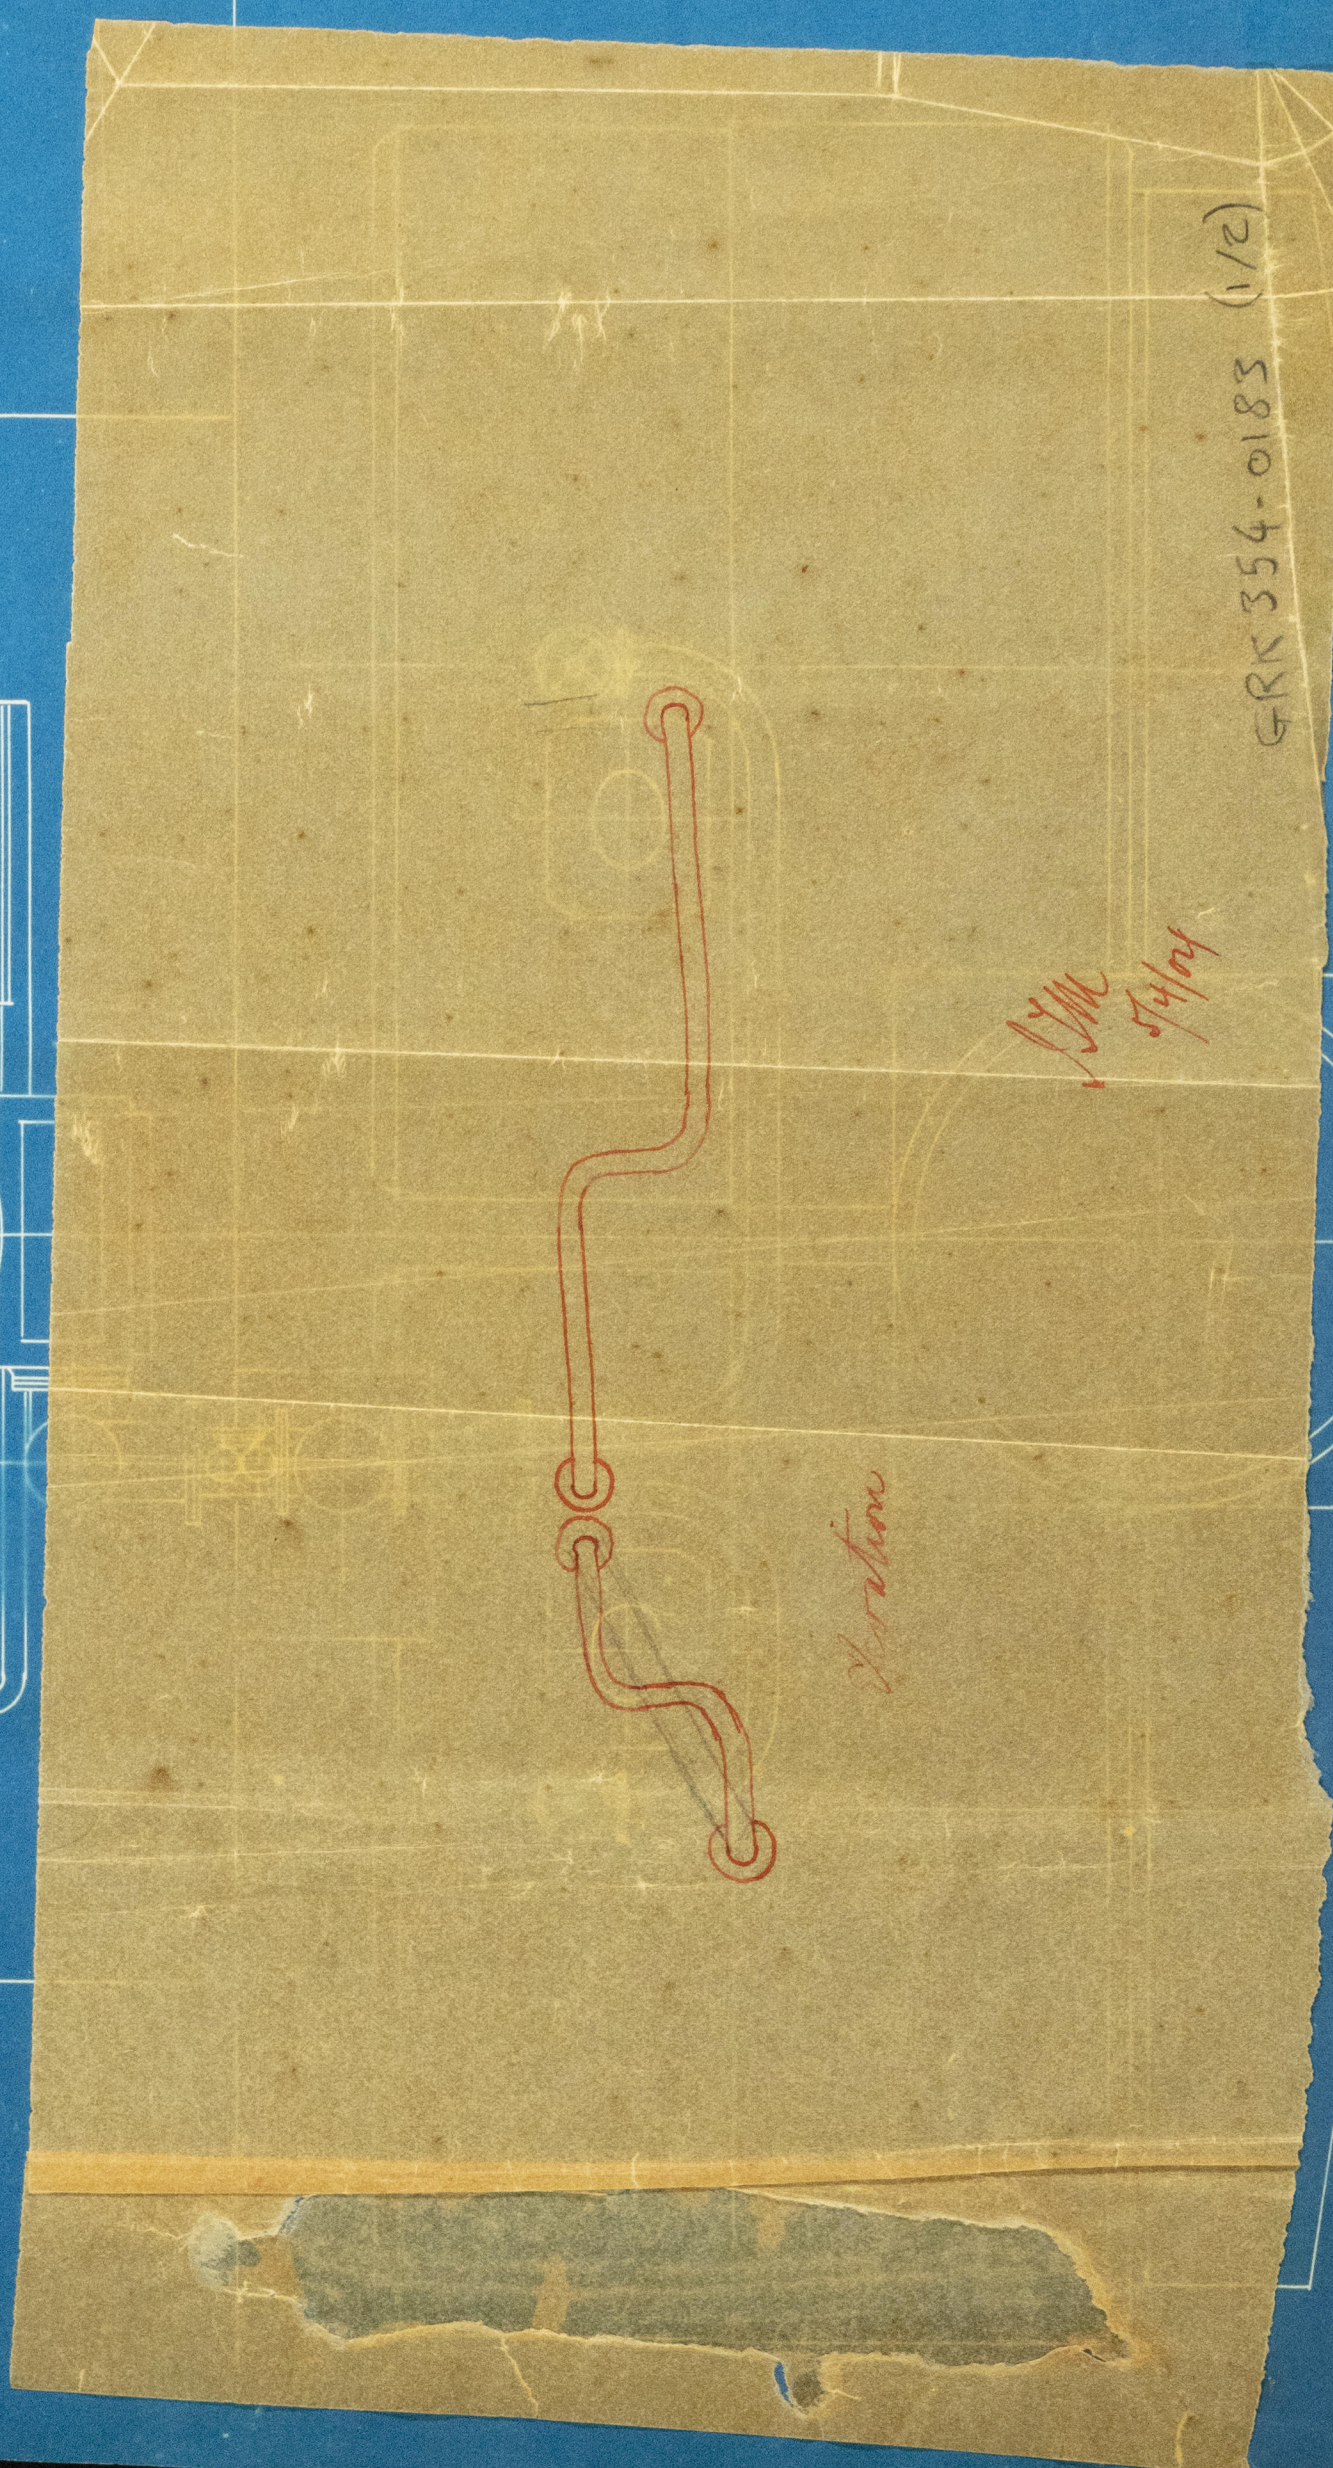
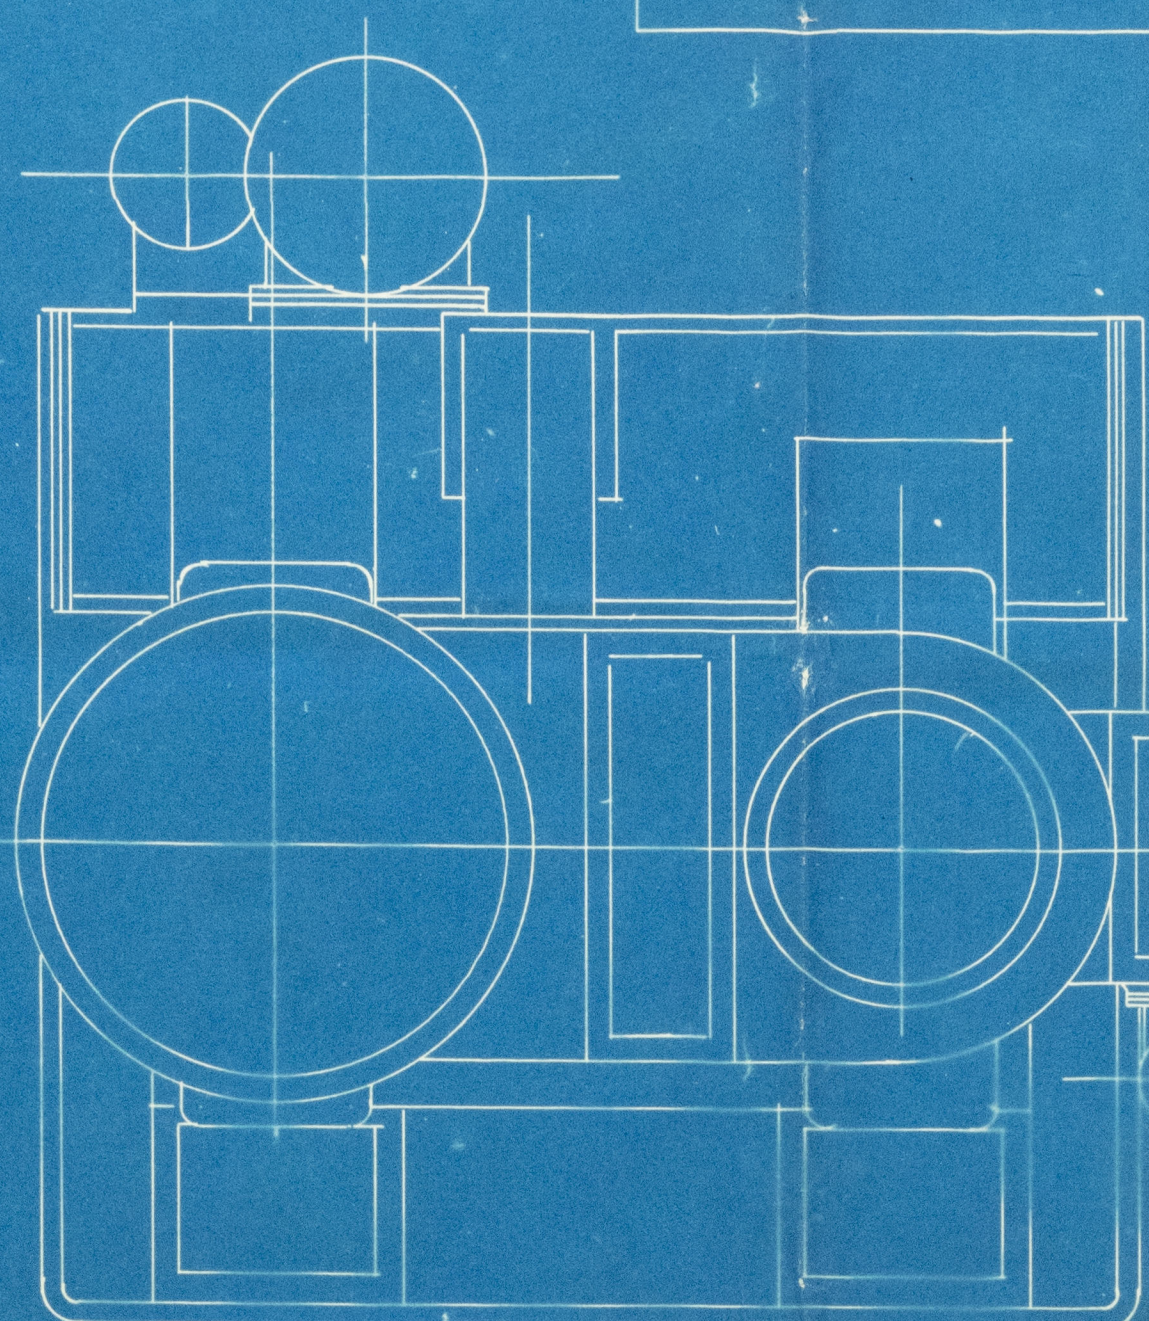


6. 4. 04

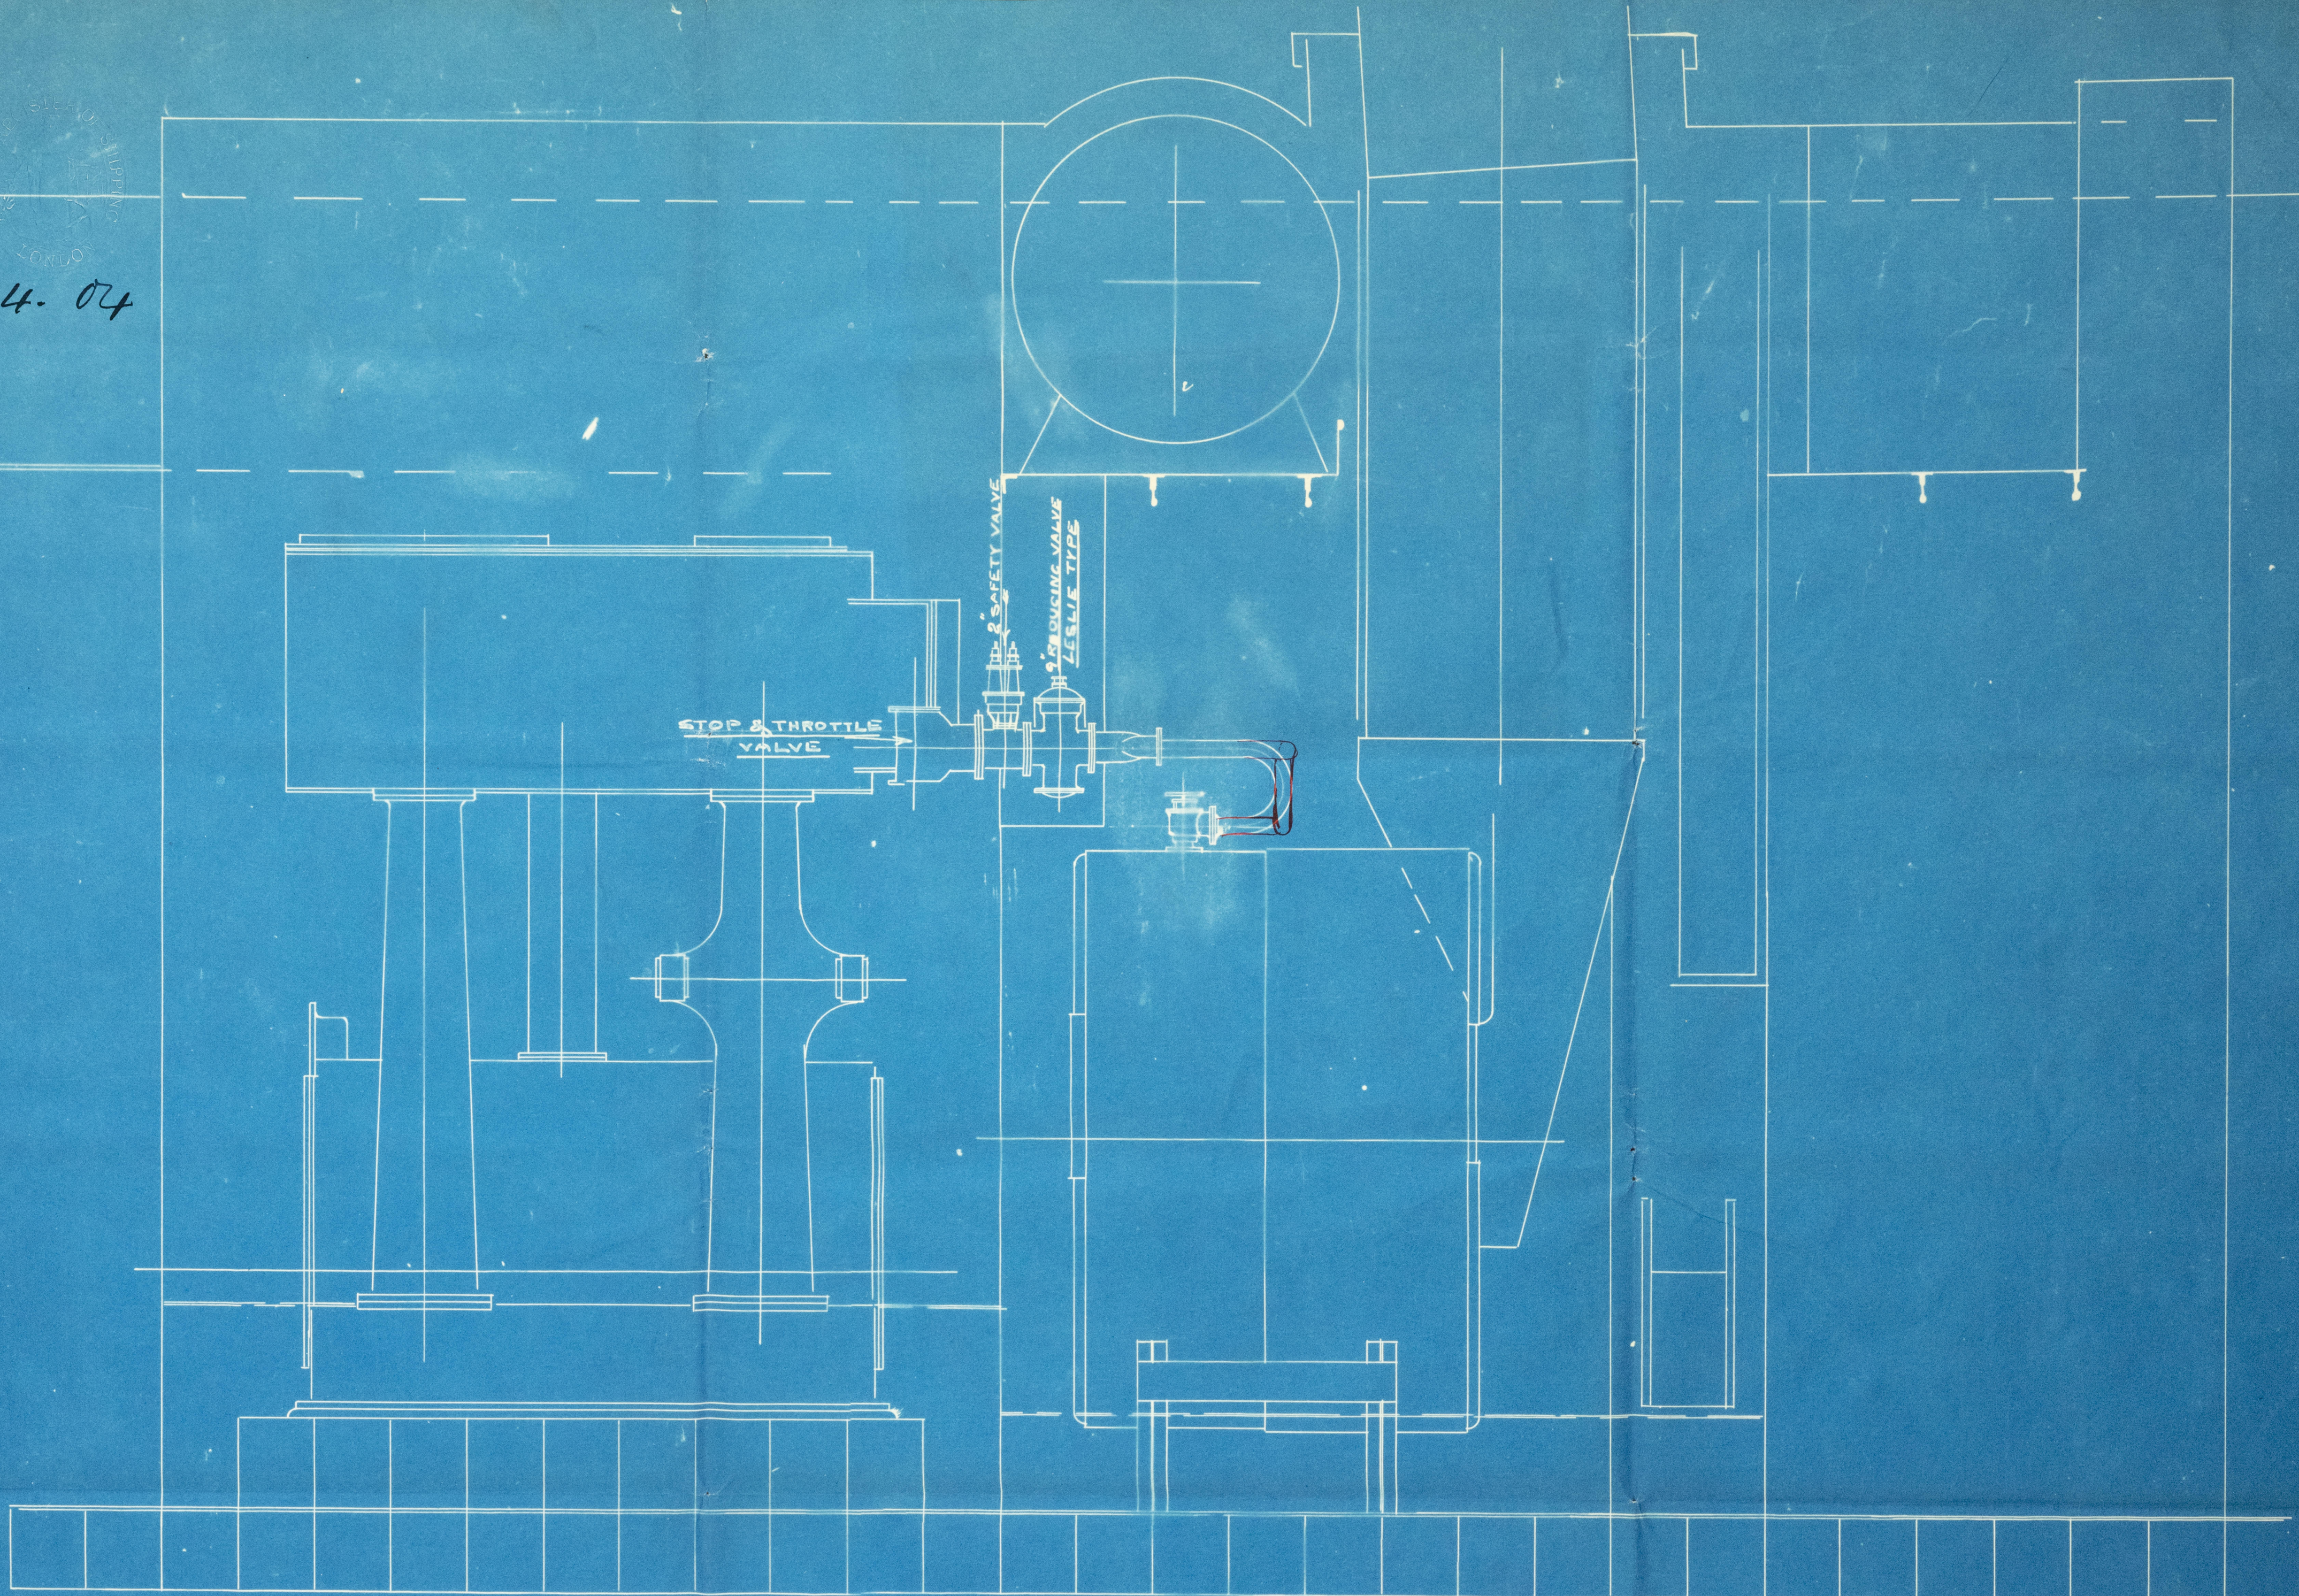


S.S. BRIARDENE
AMENDED PLAN
SHOWING ARRANGEMENT
OF STEAM PIPES
SCALE 3/4" = 1 FOOT

W.R.A. 14/4/04

Appd 7/4/04




See elevation attached
J.M. 5/4/04

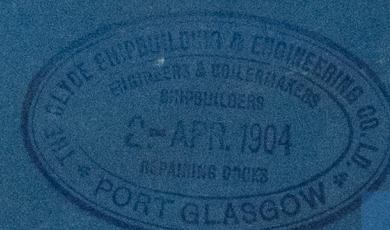

LR

GRK 354-0183 (2/2)

6. 4. 04

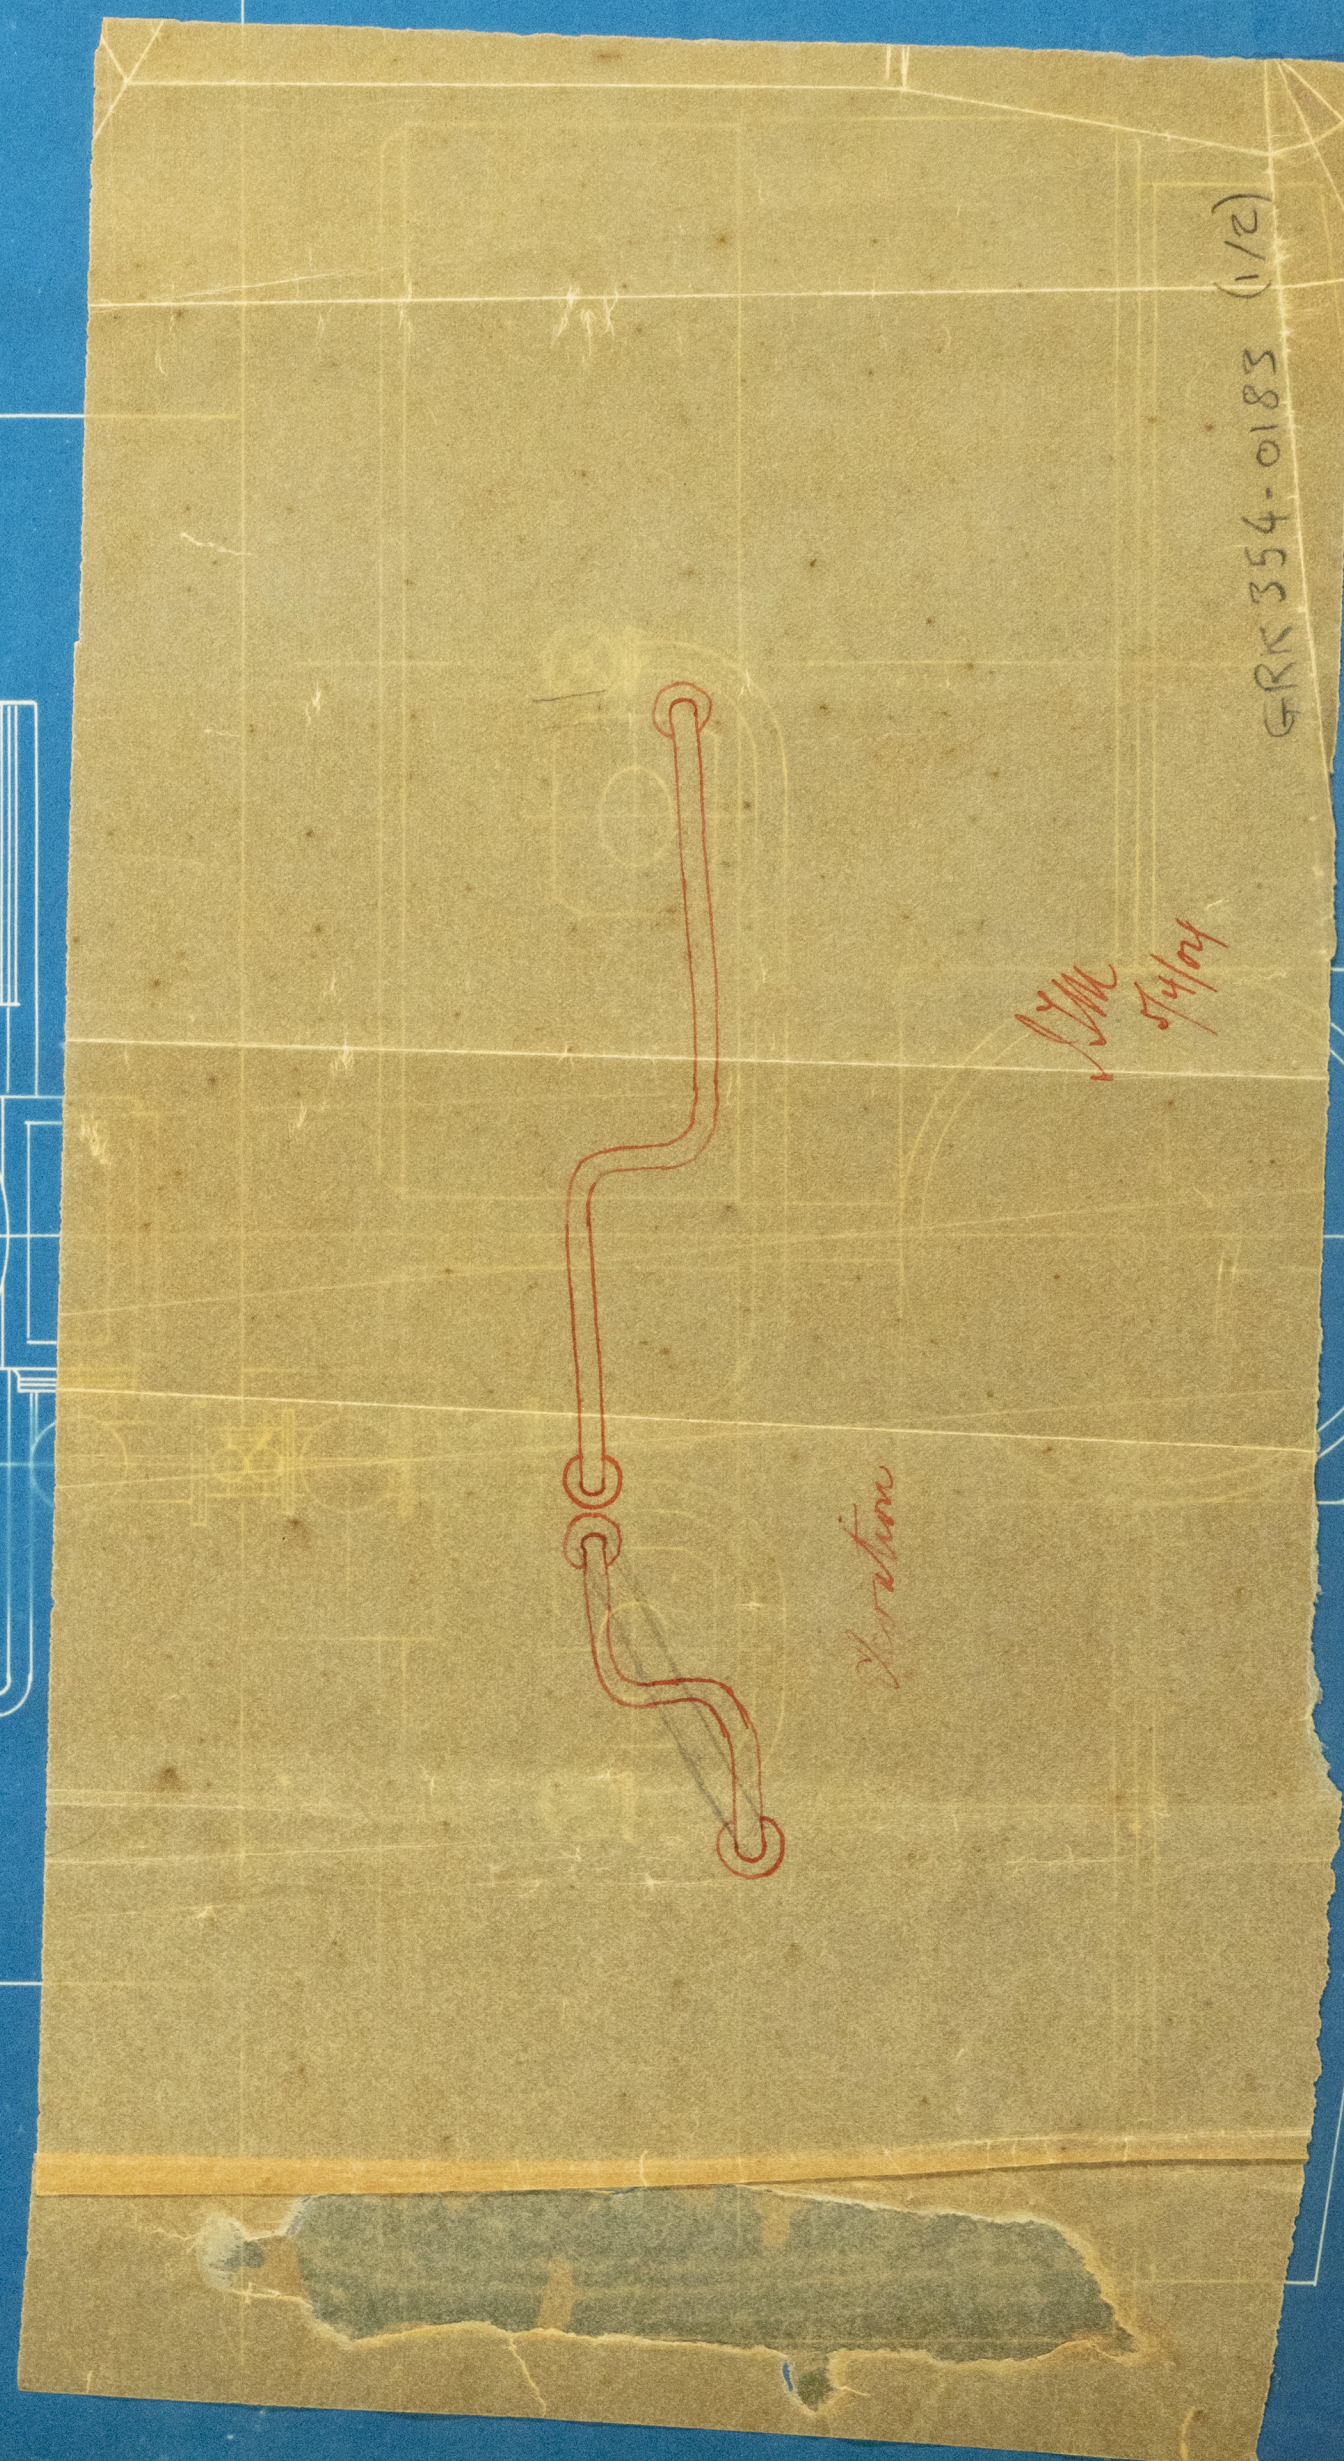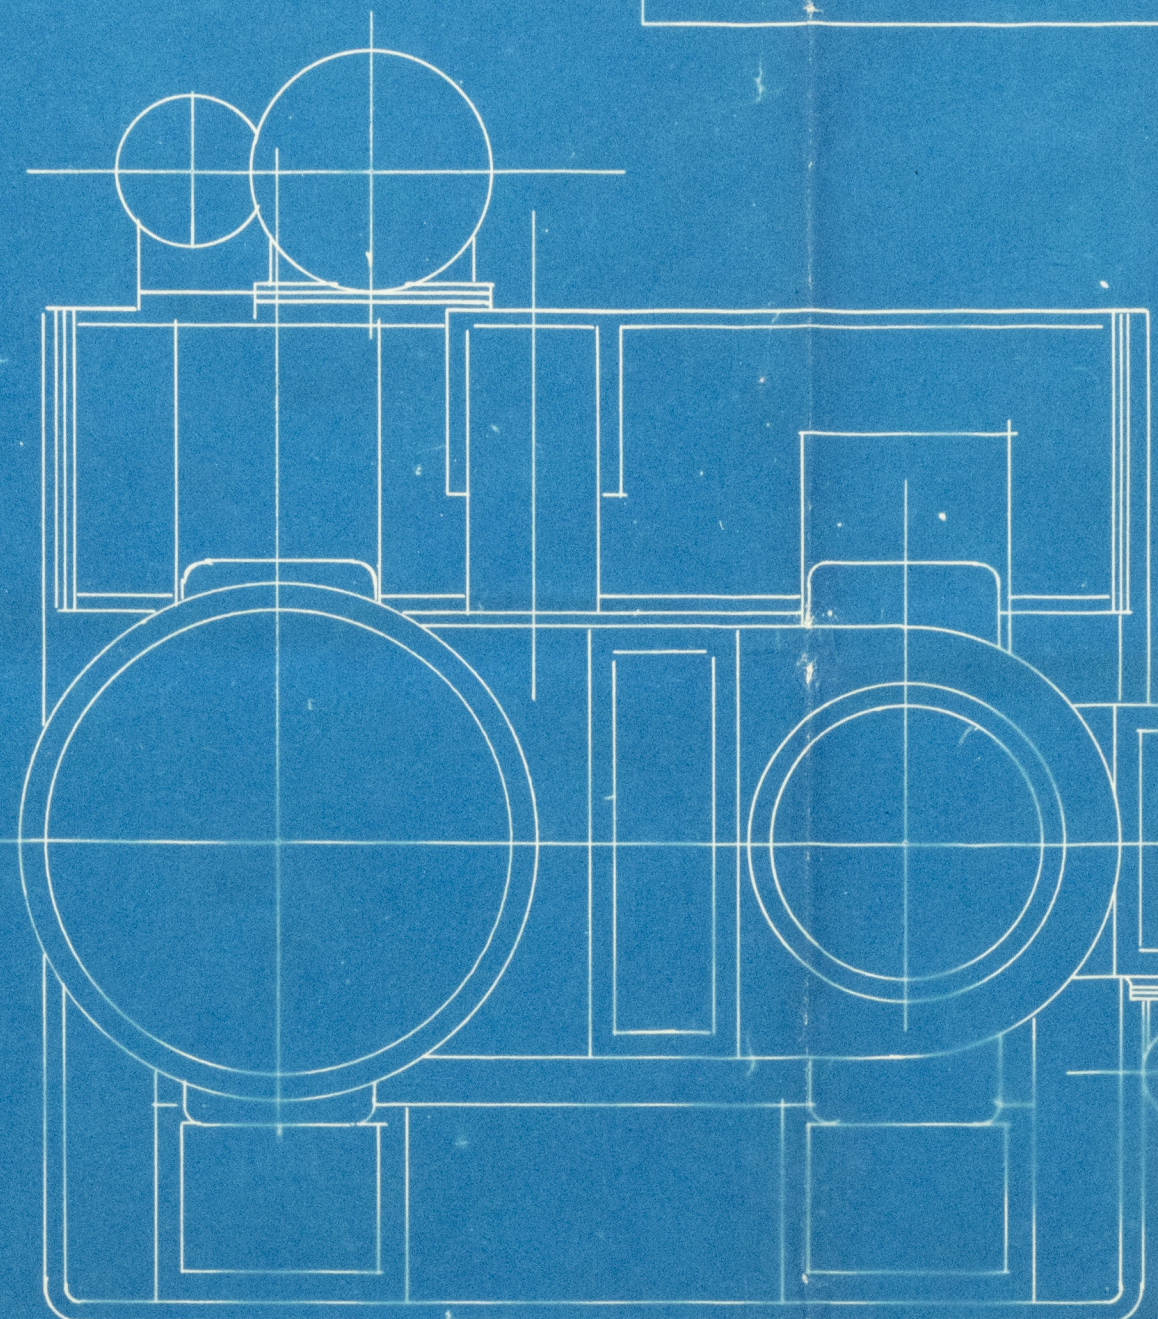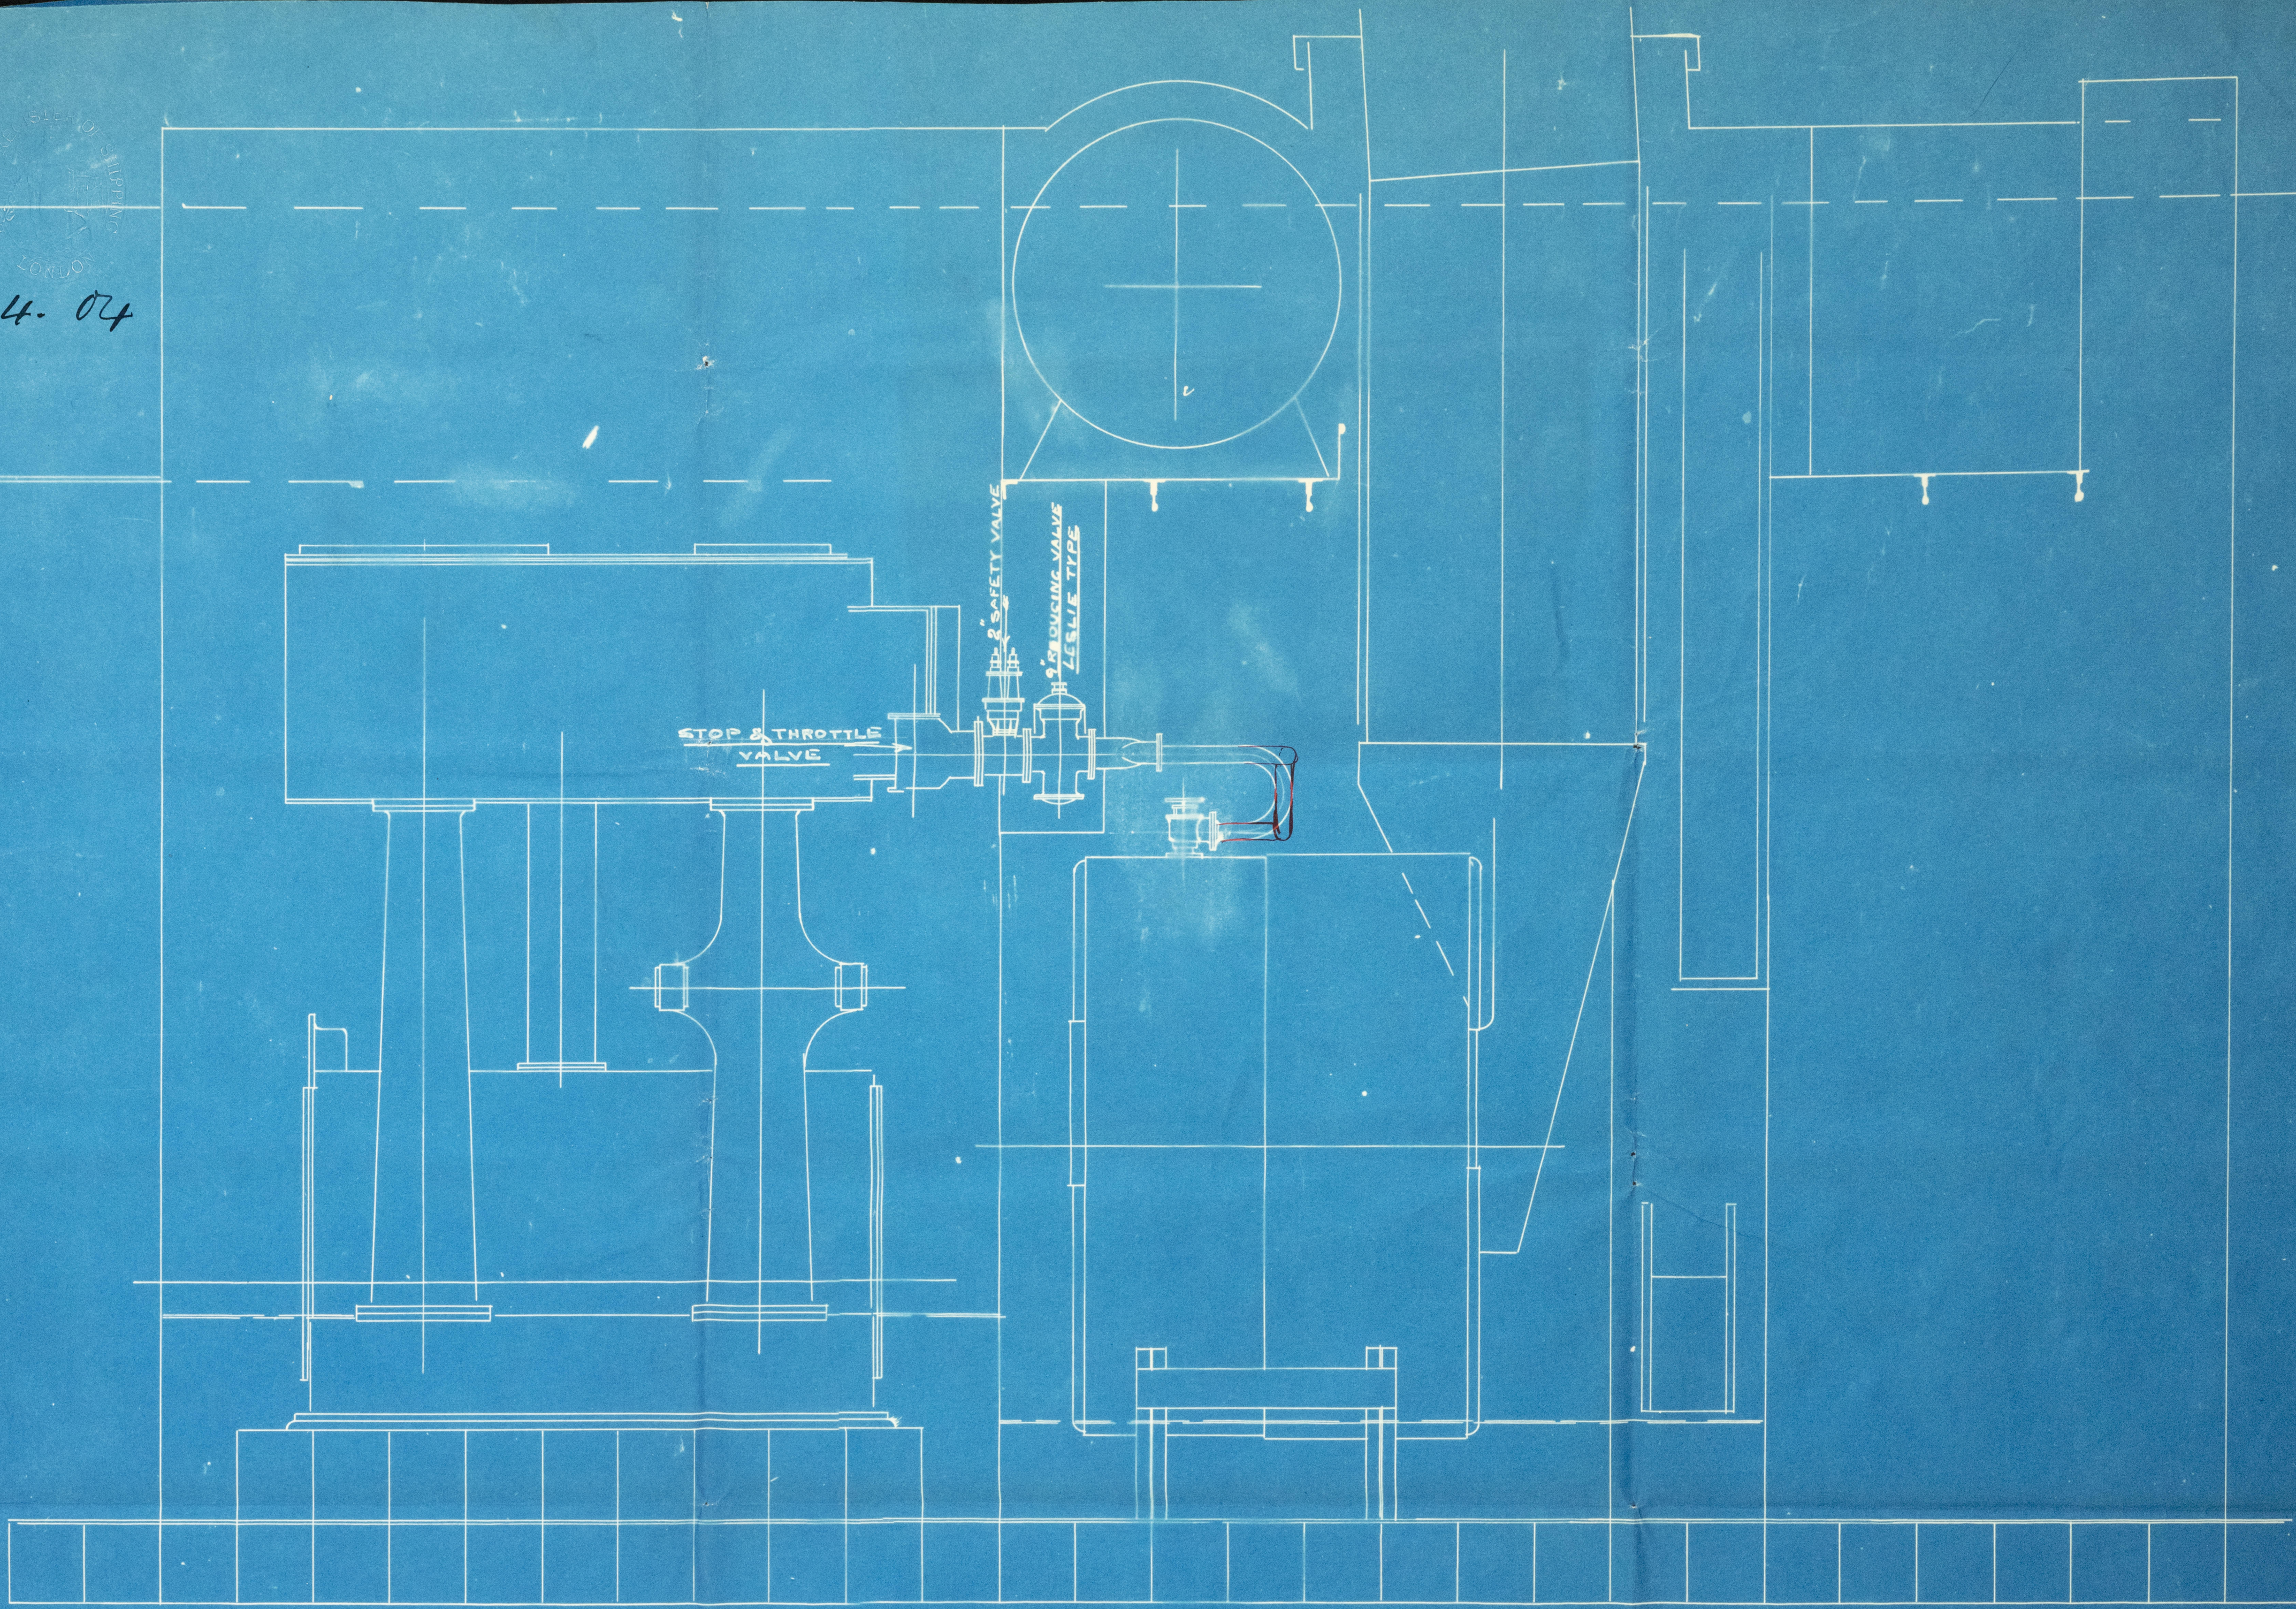

SS. BRIARDENE

AMENDED PLAN

SHOWING ARRANGEMENT

OF STEAM PIPES

SCALE 3/8" = 1 FOOT

W.R. 11/10/04

App 7/14/04

See elevation attached

5/4/04



Printed by
The CLYDE SHIPBUILDING AND ENGINEERING CO., Ltd.,
For ENCLOSURE to
M. Lloyd's Surveyors

GRK 354-0183 (2/2)