

WPK.
23rd March 1904.

100-100-100

25.3.04

From

GRK 354-01 86 (2/2)

The CLYDE SHIPBUILDING AND ENGINEERING CO., Ltd.,

FOR ENCLOSURE to

M. Lloyd's Surveyors

Donkey Boiler
S.O. 328

by


Clyde Ship & Dry Dock

for

to Buvaranie.

120 lbs working pressure

Test Report No. 13956

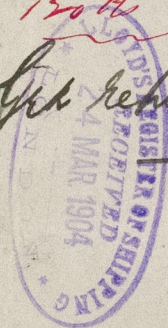

No 635
LLOYDS TEST.
240 lbs.
6/5/04 W.R.A.



GRK354-0186



© 2020

Lloyd's Register
Foundation