

4.9.07  
5:10:07

T.S.S. "ANGLIA"


N° 266

MIDSHIP SECTION

SCALE 1/2" = ONE FOOT.

SKETCH SHOWING COMPLETE STEEL LOWER DECK ALL FORE & AFT,

& SIDE STRINGER IN LIEU OF ORLOP DECK IN AFTER HOLD

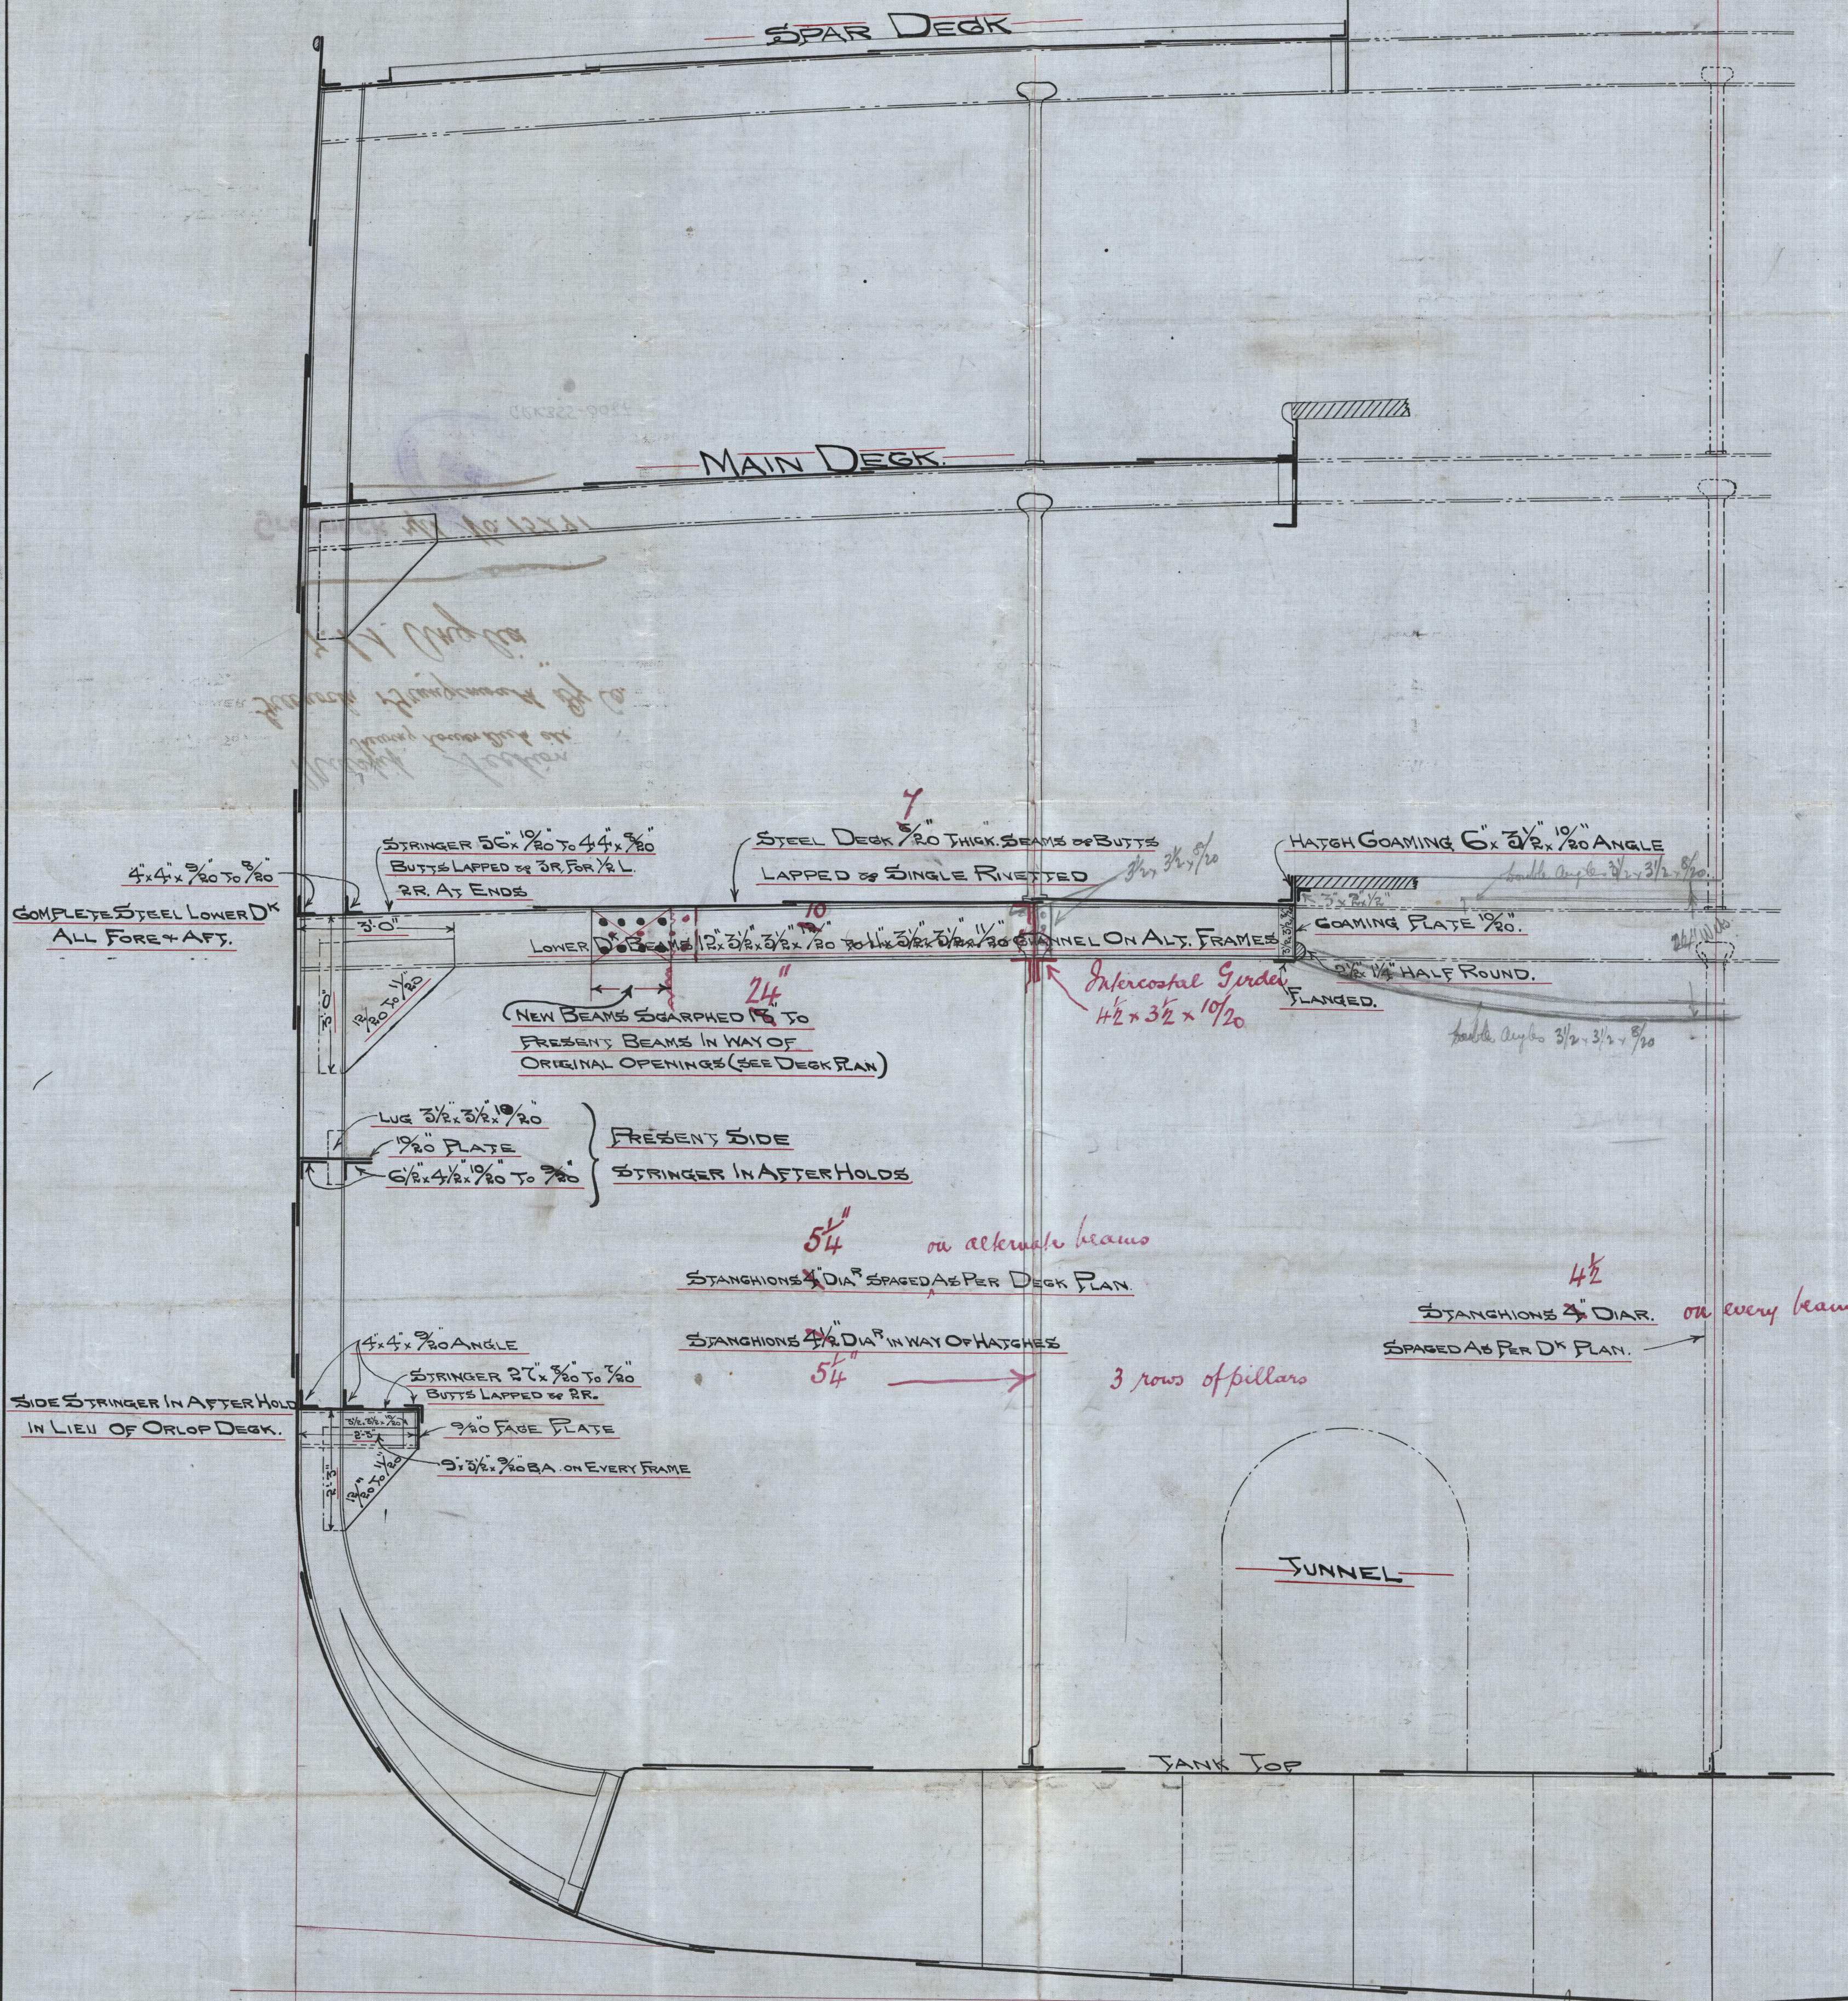

THE GREENOCK & GRANGEMOUTH DOCKYARD COY LTD.

GREENOCK.



© 2020

Lloyd's Register  
Foundation

GRK 355-0087



Midship Section  
Showing Lower Deck etc.  
Greenock & Grangemouth Dry Co.  
7.1.1. Anglia

Greenock 4/1 No. 15291

GRK355-0087



© 2020

Lloyd's Register  
Foundation