
 


31.7.07
4.9.07
5.10.07


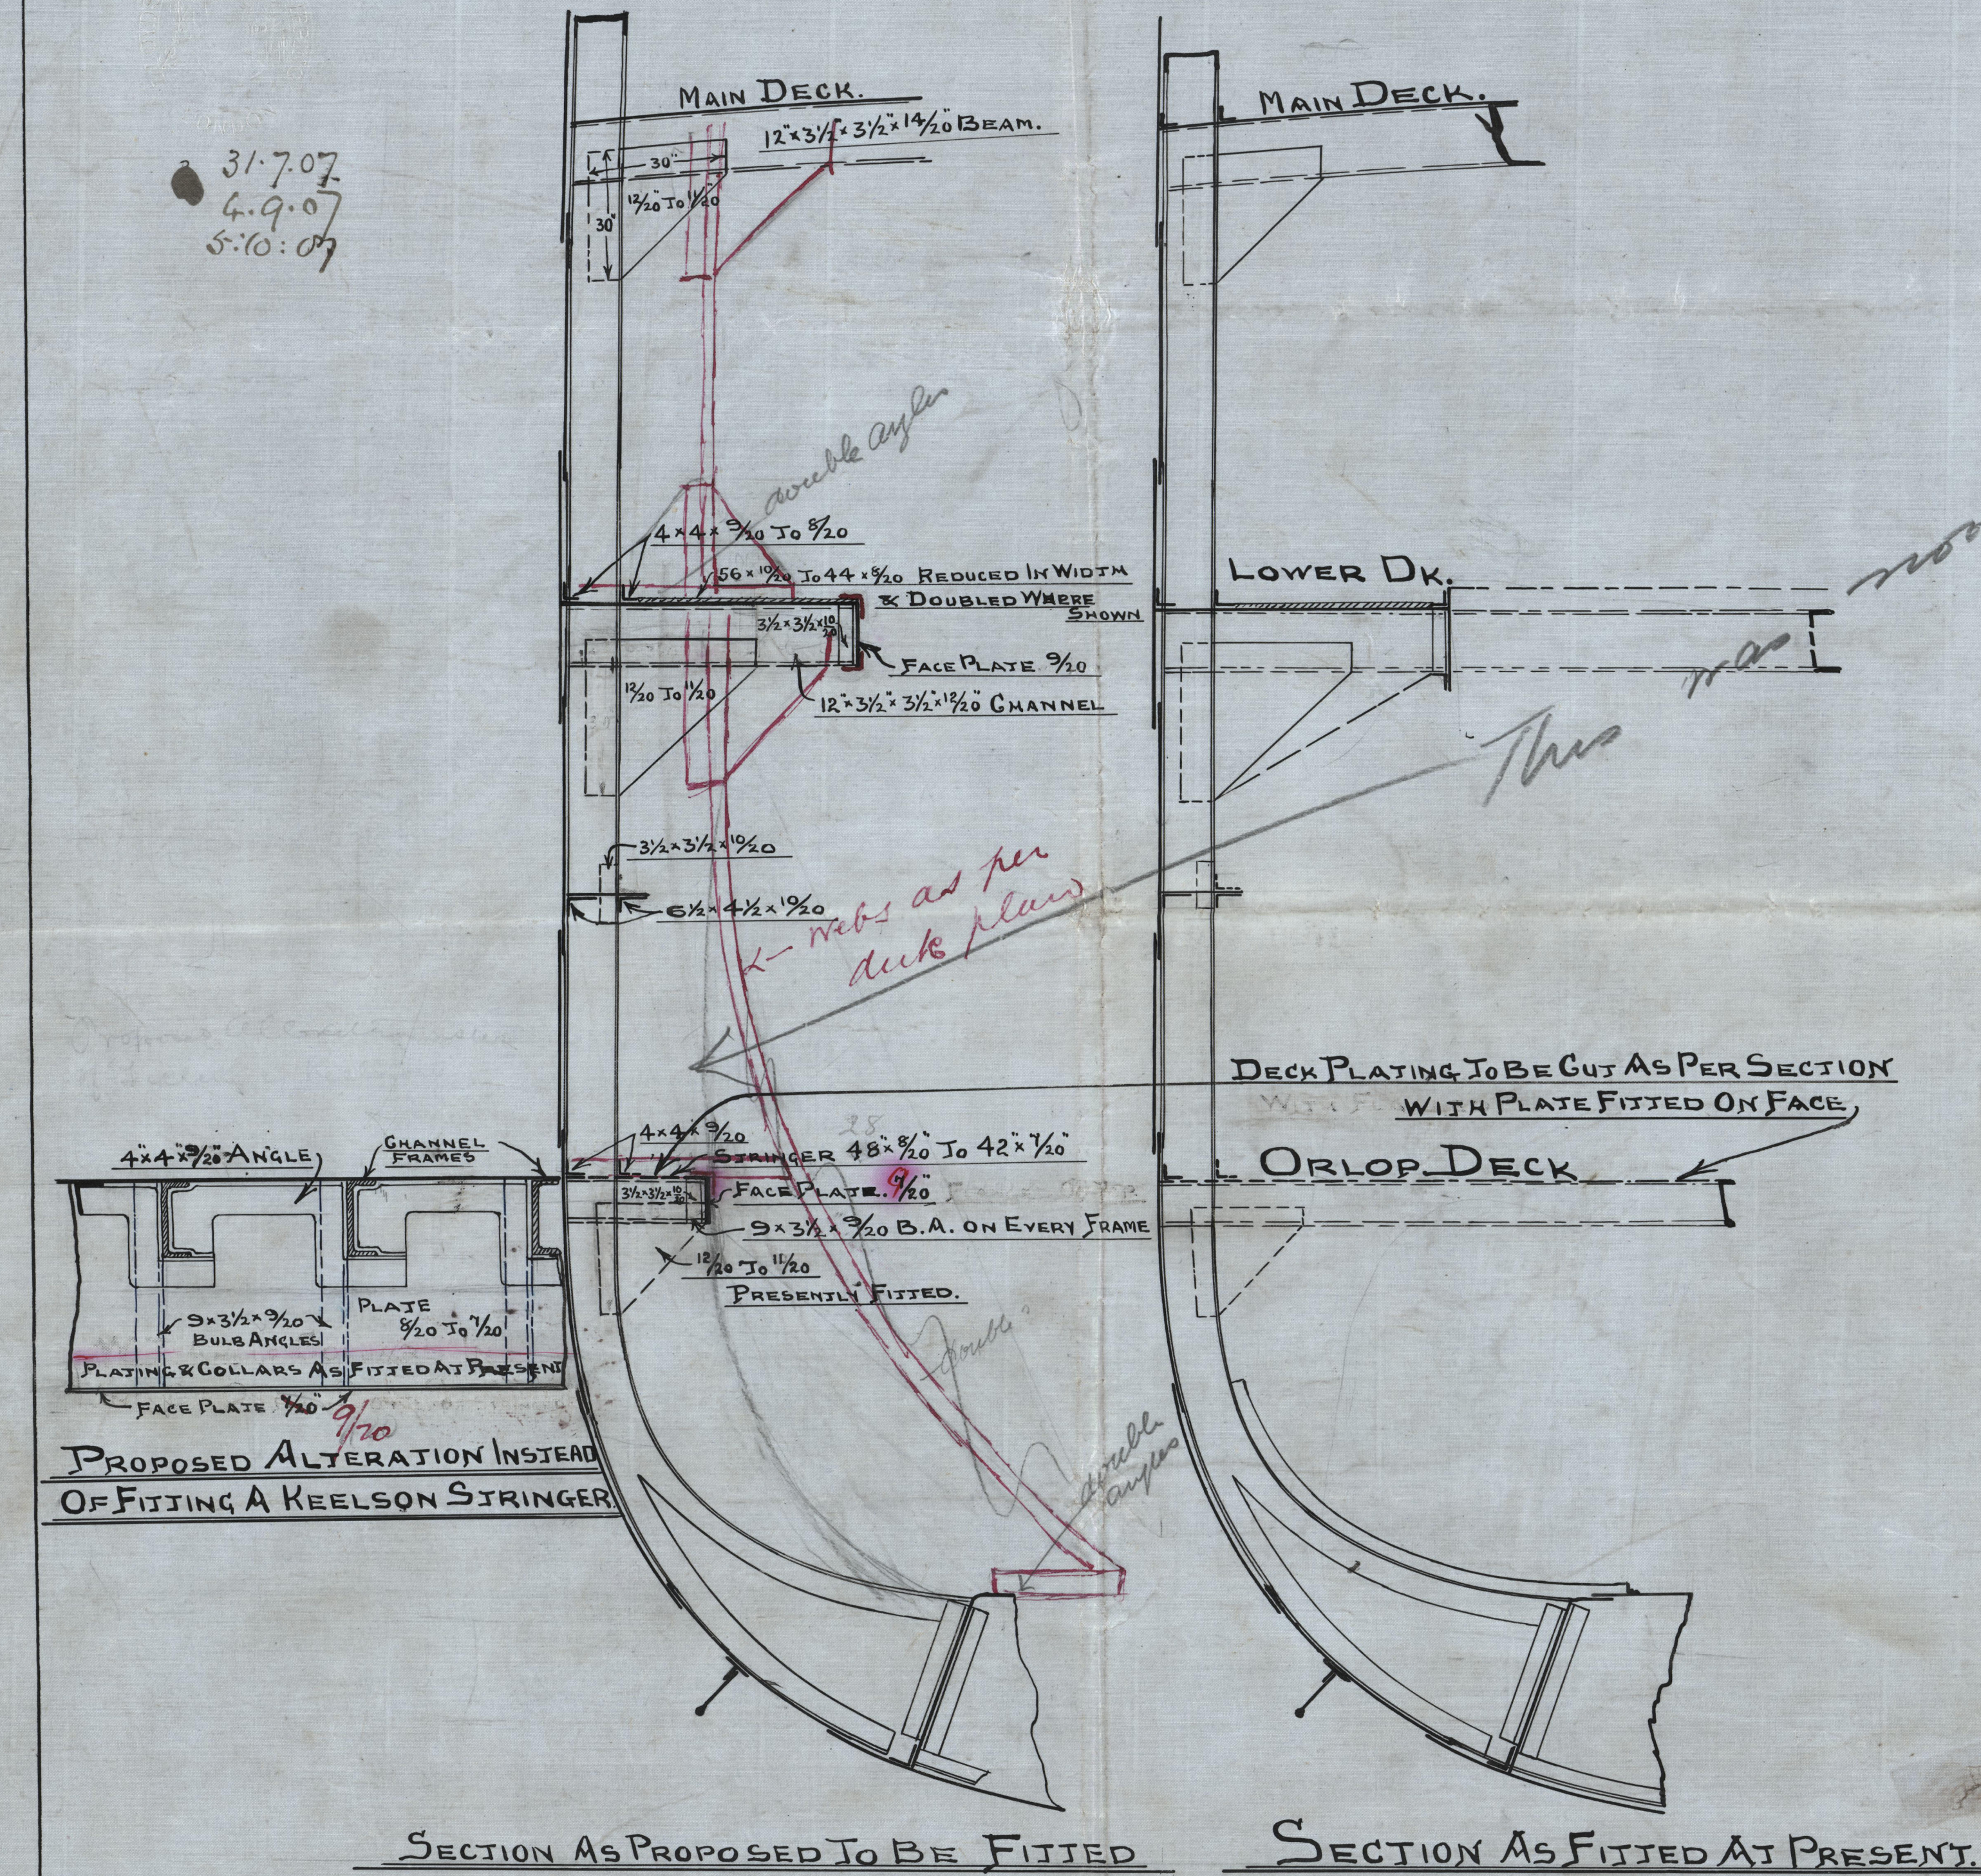


27/7/07.
T.S.S. Anglia

Proposed alterations

Greenock *41* No. 15291

GRK355-0117

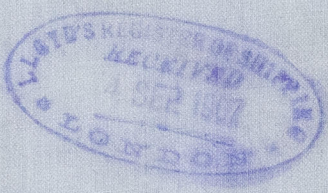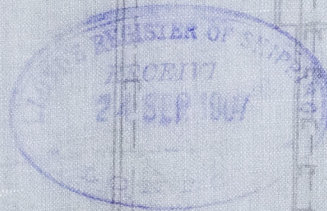

© 2020
Lloyd's Register
Foundation