

PRIVATE GRAVING DOCK 275 FEET LONG.

17th Oct 1901

GRANGEMOUTH AND GREENOCK DOCKYARD CO.,

THE GREENOCK & GRANGEMOUTH DOCKYARD COY., LTD.
GREENOCK, N.B.

This Enclosure is to be Sent to

Ships No.

T.S.S. "Itonus"

Tracing No.

364

Lloyd's Register
Greenock

GRK355-0119 (1/2)




*Cargo Port Doors.
Greenock Grangemouth & Co. Ltd.
T.A.S. Morris ex Anglia*

Greenock *Plt No 15291*



GRK355-0119(2/2)

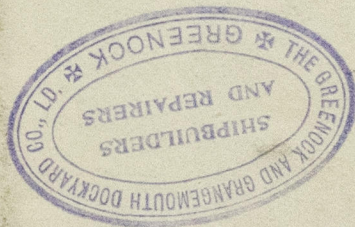


9/10/07 R.S.
 LONDON

ISS 'IONUS' CARGO PORT. DOOR


SCALE 1" = 1 FOOT.

14.10.07

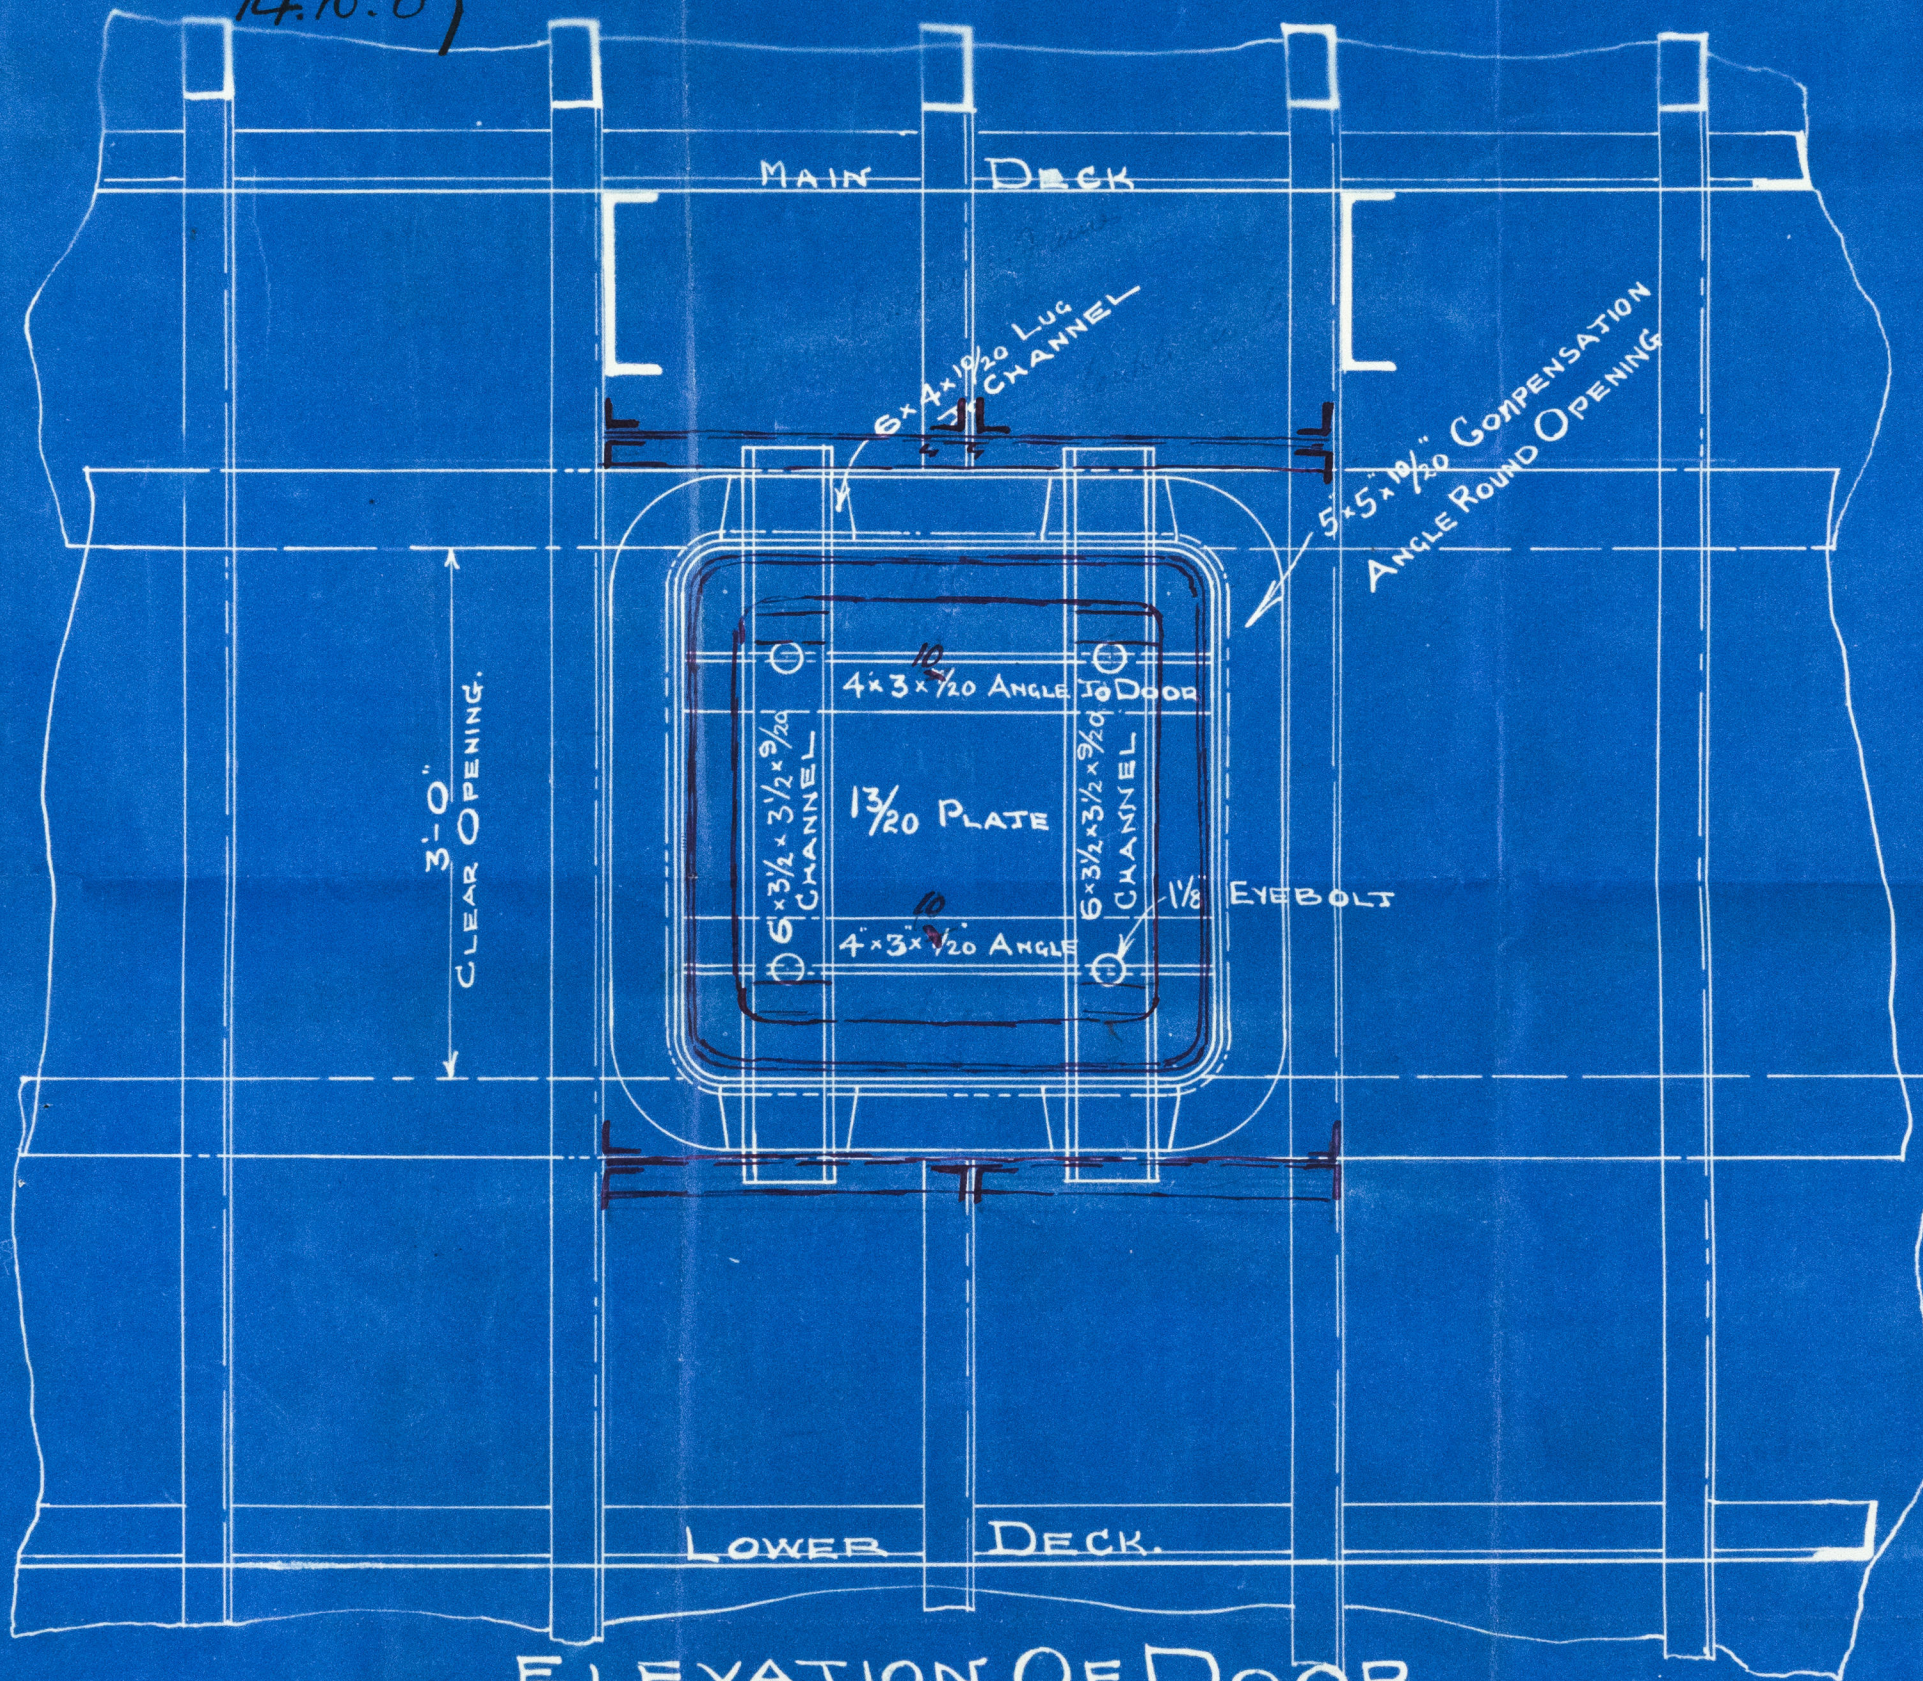

ELEVATION OF DOOR.

Made watertight to Surveyors satisfaction.

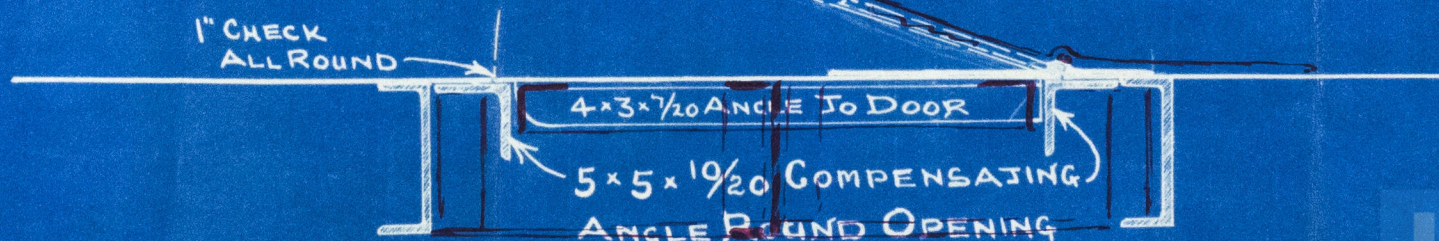

PLAN OF DOOR.

Ch.
 14.10.07.

R

Ships Register
 Foundation