

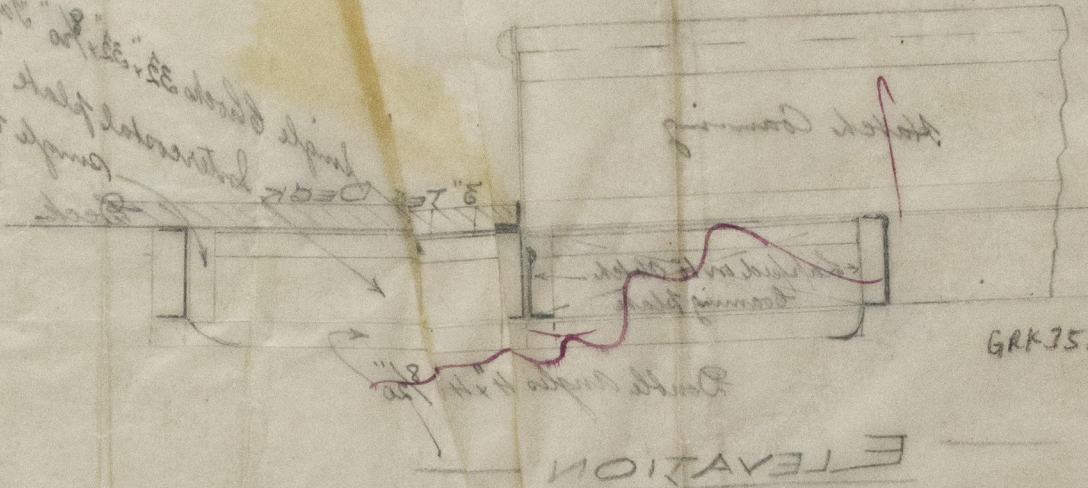






Amended Plan
 No 3 Hatch double
 M. Anglia

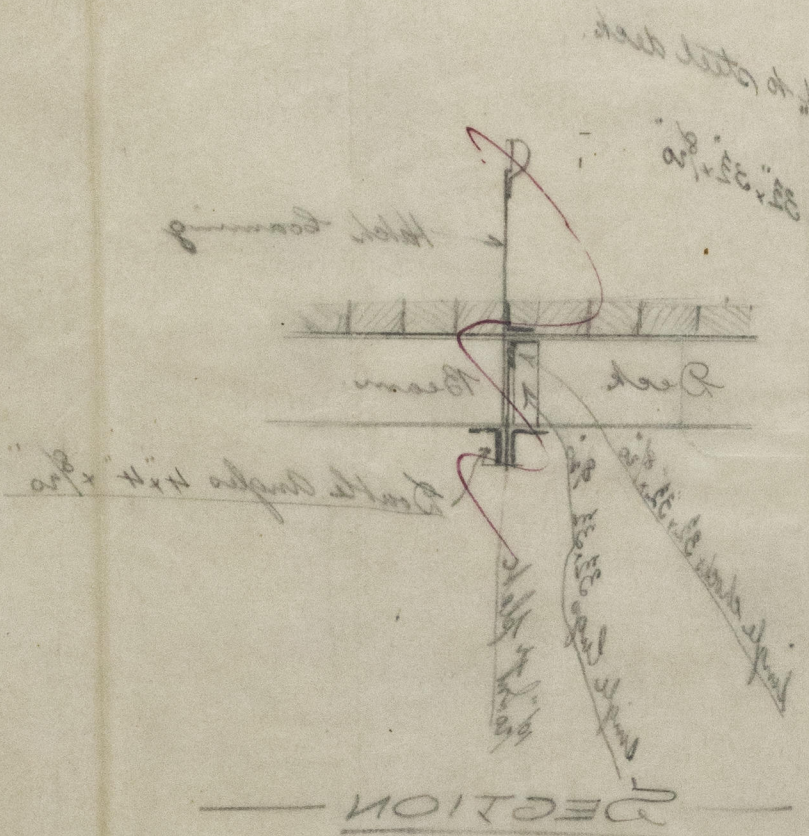

GRK 355-0123

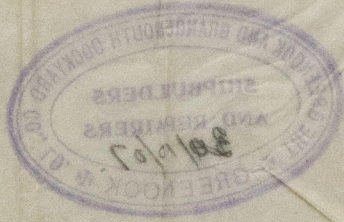


Amended Plan
 No 3 Hatch double
 M. Anglia

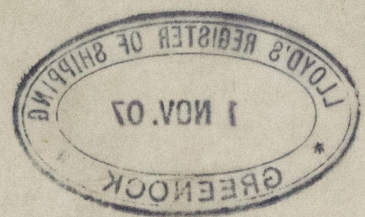
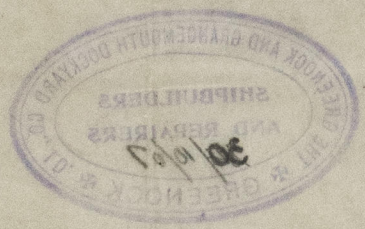
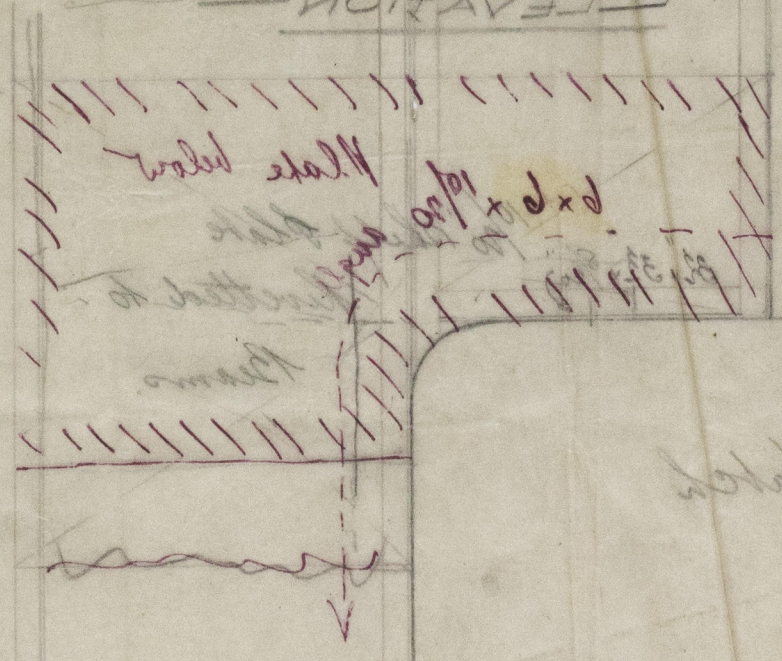
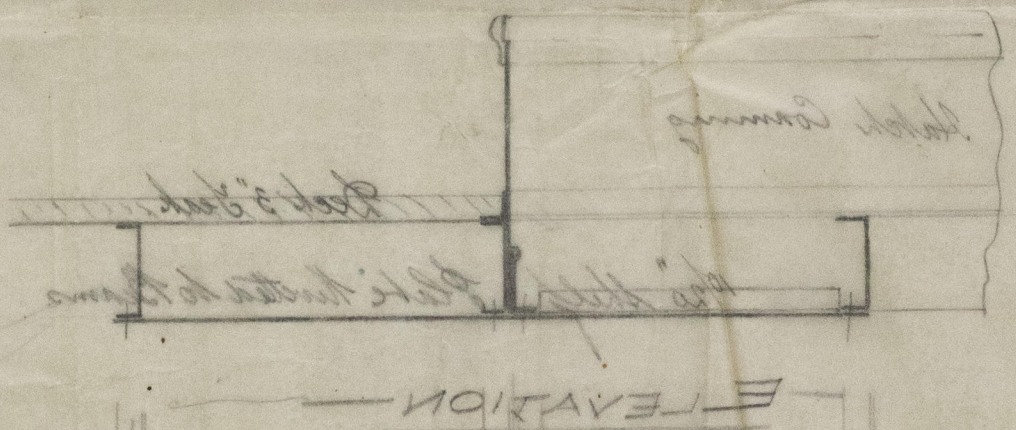




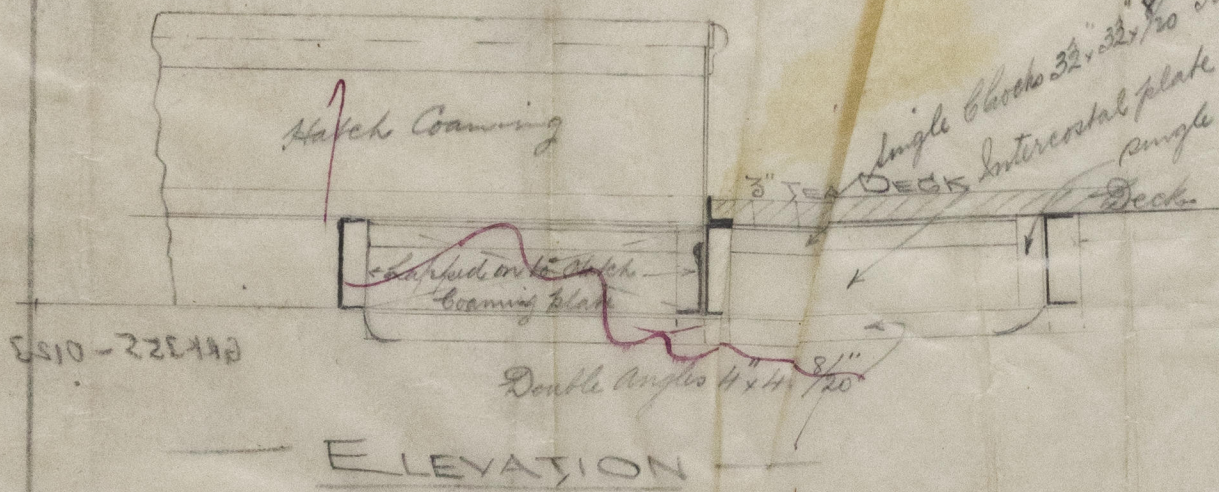


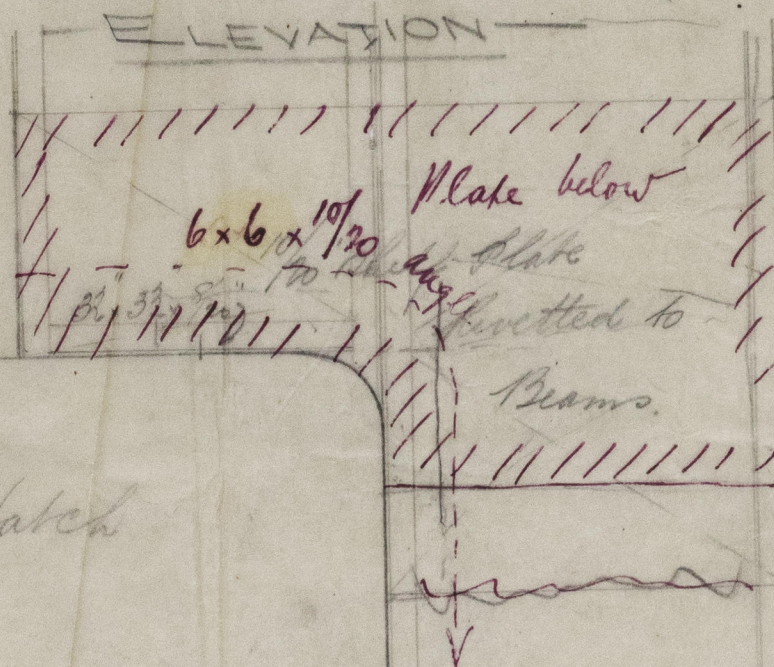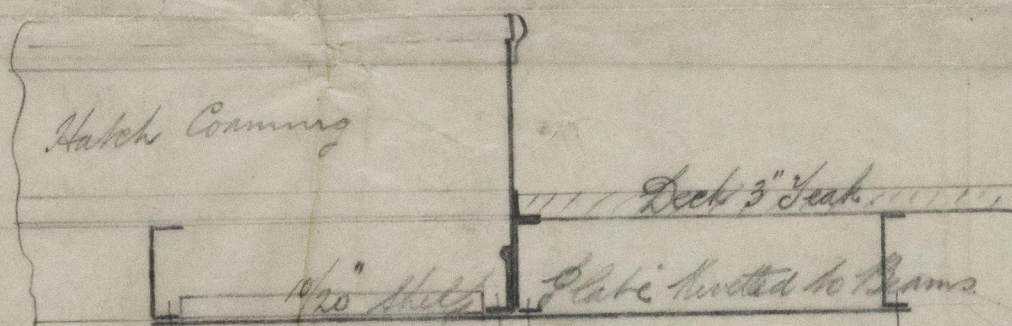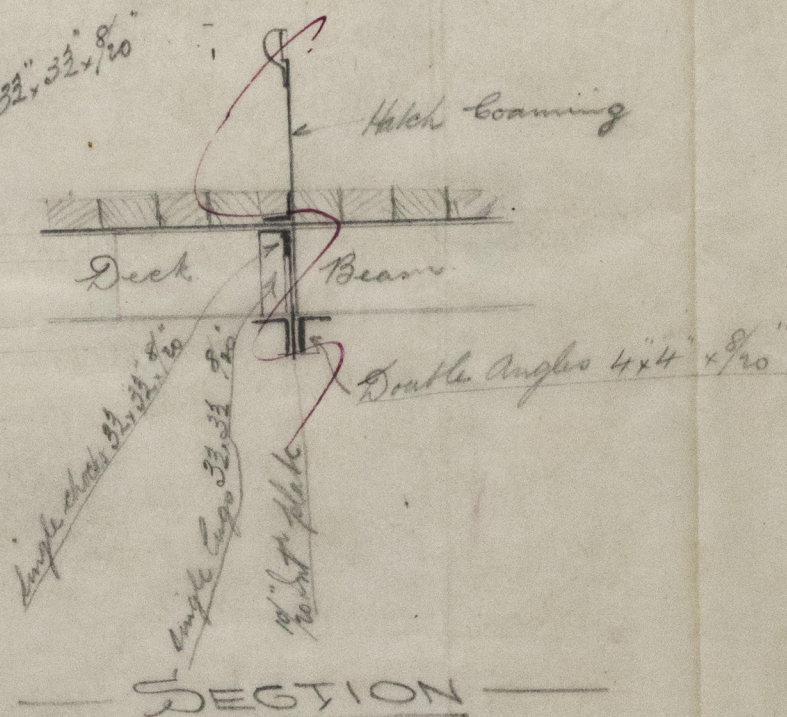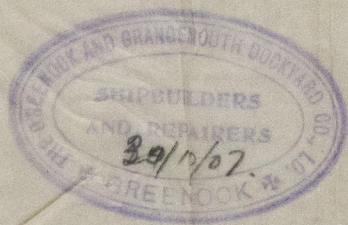



RAN

J. S. S. Jones

Proposed Arrangements in Lieu

of Deck Draining at Hatch Corner to Upper Deck

Scale 3" = One foot

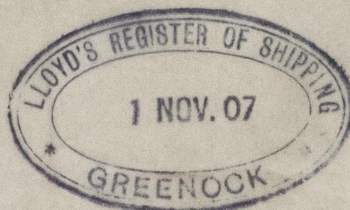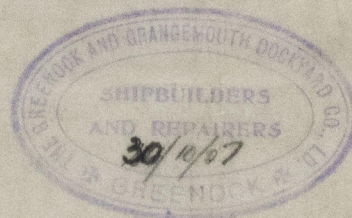

© 2020

Lloyd's Register Foundation

GRK355-0123