

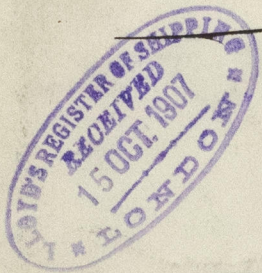
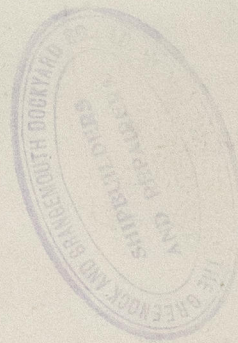
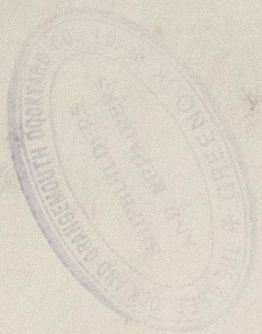
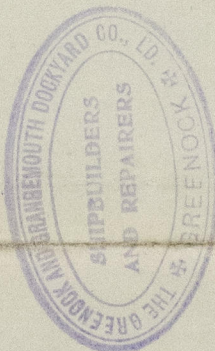


Amended. Plan Cattle Doors.
Greenock & Bruth dy 6 to
4.1.1. "Horus" ex "Anglia"

Greenock rfr. No 15291

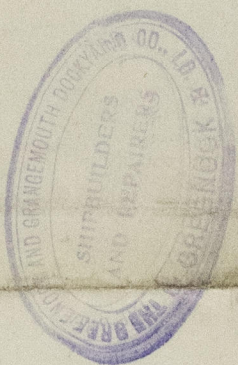


GR2355-0126

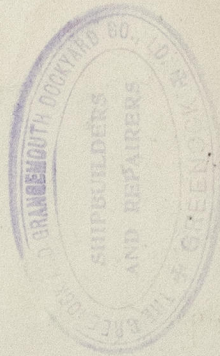

© 2019

Lloyd's Register
Foundation

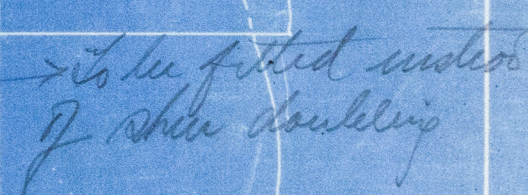

SCALE 1" = 1 FOOT

