


Recd 28-9-75
L.R.

Proposed to work a
thick gasboard

This proposition not
carried out

Upper part of
rice

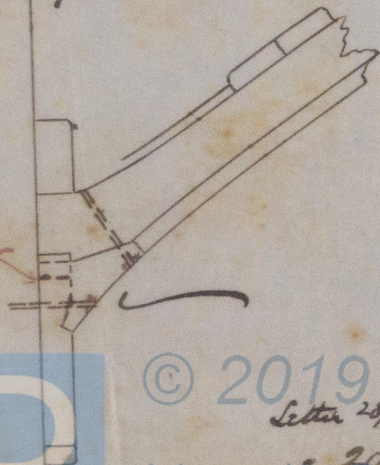

© 2019

Letter 28/5/75

24-9-75

Lloyd's Register
Foundation

HAM 1116-0029